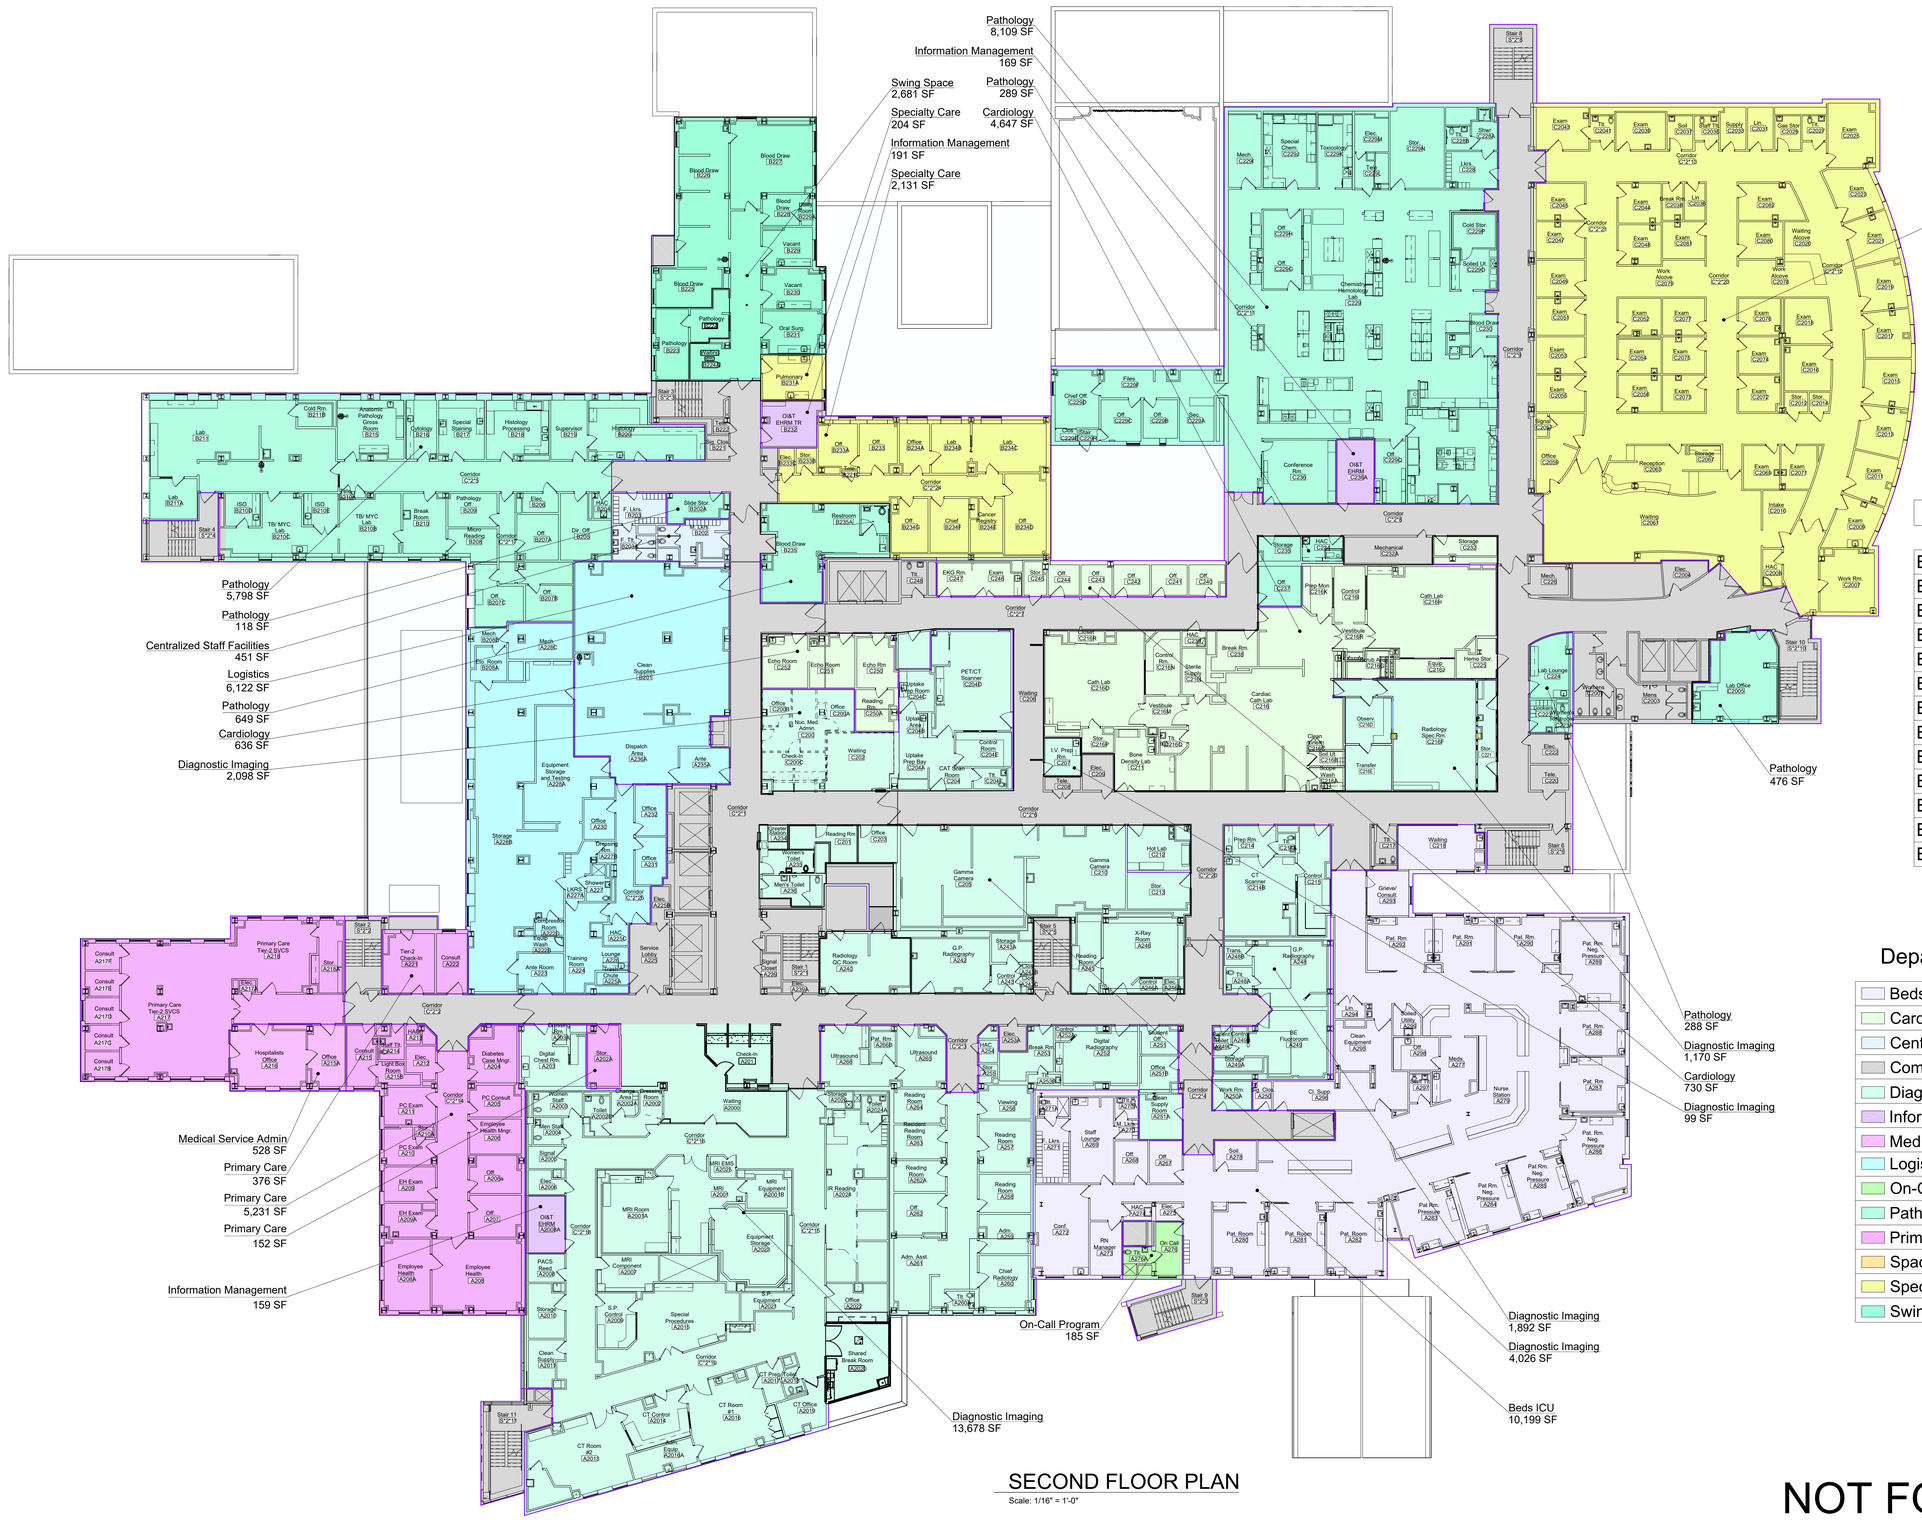


SECOND FLOOR PLAN

Scale: 1/16" = 1'-0"

CAI Gross Building Area

B01-PIPE BASEMENT	8,350 SF
B01-BASEMENT	96,117 SF
B01-FIRST FLOOR	115,764 SF
B01-SECOND FLOOR	103,057 SF
B01-THIRD FLOOR	95,509 SF
B01-FOURTH FLOOR	44,523 SF
B01-FIFTH FLOOR	40,418 SF
B01-SIXTH FLOOR	36,859 SF
B01-SEVENTH FLOOR	30,813 SF
B01-EIGHTH FLOOR	25,908 SF
B01-NINTH FLOOR	18,835 SF
B01-PENTHHOUSE	4,612 SF
B01-MECHANICAL	3,020 SF
	623,814 SF

Department Area Legend

Beds ICU	10,199 SF
Cardiology	6,013 SF
Centralized Staff Facilities	451 SF
Common Space/Lobby Space	19,305 SF
Diagnostic Imaging	21,889 SF
Information Management	519 SF
Medical Service Admin	528 SF
Logistics	6,122 SF
On-Call Program	185 SF
Pathology	14,488 SF
Primary Care	5,765 SF
Space Under Construction	669 SF
Specialty Care	13,887 SF
Swing Space	3,037 SF
	103,057 SF

NOT FOR CONSTRUCTION

Office of Construction and Facilities Management

VA U.S. Department of Veterans Affairs

Drawing Title: SECOND FLOOR PLAN	Phase: CAI RECORD DRAWING & SPACE ASSIGNMENTS	Project Title: UPDATE FACILITY BIM	Size: ARCH E1
			Building Number: 01
Approved: CHIEF OF ENGINEERING ZACH SCHMIDT	ADDRESS: CINCINNATI VAMC 3200 VINE ST. CINCINNATI, OH 45220	Location: CINCINNATI, OHIO (539)	Drawing Number: 01-CAI.102
		Issue Date: 8/29/2025 / Checked: / Drawn: LH	

VA FORM 08 - 6231