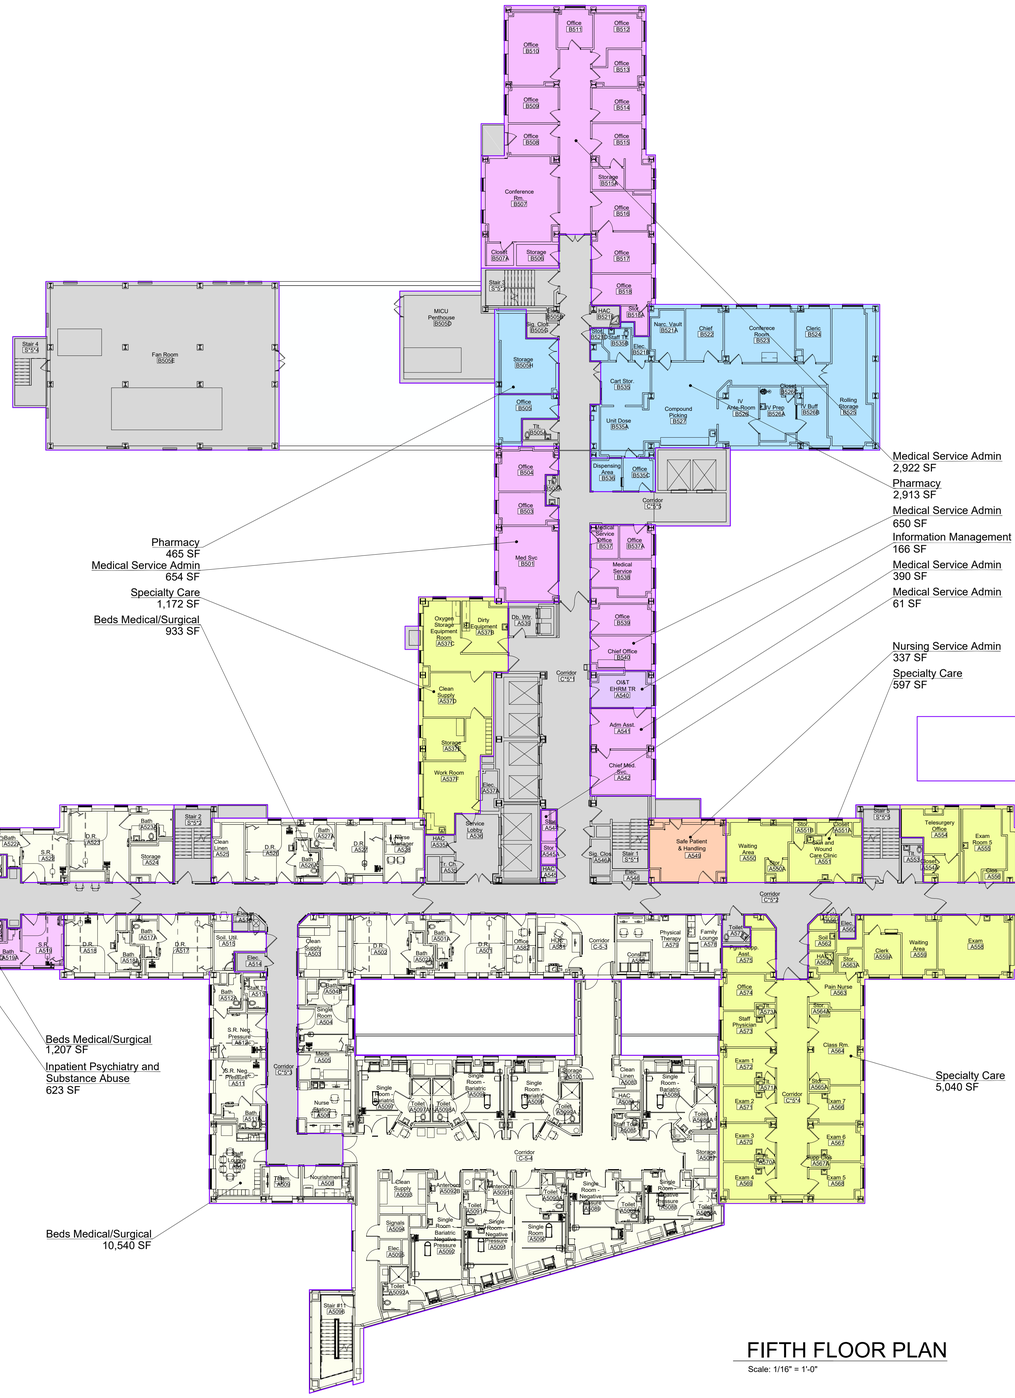


FIFTH FLOOR PLAN

Scale: 1/16" = 1'-0"

CAI Gross Building Area

B01-PIPE BASEMENT	8,350 SF
B01-BASEMENT	96,117 SF
B01-FIRST FLOOR	115,764 SF
B01-SECOND FLOOR	103,086 SF
B01-THIRD FLOOR	95,509 SF
B01-FOURTH FLOOR	44,523 SF
B01-FIFTH FLOOR	40,343 SF
B01-SIXTH FLOOR	36,859 SF
B01-SEVENTH FLOOR	30,813 SF
B01-EIGHTH FLOOR	25,908 SF
B01-NINTH FLOOR	18,835 SF
B01-PENTHHOUSE	4,612 SF
B01-MECHANICAL	3,020 SF
	623,814 SF

Department Area Legend

Beds Medical/Surgical	12,680 SF
Common Space/Lobby Space	11,674 SF
Information Management	166 SF
Inpatient Psychiatry and Substance Abuse	623 SF
Medical Service Admin	4,677 SF
Nursing Service Admin	337 SF
Pharmacy	3,378 SF
Specialty Care	6,808 SF
	40,343 SF

NOT FOR CONSTRUCTION

Office of Construction and Facilities Management

VA U.S. Department of Veterans Affairs

Drawing Title: FIFTH FLOOR PLAN	Phase: CAI RECORD DRAWING & SPACE ASSIGNMENTS	Project Title: UPDATE FACILITY BIM	Size: ARCH E1
			Building Number: 01
Approved: CHIEF OF ENGINEERING ZACH SCHMIDT	ADDRESS: CINCINNATI VAMC 3200 VINE ST. CINCINNATI, OH 45220	Location: CINCINNATI, OHIO (539)	Drawing Number: 01-CAI.105
		Issue Date: 8/29/2025 / Checked: / Drawn: LH	