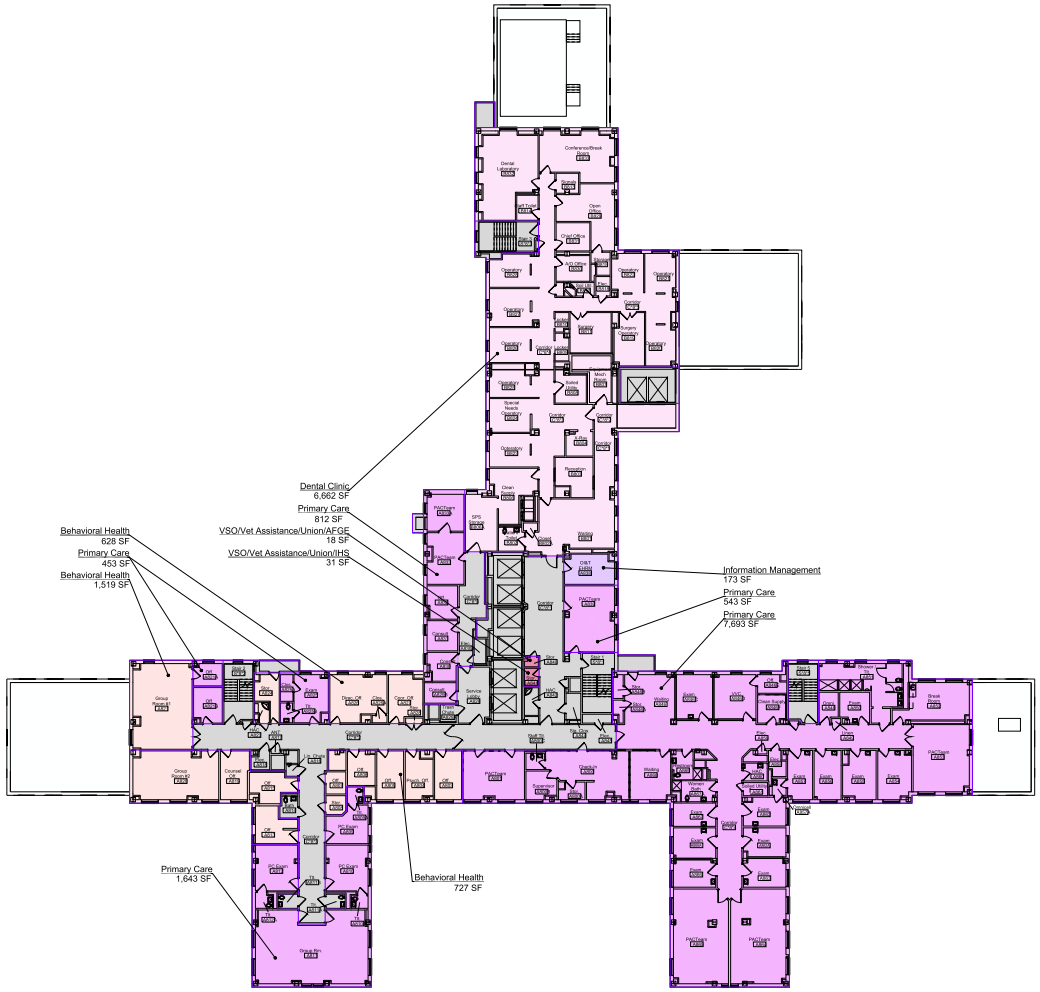


EIGHTH FLOOR PLAN

Scale: 1/16" = 1'-0"

CAI Gross Building Area	
B01-PIPE BASEMENT	8,350 SF
B01-BASEMENT	96,117 SF
B01-FIRST FLOOR	115,764 SF
B01-SECOND FLOOR	103,086 SF
B01-THIRD FLOOR	95,509 SF
B01-FOURTH FLOOR	44,523 SF
B01-FIFTH FLOOR	40,418 SF
B01-SIXTH FLOOR	36,859 SF
B01-SEVENTH FLOOR	30,813 SF
B01-EIGHTH FLOOR	25,908 SF
B01-NINTH FLOOR	18,835 SF
B01-PENTHHOUSE	4,612 SF
B01-MECHANICAL	3,020 SF
	623,814 SF

Department Area Legend

Behavioral Health	2,874 SF
Common Space/Lobby Space	5,006 SF
Dental	6,662 SF
Information Management	173 SF
Primary Care	11,144 SF
VSO/Vet Assistance/Union	49 SF
	25,908 SF

NOT FOR CONSTRUCTION

Office of Construction and Facilities Management

U.S. Department of Veterans Affairs

Drawing Title: EIGHTH FLOOR PLAN	Phase: CAI RECORD DRAWING & SPACE ASSIGNMENTS	Project Title: UPDATE FACILITY BIM	Size: ARCH E1
			Building Number: 01
Approved: CHIEF OF ENGINEERING ZACH SCHMIDT	ADDRESS: CINCINNATI VAMC 3200 VINE ST. CINCINNATI, OH 45220	Location: CINCINNATI, OHIO (539)	Drawing Number: 01-CAI.108
		Issue Date: 8/29/2025 / Checked: / Drawn: LH	

VA FORM 08 - 6231