INDIAN HEALTH SERVICES

ALBUQUERQUE INDIAN HOSPITAL

801 VASSAR DRIVE N.E. ALBUQUERQUE, NM 87106

1ST & 3RD FLOOR INTERIOR RENOVATIONS

PROJECT SCOPE STATEMENT:

FIRST FLOOR. The project scope of work is a design build to approximately 1,500 square feet of space that includes renovation of (4) clinical rooms, convert the janitor's closet and mail room to a toilet room and office, relocate and replace one heat pump unit, and replace floor finishes and the east entrance door(s).

THIRD FLOOR. The project scope of work is a design build to approximately 1,400 square feet of space that includes renovation of Third Floor Nurse's Station, reconfigure Exam Room 310 to include new Storage Closet, demo Rooms 310A, 311A and 312 to create a new office, reconfigure Toilet Room 318B and provide a new A.D.A. Restroom and Janitor's Closet. Remove and provide new electric water cooler at a new location. Floor finishes, acoustical ceiling tiles, canned lighting, new casework, abatement, electrical, mechanical and plumbing support are also included in the statement of work.

ISSUE DATE: **JULY 1, 2021**

PHASE: AS-BUILTS

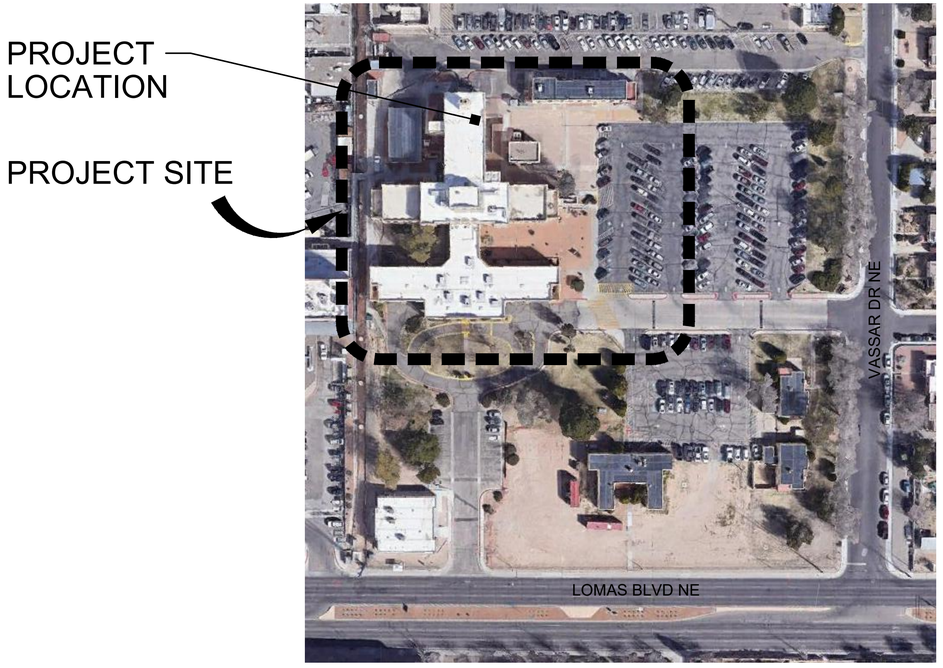

LOCATION PLAN
NOT TO SCALE

INDEX OF DRAWINGS

GENERAL

SEQUENCE	SHEET NUMBER	LEVEL	SHEET TITLE
001	G-1		COVER SHEET

STRUCTURAL

SEQUENCE	SHEET NUMBER	LEVEL	SHEET TITLE
002	S-1	3RD FLOOR	STRUCTURAL PARTIAL FRAMING PLAN & DETAILS

ARCHITECTURAL

SEQUENCE	SHEET NUMBER	LEVEL	SHEET TITLE
003	A-1	1ST FLOOR	DEMOLITION & NEW FLOOR PLAN
004	A-2	1ST FLOOR	DEMOLITION & NEW REFLECTED CEILING PLAN
005	A-3	1ST FLOOR	ENLARGED FLOOR PLAN & INTERIOR ELEVATIONS
006	A-4	3RD FLOOR	DEMOLITION & NEW FLOOR PLAN
007	A-5	3RD FLOOR	DEMOLITION & NEW REFLECTED CEILING PLAN
008	A-6	3RD FLOOR	ENLARGED FLOOR PLAN & INTERIOR ELEVATIONS

MECHANICAL

SEQUENCE	SHEET NUMBER	LEVEL	SHEET TITLE
009	M-1	1ST FLOOR	DEMOLITION & NEW WORK PLANS
010	M-2	3RD FLOOR	DEMOLITION & NEW WORK PLANS
011	M-3	1ST FLOOR	PIPING DEMOLITION & NEW WORK PLANS
012	M-4	-	MECHANICAL EQUIPMENT SCHEDULES & MISCELLANEOUS DETAILS
013	P-0	-	SYMBOL, LEGEND AND GENERAL PROJECT NOTES
014	P-1	1ST FLOOR	WATER DEMO & NEW WORK PLANS
015	P-2	1ST FLOOR	WASTE & VENT DEMO & NEW WORK PLANS
016	P-3	3RD FLOOR	PLUMBING DEMOLITION PLANS
017	P-4	3RD FLOOR	PLUMBING NEW WORK PLANS
018	P-5	-	PLUMBING FIXTURE SCHEDULE & DETAILS

ELECTRICAL

SEQUENCE	SHEET NUMBER	LEVEL	SHEET TITLE
019	E-1	1ST FLOOR	POWER - DEMO & NEW WORK PLAN
020	E-2	1ST FLOOR	LIGHTING - DEMO & NEW WORK PLAN
021	E-3	3RD FLOOR	POWER - DEMO & NEW WORK PLAN
022	E-4	3RD FLOOR	LIGHTING - DEMO & NEW WORK PLAN
023	E-5	-	ELECTRICAL PANEL SCHEDULE

FIRE ALARM

SEQUENCE	SHEET NUMBER	LEVEL	SHEET TITLE
024-027	FA-1	1ST FLOOR	FIRE ALARM PLAN - CLINIC RENOVATIONS
028-031	FA-2	3RD FLOOR	FIRE ALARM PLAN - NURSE'S STATION

PROJECT TEAM

INDIAN HEALTH SERVICE, ABQ
4101 INDIAN SCHOOL ROAD NE
ALBUQUERQUE, NM 87110
(505) 256-6799
SANDRA BITSIE, PROJECT MANAGER
SANDRA.BITSIE@IHS.GOV

GRANCOR
2121 MENAUL BLVD NE
ALBUQUERQUE, NM 87107
(505) 872-0005
JOE DIBERNARDO
JOED@QAENGINEERING.COM

CHAVEZ-GRIEVES
4700 LINCOLN ROAD NE SUITE 102
ALBUQUERQUE, NM 87109
(505) 344-4080
GEORGE H. BRADLEY, P.E.
GBRADLEY@CG-ENGRS.COM

QA ENGINEERING, LLC
1409 ORTIZ DRIVE SE
ALBUQUERQUE, NM 87109
(505) 338-7092
JON ANTHONY, P.E.
JON@QAENGINEERING.COM

HUITT-ZOLLARS, INC.
6501 AMERICAS PARKWAY NE #830
ALBUQUERQUE, NM 87109
(505) 883-8114
JOSE ZELAYA, AIA
JZELAYA@HUITT-ZOLLARS.COM

SOUND & SIGNAL SYSTEMS OF NEW MEXICO
7131 WASHINGTON STREET NE
ALBUQUERQUE, NM 87109
(505) 883-1217
TED ARAGON
TARAGON@SOUNDANDSIGNALNM.COM

Mark	Description	Date	Appr
0	AS-BUILTS	7-01-21	

File Name:
Plot Scale: As indicated
Plot Date:
Go Accidents are Tolerance

DESIGN BY:
DRAWN BY:
REVIEWED BY:

INDIAN HEALTH SERVICES
ALBUQUERQUE, NEW MEXICO

HUITT-ZOLLARS
QA ENGINEERING
GranCor CONSTRUCTION EXCELLENCE

INDIAN HEALTH SERVICES
AIHC 1ST AND 3RD FLOOR INTERIOR RENOVATIONS

COVER SHEET

SHEET NO.
G-1

SEQUENCE NO.
SHEET 1 OF 31

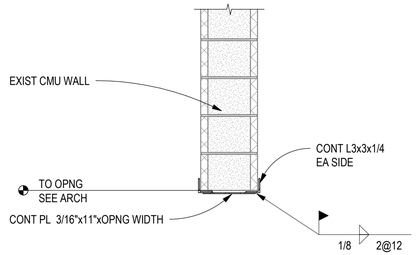

C3 NEW LINTEL AT EXIST CMU WALL

SCALE: 3/4" = 1'-0"

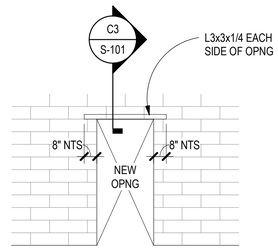

CONSTRUCTION SEQUENCE NOTES

1 ROUTE OUT MORTAR JOINT ON ONE SIDE OF WALL TO HALF WALL DEPTH. INSERT FIRST ANGLE
2 ROUTE OUT REMAINING MORTAR JOINT ON OPPOSITE SIDE OF WALL. INSERT SECOND ANGLE.
3 SAWCUT CMU AT JAMBS OF OPENING AND REMOVE.
4 ATTACH CLOSURE PLATE

B3 NEW LINTEL @ EXIST CMU

SCALE: 3/4" = 1'-0"

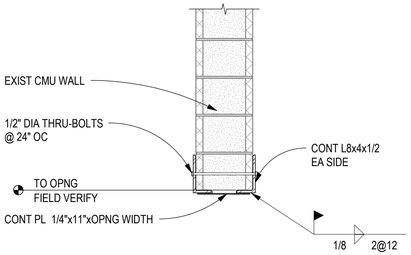

B2 NEW LINTEL AT EXIST CMU WALL

SCALE: 3/4" = 1'-0"

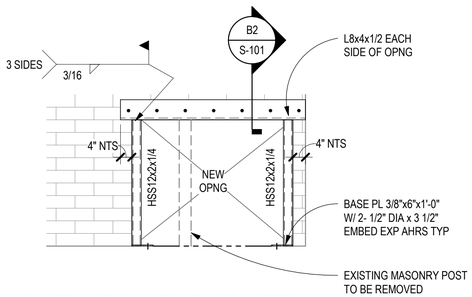

CONSTRUCTION SEQUENCE NOTES

1. SHORE EXISTING FLOOR STRUCTURE ABOVE
2. INSTALL NEW TUBE STEEL POSTS AT JAMBS
3. ROUTE OUT MORTAR JOINT ONE SIDE OF WALL WHERE REQUIRED. INSERT FIRST ANGLE
4. ROUTE OUT REMAINING MORTAR JOINT ON OPPOSITE SIDE OF WALL. INSERT SECOND ANGLE
5. INSTALL THRU BOLTS
6. WELD POSTS TO ANGLES
7. REMOVE MASONRY POST
8. ATTACH CLOSURE PLATE
9. REMOVE SHORING

A2 NEW LINTEL @ EXIST CMU

SCALE: 3/4" = 1'-0"

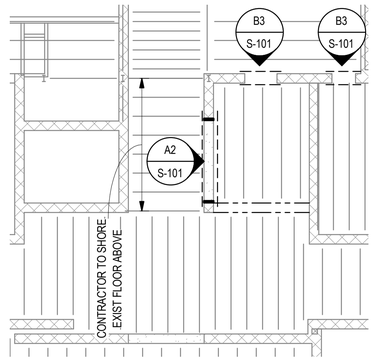

A3 3RD FLOOR FRAMING PLAN

SCALE: 1/8" = 1'-0"

GENERAL STRUCTURAL NOTES

CODES AND MANUALS:

IBC-15 INTERNATIONAL BUILDING CODE 2015
ASCE/SEI 7-10 MINIMUM DESIGN LOADS FOR BUILDINGS AND OTHER STRUCTURES
AISC MANUAL OF STEEL CONSTRUCTION 14TH EDITION
AWS D1.1-04 STRUCTURAL WELDING CODE – STEEL

DESIGN CRITERIA:

VERTICAL:

LIVE LOAD	
FLOOR	80 PSF
ADDITIONAL SUPERIMPOSED LOADS	
PARTITIONS	15 PSF
SUSPENDED EQUIPMENT	5 PSF
CONCENTRATED LOAD (PER IBC 1607.4)	2000 LBS

GENERAL:

STRUCTURAL DRAWINGS ARE NOT STAND-ALONE DOCUMENTS AND ARE INTENDED TO BE USED IN CONJUNCTION WITH CIVIL, ARCHITECTURAL, MECHANICAL, ELECTRICAL, AND DRAWINGS FROM OTHER DISCIPLINES. THE CONTRACTOR SHALL COORDINATE ALL REQUIREMENTS OF THE CONTRACT DOCUMENTS INTO THE SHOP DRAWINGS AND FIELD WORK.

COORDINATE DIMENSIONS OF ALL OPENINGS, DEPRESSIONS, BLOCKOUTS, ETC. WITH ARCHITECTURAL DRAWINGS, DRAWINGS FROM OTHER DISCIPLINES, PROJECT SHOP DRAWINGS, AND FIELD CONDITIONS PRIOR TO SHOP DRAWING SUBMITTAL. THE STRUCTURAL DRAWINGS ONLY REPRESENT A PORTION OF THE REQUIREMENTS FOR THE PROJECT.

THE CONTRACTOR SHALL VERIFY ALL DIMENSIONS IN THE FIELD.

SHOP DRAWINGS SHALL BE FURNISHED AND REVIEWED BEFORE ANY FABRICATION OR ERECTION IS STARTED. THE CONTRACTOR SHALL REVIEW AND APPROVE SHOP DRAWINGS PRIOR TO SUBMITTAL TO THE ARCHITECT FOR REVIEW. POORLY EXECUTED SHOP DRAWINGS WILL BE REJECTED AND SHALL BE RESUBMITTED.

THE CONTRACTOR SHALL BE RESPONSIBLE FOR PROVIDING SAFE AND ADEQUATE SHORING FOR ALL PARTS OF THE STRUCTURE DURING CONSTRUCTION.

TEMPORARY PROVISIONS SHALL BE MADE FOR STRUCTURAL STABILITY DURING CONSTRUCTION. THE STRUCTURE SHOWN ON THE DRAWINGS HAS BEEN DESIGNED FOR STABILITY UNDER FINAL CONFIGURATION.

NOTCHING OR CUTTING ANY STRUCTURAL MEMBER IN THE FIELD IS PROHIBITED.

THE CONTRACTOR SHALL BE RESPONSIBLE FOR ADHERING TO ALL APPLICABLE STANDARDS SET FORTH BY OSHA.

DO NOT SCALE DRAWINGS.

POST INSTALLED ANCHORS:

ALL POST INSTALLED MECHANICAL ANCHORS INTO CONCRETE SHALL BE HILTI KWIK BOLT TZ EXPANSION ANCHOR OR EQUAL.
STRUCTURAL AND MISCELLANEOUS STEEL:

ALL STRUCTURAL STEEL SHALL BE DETAILED AND FABRICATED IN ACCORDANCE WITH THE AISC "SPECIFICATION FOR STRUCTURAL STEEL BUILDINGS".

ALL MISCELLANEOUS STEEL MEMBERS, SUCH AS CHANNELS, ANGLES, FLAT BARS, AND PLATES SHALL CONFORM TO ASTM A36 UNLESS NOTED OTHERWISE.

ALL RECTANGULAR AND SQUARE STRUCTURAL TUBING SHALL CONFORM TO ASTM A500, GRADE B, FY = 46 KSI OR ASTM 1085, GRADE B, FY = 50 KSI.

ALL WELDING SHALL BE DONE IN ACCORDANCE WITH THE LATEST STANDARDS OF THE AWS STRUCTURAL WELDING CODE.

Chavez-Grieves consulting engineers, inc.
4700 LINCOLN RD NE STE 102 • ALBUQUERQUE, NM 87109
PHONE (505) 344-4080 • FAX (505) 343-8759

Mark	Description	Date	Appr.
0	AS-BUILTS	7-01-21	
0	ISSUE FOR CONSTRUCTION	7-22-20	

File Name:
Plot Scale: As indicated
Plot Date: 7/15/2020
Zero Accidents Zero Tolerance

DESIGN BY: G BRADLEY
DRAWN BY: B ZACK
REVIEWED BY: G BRADLEY

INDIAN HEALTH SERVICES
ALBUQUERQUE, NEW MEXICO

HUITT-ZOLLARS
GranCor CONSTRUCTION EXCELLENCE

INDIAN HEALTH SERVICES
AIHC 1ST AND 3RD FLOOR INTERIOR RENOVATIONS
3RD FLOOR NURSES
STATION STRUCTURAL PLANS

SHEET NO.
S-1

SEQUENCE NO.
SHEET 2 OF 31

File Name: C:\Revit Projects\Q07-115 AIHC 3RD FLOOR NURSES STATION_bzack.rvt
Tech: Author
Date/Time: 7/14/2020 8:23:16 AM

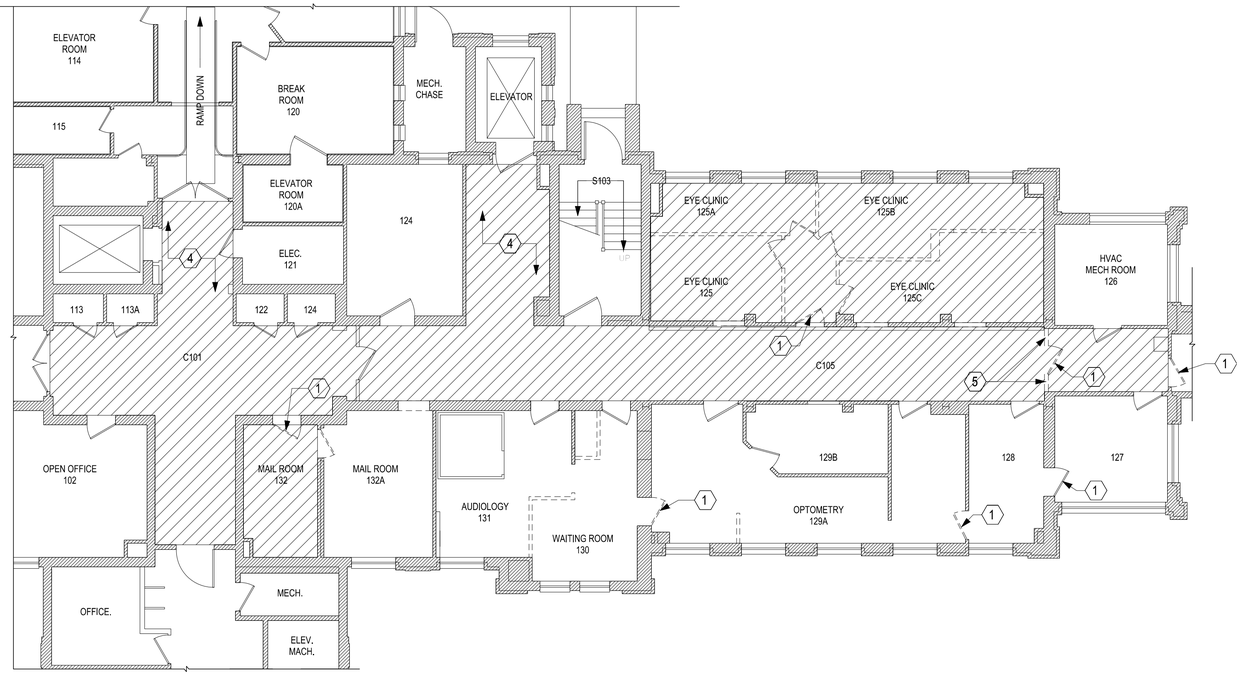

C1 DEMOLITION FLOOR PLAN

1/8" = 1'-0"

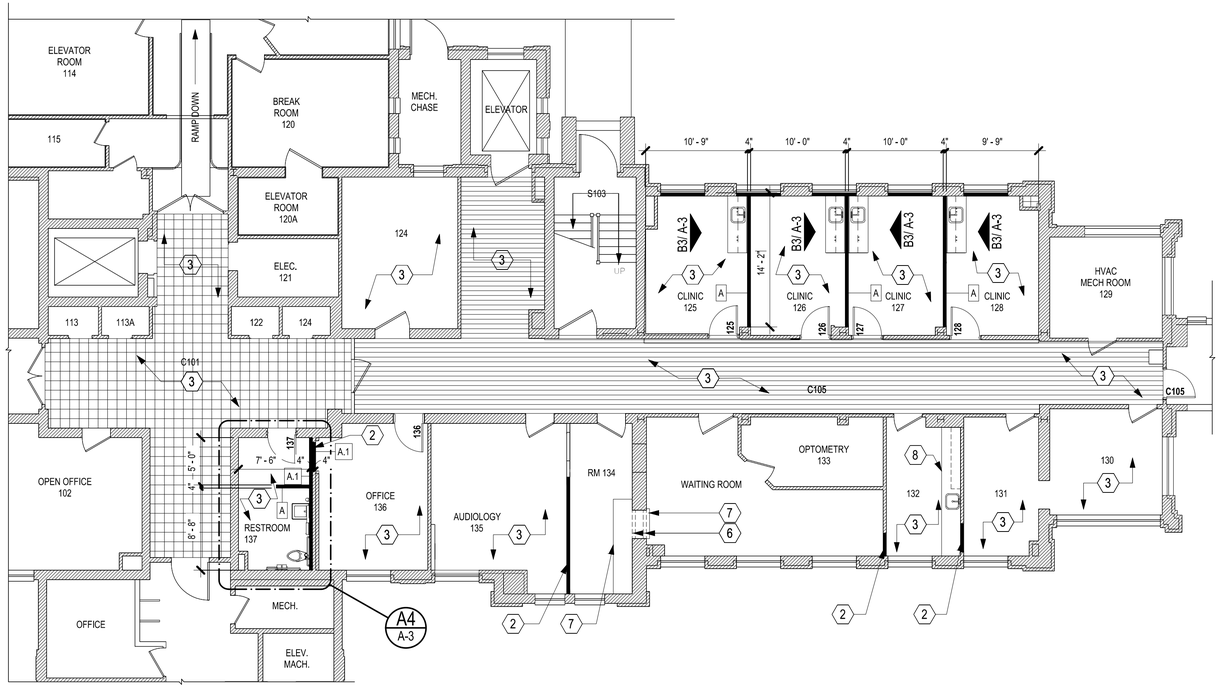

A1 NEW FLOOR PLAN

1/8" = 1'-0"

GENERAL NOTES

A. EXISTING CONDITIONS SHOWN ON DRAWINGS ARE BASED ON ARCHITECT'S FIELD OBSERVATION AND OWNER PROVIDED RECORD DOCUMENTS ONLY. CONTRACTOR IS RESPONSIBLE TO VERIFY EXISTING CONDITIONS IN FIELD FOR ACCURACY AND NOTIFY ARCHITECT IN WRITING OF ANY DISCREPANCIES PRIOR TO PROCEEDING WITH THE WORK.

B. CONTRACTOR TO COORDINATE WITH THE OWNER FOR THE SALVAGE, REMOVAL AND REINSTALLATION OF EQUIPMENT.

C. ALL DIMENSIONS ARE TO FACE OF STUD OR MASONRY UNLESS NOTED OTHERWISE.

D. PROVIDE TRANSITION STRIPS AT ALL FLOOR FINISH TRANSITIONS.

E. PATCH, REPAIR AND MATCH ADJACENT FINISH AND COLOR AT NEW OPENINGS AND DEMO AREAS.

F. ASBESTOS REMOVAL WORK IS PART OF THE SCOPE OF WORK. THE CONTRACTOR SHALL VERIFY WITH THE OWNER THE LOCATION OF THE KNOWN ASBESTOS CONTAINING MATERIALS (A.C.M. BY DEFINITION OF THE A.H.E.R.A.) IN THE CONSTRUCTION AREA. IF THERE IS ANY QUESTION ABOUT THE POSSIBILITY OF OTHER ASBESTOS CONTAINING MATERIALS, SAMPLES OF THE MATERIAL IN QUESTION SHALL BE OBTAINED BY A QUALIFIED PARTY AND SENT TO A LABORATORY FOR ANALYSIS. IF ANY ASBESTOS IS PRESENT, IT SHALL BE DEALT WITH IN A MANNER CONFORMING TO THE APPLICABLE FEDERAL REGULATIONS. DO NOT SEND WORKMEN IN ANY AREA WHERE THERE IS A RISK OF A.C.M. IF, DURING THE CONSTRUCTION PROCESS, MATERIAL IS ENCOUNTERED THAT MAY CONTAIN ASBESTOS, CEASE WORK IN THE VICINITY OF THE POSSIBLE ASBESTOS AND IMMEDIATELY NOTIFY THE OWNER.

KEYED NOTES

1 REMOVE; EXISTING DOOR AND FRAME
2 METAL STUD WALL. PATCH AND FINISH TO MATCH EXISTING CONSTRUCTION
3 NEW FLOOR FINISH. SEE ROOM FINISH SCHEDULE
4 REMOVE; EXISTING FLOORING. REFER TO ACM REPORT, TEST AND ABATE WHEN NEEDED. PREPARE FOR NEW FLOOR FINISH
5 REMOVE; EXISTING WALL IN ITS ENTIRETY. SEE GENERAL NOTES ABOVE.
6 WALL BELOW
7 COUNTERTOP
8 CASEWORK

DOOR SCHEDULE

NUMBER	DOOR WIDTH	DOOR HEIGHT	DOOR MATL	FRAME MATL	COMMENTS
125	3' - 0"	7' - 0"	WD	HM	
126	3' - 0"	7' - 0"	WD	HM	
127	3' - 0"	7' - 0"	WD	HM	
128	3' - 0"	7' - 0"	WD	HM	
136	3' - 0"	7' - 0"	WD	HM	
137	3' - 0"	7' - 0"	WD	HM	
C105	3' - 0"	7' - 0"	HM	HM	

ROOM FINISH SCHEDULE

ROOM NO	ROOM NAME	FLOOR FIN.
124		VINYL COMPOSITION TILE
125	CLINIC	VINYL COMPOSITION TILE
126	CLINIC	VINYL COMPOSITION TILE
127	CLINIC	VINYL COMPOSITION TILE
128	CLINIC	VINYL COMPOSITION TILE
130		VINYL COMPOSITION TILE
131		VINYL COMPOSITION TILE
132	STERILIZATION	VINYL COMPOSITION TILE
133	OPTOMETRY / WAITING ROOM	VINYL COMPOSITION TILE
134		VINYL COMPOSITION TILE
135	AUDIOLOGY	VINYL COMPOSITION TILE
136	OFFICE	VINYL COMPOSITION TILE
137	RESTROOM	VINYL COMPOSITION TILE
C101	CORRIDOR	CERAMIC TILE
C105	CORRIDOR	VINYL COMPOSITION TILE

WALL TYPES

A
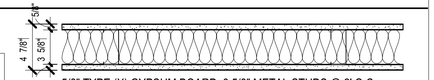

5/8" TYPE (X) GYPSUM BOARD, 3 5/8" METAL STUDS @ 2' O.C. WITH 4" BATT INSULATION, CONSTRUCT WALLS UP TO UNDERSIDE OF DECK.

A.1
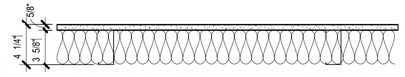

5/8" TYPE (X) GYPSUM BOARD, 3 5/8" METAL STUDS @ 2' O.C. WITH 4" BATT INSULATION, CONSTRUCT WALLS UP TO UNDERSIDE OF DECK.

LEGEND

EXISTING WALL TO REMAIN
EXISTING WALL TO BE REMOVED
NEW WALL
EXISTING DOOR TO REMAIN
EXISTING DOOR TO BE REMOVED
NEW DOOR
REMOVE FLOOR FINISH

CONFORMED DRAWINGS

THIS CONFORMED DRAWING AS BEEN PREPARED, IN PART, BASED UPON INFORMATION FURNISHED BY OTHERS. WHILE THIS INFORMATION IS BELIEVED TO BE RELIABLE, THE ARCHITECT ASSUMES NO RESPONSIBILITY FOR THE ACCURACY OF THIS CONFORMED DRAWING OR FOR ANY ERRORS OR OMISSIONS THAT MAY HAVE BEEN INCORPORATED INTO IT AS A RESULT OF INCORRECT INFORMATION PROVIDED TO THE ARCHITECT. THOSE RELYING ON THIS CONFORMED DRAWING ARE ADVISED TO OBTAIN INDEPENDENT VERIFICATION OF ITS ACCURACY.

INDIAN HEALTH SERVICE · PHS · 1955

Mark	Description	Date	Appr.
0	AS-BUILTS	7-01-21	

File Name: Plot Scale: Plot Date:

zero Accidents zero Tolerance

DESIGN BY: DRAWN BY: REVIEWED BY:

INDIAN HEALTH SERVICES
ALBUQUERQUE, NEW MEXICO

HUITT-ZOLLARS
GramCor Construction Excellence
QA Engineering

INDIAN HEALTH SERVICES
AIHC 1ST AND 3RD FLOOR INTERIOR RENOVATIONS

1ST FLOOR - DEMOLITION & NEW FLOOR PLAN

SHEET NO.
A-1

SEQUENCE NO.
SHEET 3 OF 31

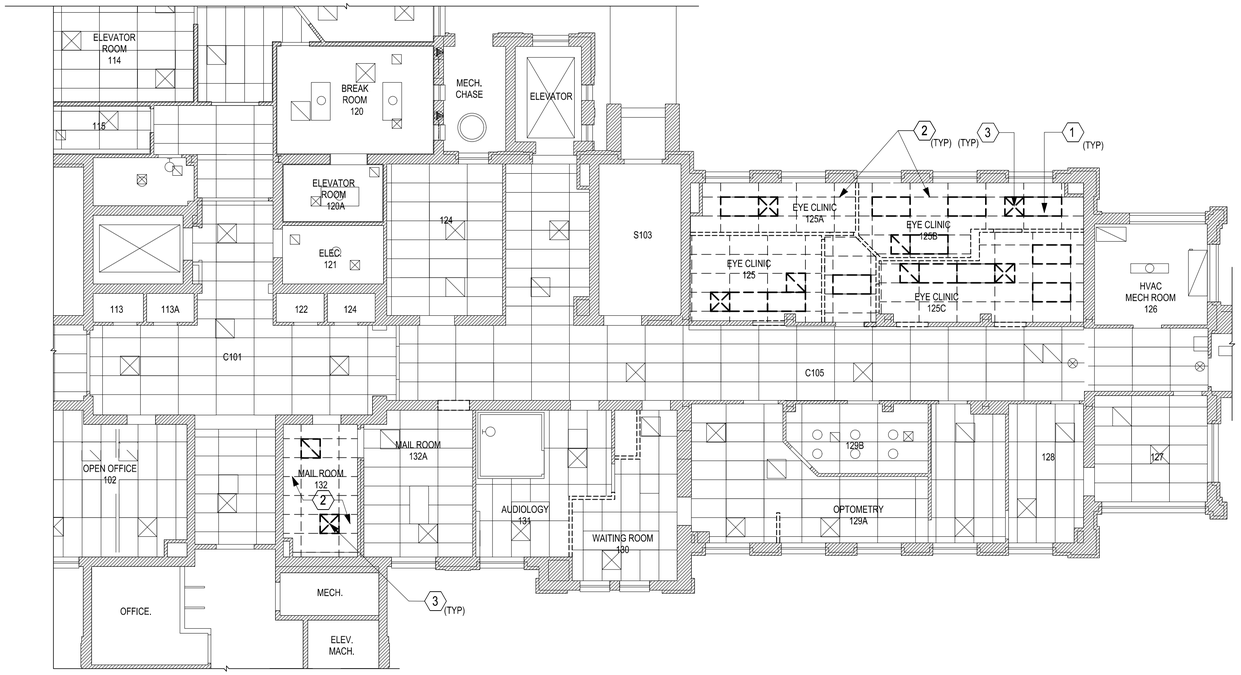

C1 DEMOLITION REFLECTED CEILING PLAN

1/8" = 1'-0"

N

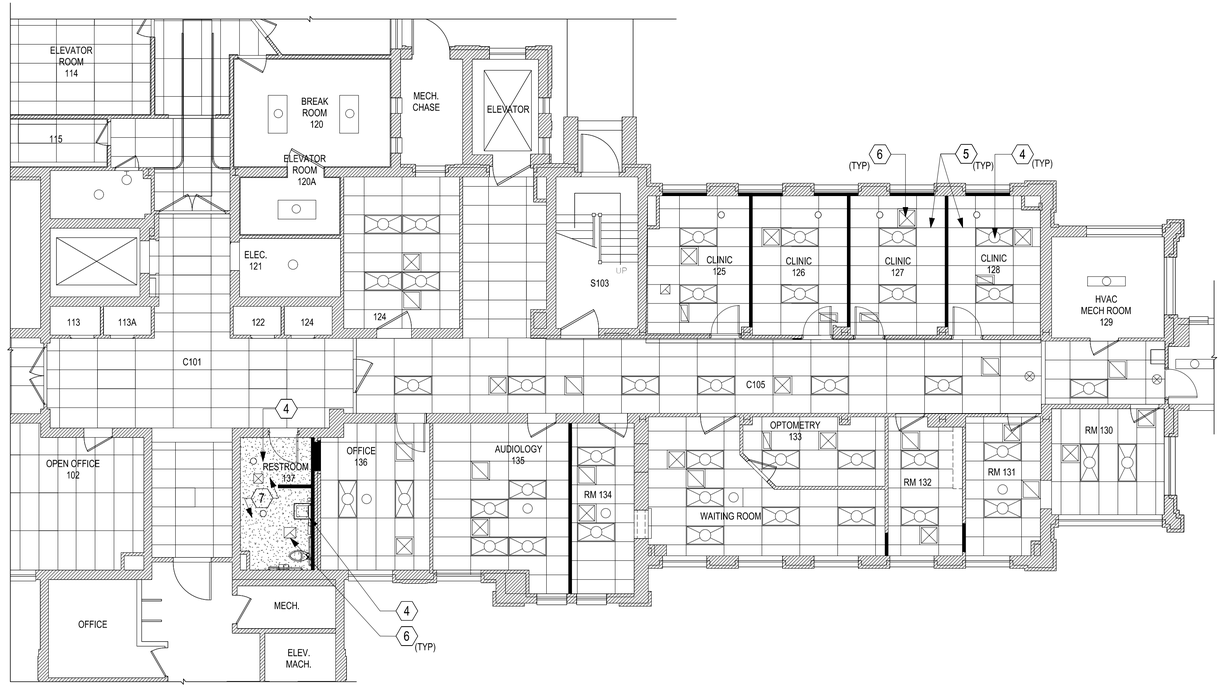

A1 NEW REFLECTED CEILING PLAN

1/8" = 1'-0"

N

GENERAL NOTES

A. EXISTING CONDITIONS SHOWN ON DRAWINGS ARE BASED ON ARCHITECT'S FIELD OBSERVATION AND OWNER PROVIDED RECORD DOCUMENTS ONLY. CONTRACTOR IS RESPONSIBLE TO VERIFY EXISTING CONDITIONS IN FIELD FOR ACCURACY AND NOTIFY ARCHITECT IN WRITING OF ANY DISCREPANCIES PRIOR TO PROCEEDING WITH THE WORK.

B. CONTRACTOR TO COORDINATE WITH THE OWNER FOR THE SALVAGE, REMOVAL AND REINSTALLATION OF EQUIPMENT.

C. ALL DIMENSIONS ARE TO FACE OF STUD OR MASONRY UNLESS NOTED OTHERWISE.

D. PROVIDE TRANSITION STRIPS AT ALL FLOOR FINISH TRANSITIONS.

E. PATCH, REPAIR AND MATCH ADJACENT FINISH AND COLOR AT NEW OPENINGS AND DEMO AREAS.

F. ASBESTOS REMOVAL WORK IS PART OF THE SCOPE OF WORK. THE CONTRACTOR SHALL VERIFY WITH THE OWNER THE LOCATION OF THE KNOWN ASBESTOS CONTAINING MATERIALS (A.C.M. BY DEFINITION OF THE A.H.E.R.A.) IN THE CONSTRUCTION AREA. IF THERE IS ANY QUESTION ABOUT THE POSSIBILITY OF OTHER ASBESTOS CONTAINING MATERIALS, SAMPLES OF THE MATERIAL IN QUESTION SHALL BE OBTAINED BY A QUALIFIED PARTY AND SENT TO A LABORATORY FOR ANALYSIS. IF ANY ASBESTOS IS PRESENT, IT SHALL BE DEALT WITH IN A MANNER CONFORMING TO THE APPLICABLE FEDERAL REGULATIONS. DO NOT SEND WORKMEN IN ANY AREA WHERE THERE IS A RISK OF A.C.M. IF, DURING THE CONSTRUCTION PROCESS, MATERIAL IS ENCOUNTERED THAT MAY CONTAIN ASBESTOS, CEASE WORK IN THE VICINITY OF THE POSSIBLE ASBESTOS AND IMMEDIATELY NOTIFY THE OWNER.

KEYED NOTES

1 REMOVE; EXISTING LIGHT FIXTURE. SEE ELECTRICAL
2 REMOVE; EXISTING LAY-IN CEILING
3 REMOVE; EXISTING MECHANICAL DIFFUSER. SEE MECHANICAL
4 LIGHT FIXTURE. SEE ELECTRICAL
5 INSTALL 2X4 LAY-IN CEILING. CEILING TO MATCH EXISTING HEIGHT
6 MECHANICAL DIFFUSER. SEE MECHANICAL
7 INSTALL GYP BOARD CEILING. CEILING TO MATCH EXISTING HEIGHT

LEGEND

- 2x4 ACOUSTIC LAY-IN CEILING
- GYP. BOARD CEILING - 1/2" TYPE "X"
- CEILING-MOUNTED SUPPLY
- CEILING-MOUNTED RETURN
- 2'x4' LIGHT FIXTURE - CEILING
- STRIP LIGHT FIXTURE - WALL
- RECESSED DOWNLIGHT FIXTURE

CONFORMED DRAWINGS

THIS CONFORMED DRAWING AS BEEN PREPARED, IN PART, BASED UPON INFORMATION FURNISHED BY OTHERS. WHILE THIS INFORMATION IS BELIEVED TO BE RELIABLE, THE ARCHITECT ASSUMES NO RESPONSIBILITY FOR THE ACCURACY OF THIS CONFORMED DRAWING OR FOR ANY ERRORS OR OMISSIONS THAT MAY HAVE BEEN INCORPORATED INTO IT AS A RESULT OF INCORRECT INFORMATION PROVIDED TO THE ARCHITECT. THOSE RELYING ON THIS CONFORMED DRAWING ARE ADVISED TO OBTAIN INDEPENDENT VERIFICATION OF ITS ACCURACY.

INDIAN HEALTH SERVICE · IHS · 1955

Mark	Description	Date	Appr.
0	AS-BUILTS	7-01-21	

File Name:
Plot Scale:
Plot Date:
zero Accidents
zero Tolerance

DESIGN BY:
DRAWN BY:
REVIEWED BY:

INDIAN HEALTH SERVICES
ALBUQUERQUE, NEW MEXICO

HUITT-ZOLLARS
GranCor CONSTRUCTION EXCELLENCE
QA EXCELLENCE

INDIAN HEALTH SERVICES
AIHC 1ST AND 3RD FLOOR INTERIOR RENOVATIONS

1ST FLOOR - DEMOLITION & NEW REFLECTED CEILING PLAN

SHEET NO.
A-2

SEQUENCE NO.
SHEET 4 OF 31

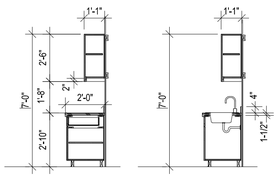

C2 CASEWORK SECTION

1/4" = 1'-0"

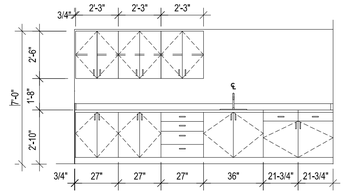

C3 CASEWORK ELEVATION

1/4" = 1'-0"

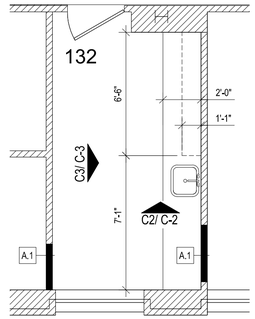

C4 RM 132 - ENLARGED PLAN

1/4" = 1'-0"

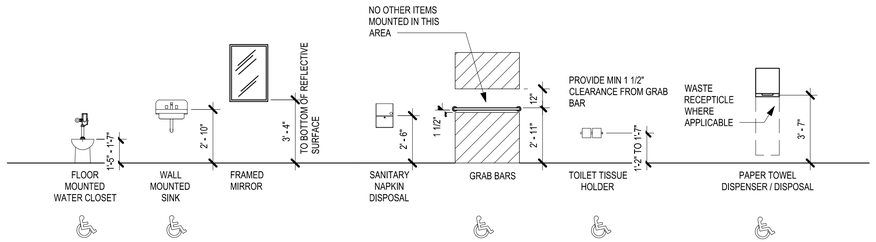

MOUNTING HEIGHTS - FIXTURES & ACCESSORIES

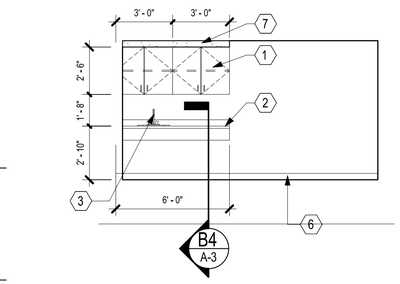

B3 CASEWORK ELEVATION

1/4" = 1'-0"

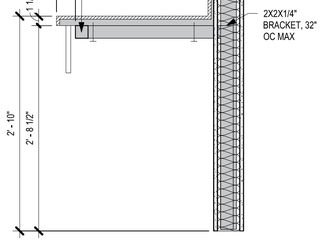

B4 CASEWORK SECTION

1" = 1'-0"

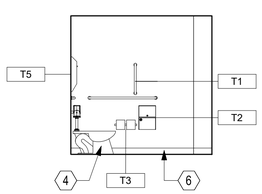

A2 INTERIOR ELEVATION

1/4" = 1'-0"

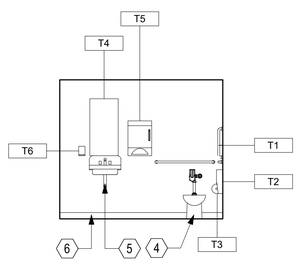

A3 INTERIOR ELEVATION

1/4" = 1'-0"

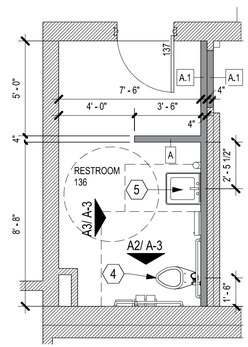

A4 ENLARGED FLOOR PLAN

1/4" = 1'-0"

GENERAL NOTES

A. EXISTING CONDITIONS SHOWN ON DRAWINGS ARE BASED ON ARCHITECT'S FIELD OBSERVATION AND OWNER PROVIDED RECORD DOCUMENTS ONLY. CONTRACTOR IS RESPONSIBLE TO VERIFY EXISTING CONDITIONS IN FIELD FOR ACCURACY AND NOTIFY ARCHITECT IN WRITING OF ANY DISCREPANCIES PRIOR TO PROCEEDING WITH THE WORK.

B. CONTRACTOR TO COORDINATE WITH THE OWNER FOR THE SALVAGE, REMOVAL AND REINSTALLATION OF EQUIPMENT.

C. ALL DIMENSIONS ARE TO FACE OF STUD OR MASONRY UNLESS NOTED OTHERWISE.

D. PROVIDE TRANSITION STRIPS AT ALL FLOOR FINISH TRANSITIONS.

E. ASBESTOS REMOVAL WORK IS PART OF THE SCOPE OF WORK. THE CONTRACTOR SHALL VERIFY WITH THE OWNER THE LOCATION OF THE KNOWN ASBESTOS CONTAINING MATERIALS (A.C.M. BY DEFINITION OF THE A.H.E.R.A.) IN THE CONSTRUCTION AREA. IF THERE IS ANY QUESTION ABOUT THE POSSIBILITY OF OTHER ASBESTOS CONTAINING MATERIALS, SAMPLES OF THE MATERIAL IN QUESTION SHALL BE OBTAINED BY A QUALIFIED PARTY AND SENT TO A LABORATORY FOR ANALYSIS. IF ANY ASBESTOS IS PRESENT, IT SHALL BE DEALT WITH IN A MANNER CONFORMING TO THE APPLICABLE FEDERAL REGULATIONS. DO NOT SEND WORKMEN IN ANY AREA WHERE THERE IS A RISK OF A.C.M. IF, DURING THE CONSTRUCTION PROCESS, MATERIAL IS ENCOUNTERED THAT MAY CONTAIN ASBESTOS, CEASE WORK IN THE VICINITY OF THE POSSIBLE ASBESTOS AND IMMEDIATELY NOTIFY THE OWNER.

KEYED NOTES

1 PLASTIC LAMINATE UPPER CABINETS W/ ONE ADJUSTABLE SHELF
2 PLASTIC LAMINATE COUNTER TOP AND NOSING
3 SINK. SEE PLUMBING
4 WATER CLOSET. SEE PLUMBING
5 LAVATORY. SEE PLUMBING
6 WALL BASE
7 GYPSUM BOARD SOFFIT. FINISH TO MATCH EXISTING CONSTRUCTION

TOILET ACCESSORY SCHEDULE 2

WTW	PRODUCT DESCRIPTION	MOUNTING HEIGHT
T1	36" & 42" HORIZONTAL & 18" VERTICAL GRAB BARS	
T2	SURFACE MOUNTED SANITARY NAPKIN DISPOSAL	
T3	DOUBLE ROLL TOILET PAPER DISPENSER	
T4	MIRROR 18" X 36" WITH SAFETY BACKING	
T5	PAPER TOWEL DISPENSER	
T6	SURFACE MOUNTED SOAP DISPENSER	
T9	MOP AND BROOM HOLDER	

CONFORMED DRAWINGS

THIS CONFORMED DRAWING AS BEEN PREPARED, IN PART, BASED UPON INFORMATION FURNISHED BY OTHERS. WHILE THIS INFORMATION IS BELIEVED TO BE RELIABLE, THE ARCHITECT ASSUMES NO RESPONSIBILITY FOR THE ACCURACY OF THIS CONFORMED DRAWING OR FOR ANY ERRORS OR OMISSIONS THAT MAY HAVE BEEN INCORPORATED INTO IT AS A RESULT OF INCORRECT INFORMATION PROVIDED TO THE ARCHITECT. THOSE RELYING ON THIS CONFORMED DRAWING ARE ADVISED TO OBTAIN INDEPENDENT VERIFICATION OF ITS ACCURACY.

INDIAN HEALTH SERVICE · IHS · 1955 ·

Mark	Description	Date	Appr.
0	AS-BUILTS	7-01-21	

File Name:
Plot Scale:
Plot Date:

zero Accidents
zero Tolerance

DESIGN BY:
DRAWN BY:
REVIEWED BY:

INDIAN HEALTH SERVICES
ALBUQUERQUE, NEW MEXICO

HUITT-ZOLLARS
OA ARCHITECTURE
GranCor CONSTRUCTION EXCELLENCE

INDIAN HEALTH SERVICES
AIHC 1ST AND 3RD FLOOR INTERIOR RENOVATIONS

1ST FLOOR - ENLARGED FLOOR PLAN & INTERIOR ELEVATIONS

SHEET NO.
A-3

SEQUENCE NO.
SHEET 5 OF 31

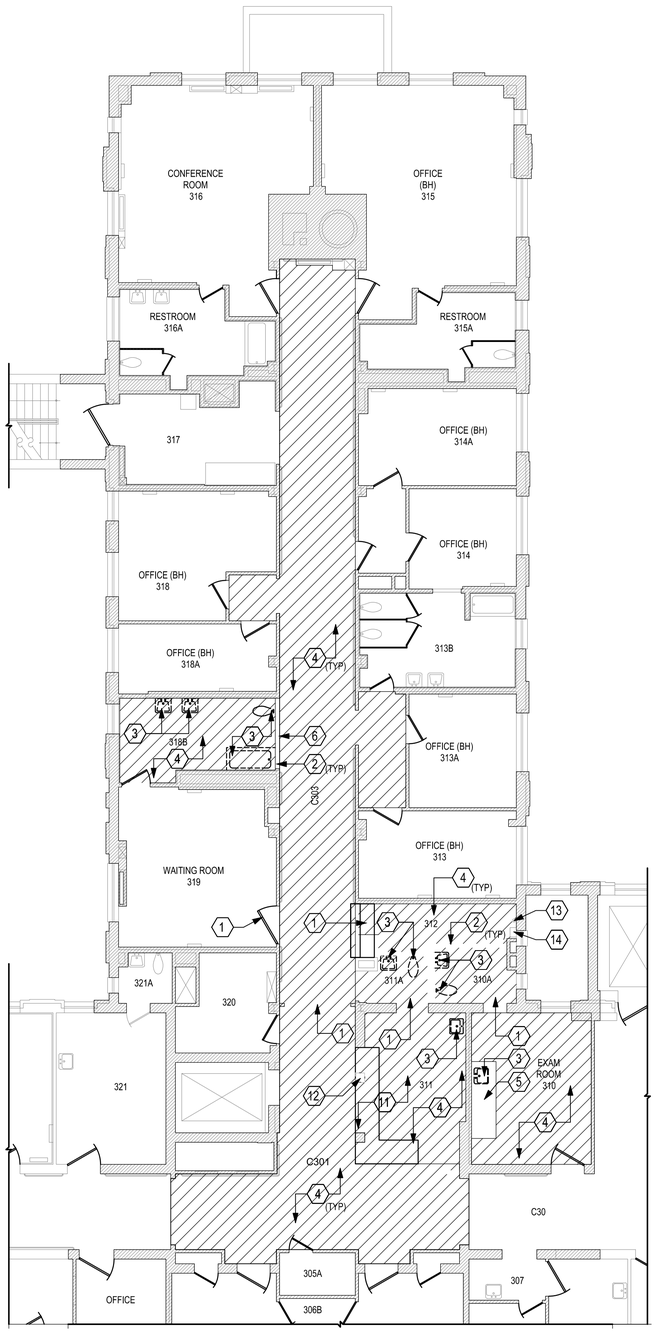

A1 DEMOLITION FLOOR PLAN

1/8" = 1'-0"

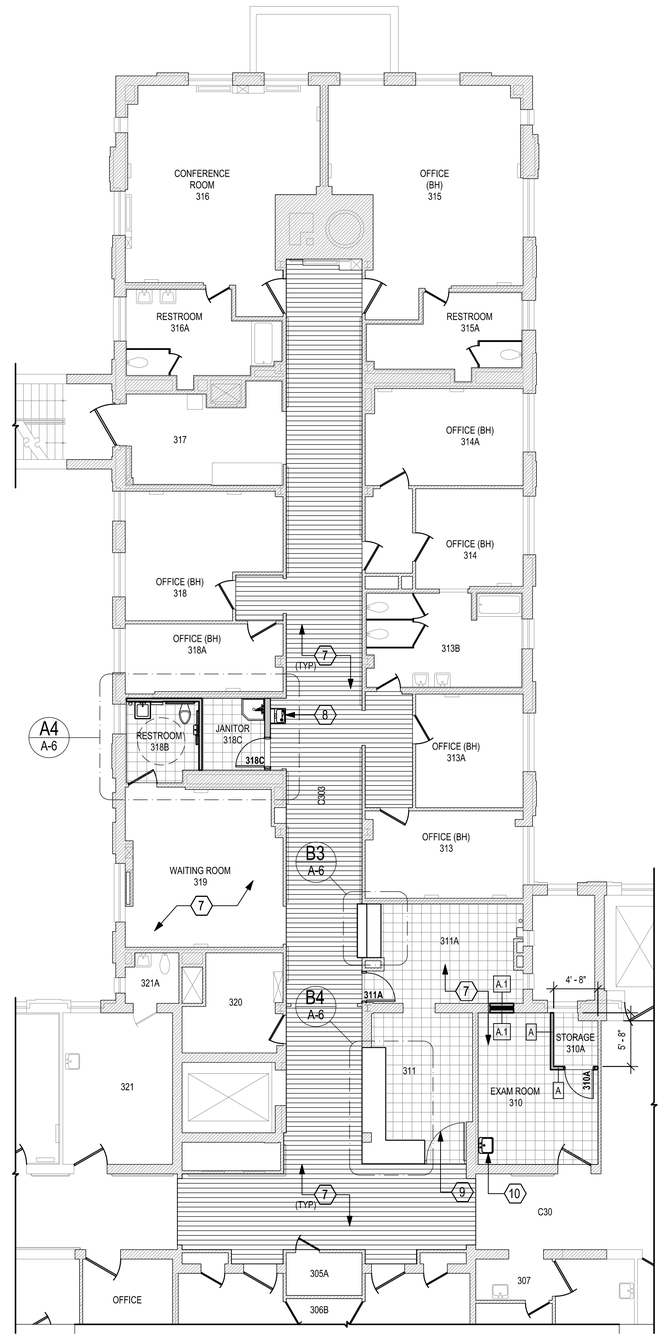

A3 NEW FLOOR PLAN

1/8" = 1'-0"

GENERAL NOTES

A. EXISTING CONDITIONS SHOWN ON DRAWINGS ARE BASED ON ARCHITECT'S FIELD OBSERVATION AND OWNER PROVIDED RECORD DOCUMENTS ONLY. CONTRACTOR IS RESPONSIBLE TO VERIFY EXISTING CONDITIONS IN FIELD FOR ACCURACY AND NOTIFY ARCHITECT IN WRITING OF ANY DISCREPANCIES PRIOR TO PROCEEDING WITH THE WORK.

B. ARCHITECTURAL DRAWINGS DO NOT INCLUDE PROVISIONS FOR DEMOLITION OF WALLS OR STRUCTURAL ELEMENTS. CONTRACTOR TO VERIFY WITH RECORD DRAWINGS AND STRUCTURAL ENGINEER THE EXTENT AND PROVISIONS FOR THE DEMOLITION OF WALLS AND STRUCTURAL ELEMENTS.

C. CONTRACTOR TO COORDINATE WITH THE OWNER FOR THE SALVAGE, REMOVAL AND REINSTALLATION OF EQUIPMENT.

D. ALL DIMENSIONS ARE TO FACE OF STUD OR MASONRY UNLESS NOTED OTHERWISE.

E. PROVIDE TRANSITION STRIPS AT ALL FLOOR FINISH TRANSITIONS.

F. PATCH, REPAIR AND MATCH ADJACENT FINISH AND COLOR AT NEW OPENINGS AND DEMO AREAS.

G. ASBESTOS REMOVAL WORK IS PART OF THE SCOPE OF WORK. THE CONTRACTOR SHALL VERIFY WITH THE OWNER THE LOCATION OF THE KNOWN ASBESTOS CONTAINING MATERIALS (A.C.M. BY DEFINITION OF THE A.H.E.R.A.) IN THE CONSTRUCTION AREA. IF THERE IS ANY QUESTION ABOUT THE POSSIBILITY OF OTHER ASBESTOS CONTAINING MATERIALS, SAMPLES OF THE MATERIAL IN QUESTION SHALL BE OBTAINED BY A QUALIFIED PARTY AND SENT TO A LABORATORY FOR ANALYSIS. IF ANY ASBESTOS IS PRESENT, IT SHALL BE DEALT WITH IN A MANNER CONFORMING TO THE APPLICABLE FEDERAL REGULATIONS. DO NOT SEND WORKMEN IN ANY AREA WHERE THERE IS A RISK OF A.C.M. IF, DURING THE CONSTRUCTION PROCESS, MATERIAL IS ENCOUNTERED THAT MAY CONTAIN ASBESTOS, CEASE WORK IN THE VICINITY OF THE POSSIBLE ASBESTOS AND IMMEDIATELY NOTIFY THE OWNER.

KEYED NOTES

1 REMOVE; EXISTING DOOR AND FRAME
2 REMOVE; EXISTING WALL IN ITS ENTIRETY. SEE GENERAL NOTES ABOVE.
3 REMOVE; EXISTING PLUMBING FIXTURE
4 REMOVE; EXISTING FLOORING. REFER TO ACM REPORT, TEST AND ABATE WHEN NEEDED. PREPARE FOR NEW FLOOR FINISH
5 REMOVE; EXISTING CASEWORK
6 REMOVE; EXISTING PORTION AND TERMINATE HANDRAIL
7 NEW FLOOR FINISH. SEE ROOM FINISH SCHEDULE
8 ADA ACCESSIBLE DRINKING FOUNTAIN (SEE PLUMBING)
9 ACCESS GATE
10 LAVATORY, SEE PLUMBING
11 REFER TO STRUCTURAL BEFORE REMOVING WALLS AT NURSES STATION
12 REMOVE EXISTING COLUMN (SEE STRUCTURAL)
13 EXISTING FIRE INSPECTOR TEST VALVE TO REMAIN
14 EXISTING ELECTRICAL PANEL TO REMAIN

WALL TYPES

A — 5/8" + 5/8" TYPE (X) GYPSUM BOARD, 3 5/8" METAL STUDS @ 2' O.C. WITH 4" BATT INSULATION, CONSTRUCT WALLS UP TO UNDERSIDE OF DECK.

A.1 — 5/8" + 5/8" TYPE (X) GYPSUM BOARD, 3 5/8" METAL STUDS @ 2' O.C. WITH 4" BATT INSULATION, CONSTRUCT WALLS UP TO UNDERSIDE OF DECK.

B — 5/8" + 5/8" TYPE (X) GYPSUM BOARD, 3 5/8" METAL STUDS @ 2' O.C. WITH 4" BATT INSULATION, CONSTRUCT WALLS UP TO UNDERSIDE OF DECK.

LEGEND

- EXISTING WALL TO REMAIN
- EXISTING WALL TO BE REMOVED
- NEW WALL
- EXISTING DOOR TO REMAIN
- EXISTING DOOR TO BE REMOVED
- NEW DOOR
- REMOVE FLOOR FINISH

CONFORMED DRAWINGS

THIS CONFORMED DRAWING AS BEEN PREPARED, IN PART, BASED UPON INFORMATION FURNISHED BY OTHERS. WHILE THIS INFORMATION IS BELIEVED TO BE RELIABLE, THE ARCHITECT ASSUMES NO RESPONSIBILITY FOR THE ACCURACY OF THIS CONFORMED DRAWING OR FOR ANY ERRORS OR OMISSIONS THAT MAY HAVE BEEN INCORPORATED INTO IT AS A RESULT OF INCORRECT INFORMATION PROVIDED TO THE ARCHITECT. THOSE RELYING ON THIS CONFORMED DRAWING ARE ADVISED TO OBTAIN INDEPENDENT VERIFICATION OF ITS ACCURACY.

INDIAN HEALTH SERVICE · IHS · 1955

Mark	Description	Date	Appr.
0	AS-BUILTS	7-01-21	

File Name:
Plot Scale:
Plot Date:

Design to Accidents and to Tolerance

DESIGN BY:
DRAWN BY:
REVIEWED BY:

INDIAN HEALTH SERVICES
ALBUQUERQUE, NEW MEXICO

HUITT-ZOLLARS
QA ENGINEERING
GranCor CONSTRUCTION EXCELLENCE

INDIAN HEALTH SERVICES
AIHC 1ST AND 3RD FLOOR INTERIOR RENOVATIONS

3RD FLOOR - DEMOLITION & NEW FLOOR PLAN

SHEET NO.
A-4

SEQUENCE NO.
SHEET 6 OF 31

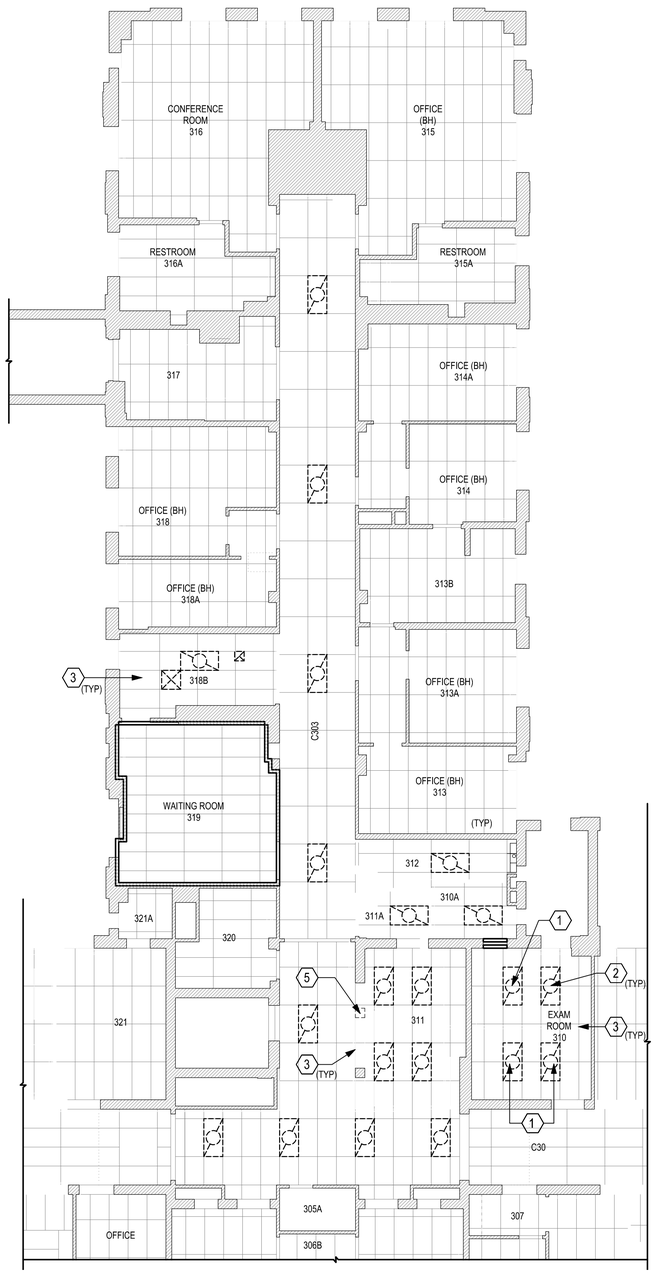

A1 DEMOLITION REFLECTED CEILING PLAN

1/8" = 1'-0"

N

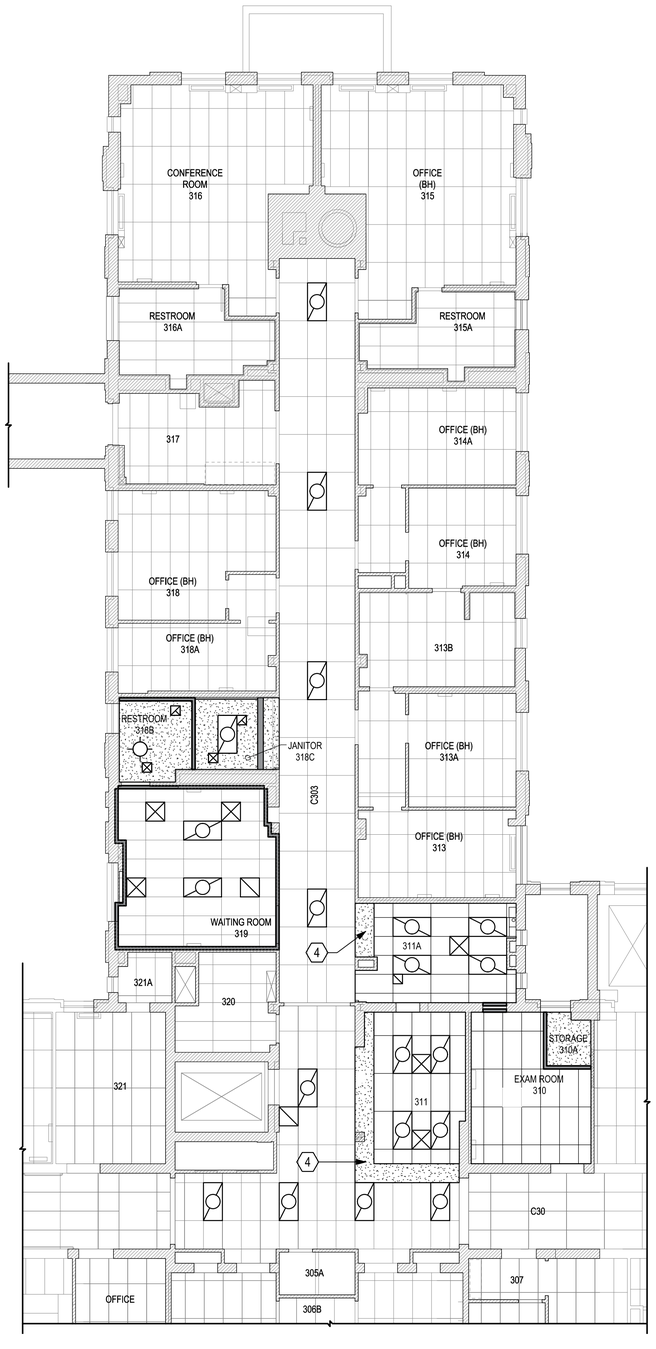

A3 NEW REFLECTED CEILING PLAN

1/8" = 1'-0"

N

GENERAL NOTES

A. EXISTING CONDITIONS SHOWN ON DRAWINGS ARE BASED ON ARCHITECT'S FIELD OBSERVATION AND OWNER PROVIDED RECORD DOCUMENTS ONLY. CONTRACTOR IS RESPONSIBLE TO VERIFY EXISTING CONDITIONS IN FIELD FOR ACCURACY AND NOTIFY ARCHITECT IN WRITING OF ANY DISCREPANCIES PRIOR TO PROCEEDING WITH THE WORK.

B. ARCHITECTURAL DRAWINGS DO NOT INCLUDE PROVISIONS FOR DEMOLITION OF WALLS OR STRUCTURAL ELEMENTS. CONTRACTOR TO VERIFY WITH RECORD DRAWINGS AND STRUCTURAL ENGINEER THE EXTENT AND PROVISIONS FOR THE DEMOLITION OF WALLS AND STRUCTURAL ELEMENTS.

C. CONTRACTOR TO COORDINATE WITH THE OWNER FOR THE SALVAGE, REMOVAL AND REINSTALLATION OF EQUIPMENT.

D. ALL DIMENSIONS ARE TO FACE OF STUD OR MASONRY UNLESS NOTED OTHERWISE.

E. PROVIDE TRANSITION STRIPS AT ALL FLOOR FINISH TRANSITIONS.

F. PATCH, REPAIR AND MATCH ADJACENT FINISH AND COLOR AT NEW OPENINGS AND DEMO AREAS.

G. ASBESTOS REMOVAL WORK IS PART OF THE SCOPE OF WORK. THE CONTRACTOR SHALL VERIFY WITH THE OWNER THE LOCATION OF THE KNOWN ASBESTOS CONTAINING MATERIALS (A.C.M. BY DEFINITION OF THE A.H.E.R.A.) IN THE CONSTRUCTION AREA. IF THERE IS ANY QUESTION ABOUT THE POSSIBILITY OF OTHER ASBESTOS CONTAINING MATERIALS, SAMPLES OF THE MATERIAL IN QUESTION SHALL BE OBTAINED BY A QUALIFIED PARTY AND SENT TO A LABORATORY FOR ANALYSIS. IF ANY ASBESTOS IS PRESENT, IT SHALL BE DEALT WITH IN A MANNER CONFORMING TO THE APPLICABLE FEDERAL REGULATIONS. DO NOT SEND WORKMEN IN ANY AREA WHERE THERE IS A RISK OF A.C.M. IF, DURING THE CONSTRUCTION PROCESS, MATERIAL IS ENCOUNTERED THAT MAY CONTAIN ASBESTOS, CEASE WORK IN THE VICINITY OF THE POSSIBLE ASBESTOS AND IMMEDIATELY NOTIFY THE OWNER.

KEYED NOTES

1 EXISTING LIGHT FIXTURE TO REMAIN
2 REMOVE; EXISTING LIGHT FIXTURE
3 REMOVE; EXISTING CEILING GRID
4 GYP BOARD SOFFIT
5 REMOVE EXISTING COLUMN (SEE STRUCTURAL)

LEGEND

- 2x4 ACOUSTIC LAY-IN CEILING
- GYP. BOARD CEILING - 1/2" TYPE "X"
- CEILING-MOUNTED SUPPLY
- CEILING-MOUNTED RETURN
- 2'x4' LIGHT FIXTURE - CEILING
- STRIP LIGHT FIXTURE - WALL
- RECESSED DOWNLIGHT FIXTURE

CONFORMED DRAWINGS

THIS CONFORMED DRAWING AS BEEN PREPARED, IN PART, BASED UPON INFORMATION FURNISHED BY OTHERS. WHILE THIS INFORMATION IS BELIEVED TO BE RELIABLE, THE ARCHITECT ASSUMES NO RESPONSIBILITY FOR THE ACCURACY OF THIS CONFORMED DRAWING OR FOR ANY ERRORS OR OMISSIONS THAT MAY HAVE BEEN INCORPORATED INTO IT AS A RESULT OF INCORRECT INFORMATION PROVIDED TO THE ARCHITECT. THOSE RELYING ON THIS CONFORMED DRAWING ARE ADVISED TO OBTAIN INDEPENDENT VERIFICATION OF ITS ACCURACY.

INDIAN HEALTH SERVICE · IHS · 1955

Mark	Description	Date	Appr.
0	AS-BUILTS	7-01-21	

File Name:
Plot Scale:
Plot Date:

Zero Accidents
Zero Tolerance

DESIGN BY:
DRAWN BY:
REVIEWED BY:

INDIAN HEALTH SERVICES
ALBUQUERQUE, NEW MEXICO

HUITT-ZOLLARS
GranCor CONSTRUCTION EXCELLENCE
QA ENGINEERING

INDIAN HEALTH SERVICES
AIHC 1ST AND 3RD FLOOR INTERIOR RENOVATIONS

3RD FLOOR - DEMOLITION & NEW REFLECTED CEILING PLAN

SHEET NO.
A-5

SEQUENCE NO.
SHEET 7 OF 31

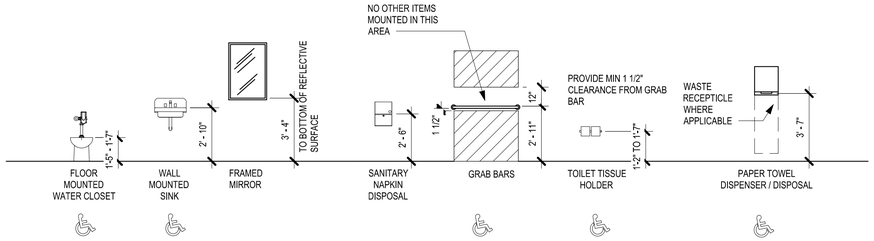

MOUNTING HEIGHTS - FIXTURES & ACCESSORIES

GENERAL NOTES

A. EXISTING CONDITIONS SHOWN ON DRAWINGS ARE BASED ON ARCHITECT'S FIELD OBSERVATION AND OWNER PROVIDED RECORD DOCUMENTS ONLY. CONTRACTOR IS RESPONSIBLE TO VERIFY EXISTING CONDITIONS IN FIELD FOR ACCURACY AND NOTIFY ARCHITECT IN WRITING OF ANY DISCREPANCIES PRIOR TO PROCEEDING WITH THE WORK.

B. ARCHITECTURAL DRAWINGS DO NOT INCLUDE PROVISIONS FOR DEMOLITION OF WALLS OR STRUCTURAL ELEMENTS. CONTRACTOR TO VERIFY WITH RECORD DRAWINGS AND STRUCTURAL ENGINEER THE EXTENT AND PROVISIONS FOR THE DEMOLITION OF WALLS AND STRUCTURAL ELEMENTS.

C. CONTRACTOR TO COORDINATE WITH THE OWNER FOR THE SALVAGE, REMOVAL AND REINSTALLATION OF EQUIPMENT.

D. ALL DIMENSIONS ARE TO FACE OF STUD OR MASONRY UNLESS NOTED OTHERWISE.

E. PROVIDE TRANSITION STRIPS AT ALL FLOOR FINISH TRANSITIONS.

F. PATCH, REPAIR AND MATCH ADJACENT FINISH AND COLOR AT NEW OPENINGS AND DEMO AREAS.

G. ASBESTOS REMOVAL WORK IS PART OF THE SCOPE OF WORK. THE CONTRACTOR SHALL VERIFY WITH THE OWNER THE LOCATION OF THE KNOWN ASBESTOS CONTAINING MATERIALS (A.C.M. BY DEFINITION OF THE A.H.E.R.A.) IN THE CONSTRUCTION AREA. IF THERE IS ANY QUESTION ABOUT THE POSSIBILITY OF OTHER ASBESTOS CONTAINING MATERIALS, SAMPLES OF THE MATERIAL IN QUESTION SHALL BE OBTAINED BY A QUALIFIED PARTY AND SENT TO A LABORATORY FOR ANALYSIS. IF ANY ASBESTOS IS PRESENT, IT SHALL BE DEALT WITH IN A MANNER CONFORMING TO THE APPLICABLE FEDERAL REGULATIONS. DO NOT SEND WORKMEN IN ANY AREA WHERE THERE IS A RISK OF A.C.M. IF, DURING THE CONSTRUCTION PROCESS, MATERIAL IS ENCOUNTERED THAT MAY CONTAIN ASBESTOS, CEASE WORK IN THE VICINITY OF THE POSSIBLE ASBESTOS AND IMMEDIATELY NOTIFY THE OWNER.

KEYED NOTES

1 WATER CLOSET. SEE PLUMBING
2 LAVATORY. SEE PLUMBING
3 MOP SINK. SEE PLUMBING
4 FAUCET WITH SPRAYER. SEE PLUMBING
5 FIBERGLASS REINFORCED PLASTIC (FRP) PANEL
6 COUNTER / FURNITURE PROVIDED BY OTHERS

DOOR SCHEDULE

NUMBER	WIDTH	HEIGHT	DOOR MATL	FRAME MATL	Comments
310A	3' - 0"	7' - 0"	WD	HM	
311A	3' - 0"	7' - 0"	WD	HM	
318C	3' - 0"	7' - 0"	WD	HM	

ROOM FINISH SCHEDULE

ROOM NO	ROOM NAME	FLOOR FIN.
310	EXAM ROOM	VINYL COMPOSITION TILE
310A	STORAGE	VINYL COMPOSITION TILE
311	NURSE	VINYL COMPOSITION TILE
311A	NURSE	VINYL COMPOSITION TILE
318B	RESTROOM	VINYL COMPOSITION TILE
318C	JANITOR / CLOSET	VINYL COMPOSITION TILE
319	WAITING ROOM	VINYL COMPOSITION TILE
C301	CORRIDOR	VINYL COMPOSITION TILE
C303	CORRIDOR	VINYL COMPOSITION TILE

TOILET ACCESSORY SCHEDULE

WTW	PRODUCT DESCRIPTION	MOUNTING HEIGHT
T1	36" & 42" HORIZONTAL & 18" VERTICAL GRAB BARS	
T2	SURFACE MOUNTED SANITARY NAPKIN DISPOSAL	
T3	DOUBLE ROLL TOILET PAPER DISPENSER	
T4	MIRROR 18" X 36" WITH SAFETY BACKING	
T5	PAPER TOWEL DISPENSER	
T6	SURFACE MOUNTED SOAP DISPENSER	
T9	MOP AND BROOM HOLDER	

CONFORMED DRAWINGS

THIS CONFORMED DRAWING AS BEEN PREPARED, IN PART, BASED UPON INFORMATION FURNISHED BY OTHERS. WHILE THIS INFORMATION IS BELIEVED TO BE RELIABLE, THE ARCHITECT ASSUMES NO RESPONSIBILITY FOR THE ACCURACY OF THIS CONFORMED DRAWING OR FOR ANY ERRORS OR OMISSIONS THAT MAY HAVE BEEN INCORPORATED INTO IT AS A RESULT OF INCORRECT INFORMATION PROVIDED TO THE ARCHITECT. THOSE RELYING ON THIS CONFORMED DRAWING ARE ADVISED TO OBTAIN INDEPENDENT VERIFICATION OF ITS ACCURACY.

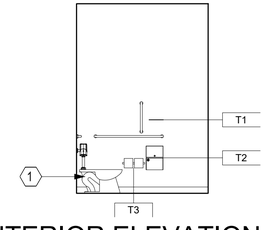

A1 INTERIOR ELEVATION

1/4" = 1'-0"

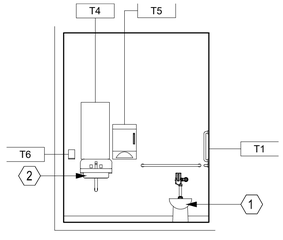

A2 INTERIOR ELEVATION

1/4" = 1'-0"

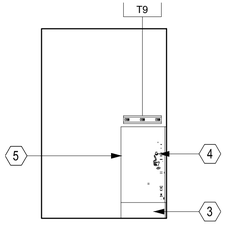

A3 INTERIOR ELEVATION

1/4" = 1'-0"

B3 ENLARGED FLOOR PLAN

1/4" = 1'-0"

B4 ENLARGED FLOOR PLAN

1/4" = 1'-0"

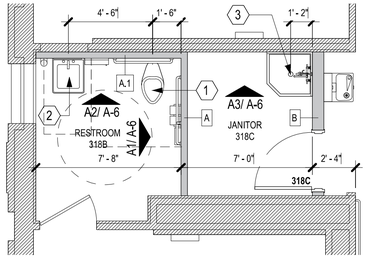

A4 ENLARGED FLOOR PLANS

1/4" = 1'-0"

INDIAN HEALTH SERVICE · IHS · 1955 ·

Mark	Description	Date	Appr.
0	AS-BUILTS	7-01-21	

File Name:
Plot Scale:
Plot Date:

zero Accidents
zero Tolerance

DESIGN BY:
DRAWN BY:
REVIEWED BY:

INDIAN HEALTH SERVICES
ALBUQUERQUE, NEW MEXICO

HUITT-ZOLLARS
QA ENGINEERING
GranCor CONSTRUCTION EXCELLENCE

INDIAN HEALTH SERVICES
AIHC 1ST AND 3RD FLOOR INTERIOR RENOVATIONS

3RD FLOOR - ENLARGED FLOOR PLANS & INTERIOR ELEVATIONS

SHEET NO.
A-6

SEQUENCE NO.
SHEET 8 OF 31

GENERAL NOTES

A. PROVIDE AND INSTALL MATERIAL AND EQUIPMENT AS REQUIRED BY UPC, UMC, NFPA, LIFE SAFETY CODE, GAS CODE, AND ALL OTHER LOCAL CODES AND ORDINANCES THAT APPLY WETHER SHOWN ON THE DRAWINGS OR NOT. WHERE THERE IS A DISCREPANCY BETWEEN THE CODE OR ORDINANCES AND THE DRAWINGS, THE MORE STRINGENT APPLICATION SHALL APPLY.

B. LAYOUT AND INSTALL COMPLETE AND FUNCTIONAL MECHANICAL SYSTEMS, INCLUDING TEMPORARY CUTOFF OF EXISTING UTILITIES, AND ALL CUTTING, PATCHING, AND REPAIR ASSOCIATED WITH INSTALLING THE SYSTEMS.

C. INSTALL FREE AREA OF THE DUCTWORK AS SHOWN ON THE DRAWINGS.

D. ALL DIFFUSERS, GRILLES AND REGISTERS SHALL BE COORDINATED WITH CEILING GRID, LIGHTING LAYOUT AND WALL TYPES.

E. PROVIDE ALL DUCTWORK CONNECTIONS AND TRANSITIONS AT GRILLES, DIFFUSERS, REGISTERS, FILTERS, COILS, AND OTHER LOCATIONS WHERE REQUIRE. CONSTRUCT ALL TRANSITIONS AND CONNECTIONS ACCORDING TO SMACNA STANDARDS.

F. PROVIDE TEST AND BALANCE.

G. COORDINATE WORK WITH THE GENERAL CONTRACTOR TO HAVE THE DUCTWORK, AND INSULATION JACKETS PAINTED TO THE ARCHITECTS REQUIREMENTS.

H. PROVIDE AND INSTALL ALL MECHANICAL EQUIPMENT, TRANSFORMERS, RELAYS AND OTHER ELEMENTS NECESSARY FOR A COMPLETE AND FUNCTIONAL SYSTEM. COMPLETE ALL 24 VOLT CONTROL WIRING AND EQUIPMENT TO THE ABOVE. ALL LINE VOLTAGE WING SHALL BE COMPLETED BY THE ELECTRICAL CONTRACTOR TO THE ABOVE.

I. ALTER DIMENSIONS OF THE DUCTWORK IN THE CEILING SPACE FROM SIZES INDICATED ON THE DRAWINGS ONLY AT SPECIFIC LOCATIONS WHEN NECESSARY TO FIT THE DUCT WORK IN THE SPACE AVAILABLE. REROUTE DUCTWORK IN CEILING SPACE TO AVOID OTHER MECHANICAL EQUIPMENT. LIGHT FIXTURES, ETC. MAINTAIN THE SAME FREE AREA AND SUBMIT PROPOSED CHANGE TO THE ENGINEER FOR APPROVAL. CONTRACTOR'S RESPONSIBLE FOR VERIFYING SPACE LIMITATIONS BEFORE DUCTWORK FABRICATION AND SHALL MAKE CHANGES ACCORDINGLY. PROVIDE ALL NECESSARY TRANSITIONS. COORDINATE LOCATION WITH EXTERIOR ELECTRICAL.

J. VERIFY EQUIPMENT SPECIFIED IS CORRECT FOR FIELD APPLICATION INCLUDING BUT NOT LIMITED TO SIZES, LOCATIONS, CLEARANCES, STRUCTURAL CONSISTENCIES, ETC. BEFORE ORDERING, INSTALL, OR MAKING ANY CHANGES, DELETIONS, OR ADDITIONS TO ANY AND ALL APPLICATIONS THAT APPLY BEFORE ORDERING EQUIPMENT. SUBMIT CHANGES, ADDITIONS AND/OR MODIFICATIONS REQUIRED, TO ENGINEER FOR APPROVAL. NO CHANGE ORDERS OR PASSAGE OF LIABILITY BY THE CONTRACTOR(S) WILL BE ALLOWED AS A RESULT OF THE CONTRACTOR(S) FAILURE TO VERIFY EQUIPMENTS.

K. COORDINATE ALL PROPOSED ROOF PENETRATIONS WITH GENERAL CONTRACTOR AND ARCHITECT AND RELOCATE IF NECESSARY. COORDINATE WITH GENERAL CONTRACTOR/ARCHITECT/OWNER.

L. PROVIDE FLEXIBLE DUCT CONNECTIONS AT ALL ROOF TOP UNITS AND EXHAUST FANS.

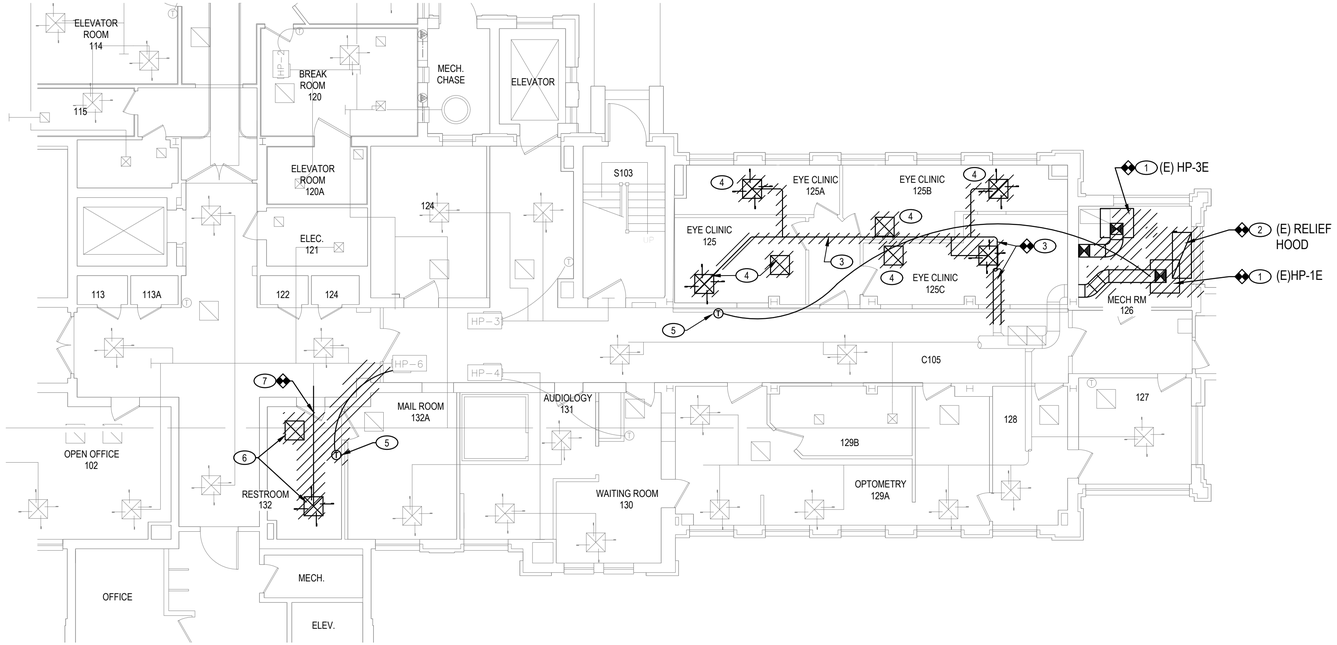

C2 MECHANICAL DEMOLITION PLAN - FIRST FLOOR

1/8" = 1'-0"

N

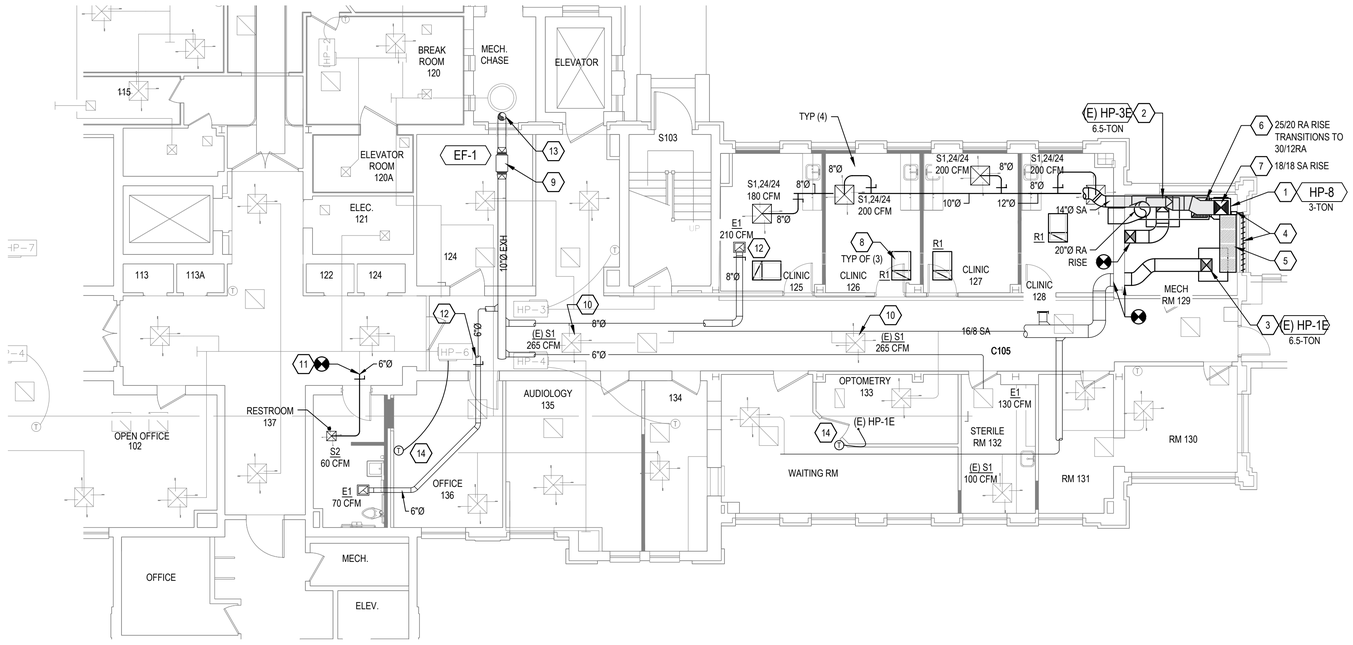

A1 MECHANICAL NEW WORK PLAN - FIRST FLOOR

1/8" = 1'-0"

N

DEMOLITION KEYED NOTES (X)

1. EXISTING HP UNIT TO BE RELOCATED.
2. EXISTING HOOD (OSA) FROM RELIEF AIR HOOD TO BE REMOVED COMPLETELY.
3. EXISTING SUPPLY AIR BRANCH TO BE REMOVED COMPLETELY. SEE NEW WORK FOR SUPPLY AIR DUCTWORK CONFIGURATION.
4. EXISTING SUPPLY AND RETURN AIR DIFFUSERS TO BE REMOVED AND REUSED. CLEAN DIFFUSERS AND GRILLES BEFORE REINSTALLING/CONNECTING TO NEW DUCTWORK.
5. EXISTING THERMOSTAT TO (E) HP-1E TO BE REPLACED WITH NEW. REFER TO NEW WORK FOR LOCATION.
6. REMOVE EXISTING SUPPLY AND RETURN AIR DIFFUSER. REFER TO ARCHITECTURAL REFLECTED CEILING PLAN AND SHEET M-4, AIR DISTRIBUTION SCHEDULE FOR INFORMATION.
7. DEMO EXISTING SUPPLY AIR DUCT BACK AS SHOWN ON PLAN. REFER TO NEW WORK PLAN.

KEYED NOTES (X)

1. NEW 3-TON HP UNIT IN MECHANICAL ROOM.
2. (E) HP UNIT RELOCATED AND MOVED TO THE EAST. CONNECT NEW SUPPLY AIR DUCT, SIZED SAME AS ORIGINAL. RECONFIGURE DUCT ROUTING, MAINTAIN POINT OF EXIT/WALL PENETRATION.
3. (E) HP UNIT RELOCATED AND ROTATED 180-DEGREES. CONNECT NEW SUPPLY AIR DUCT, SIZED SAME AS ORIGINAL. RECONFIGURE DUCT ROUTING, MAINTAIN POINT OF EXIT/WALL PENETRATION.
4. EXISTING RELIEF/OSA LOUVER AND DAMPER TO BE RE-ENERGIZED. RELOCATE EXISTING MOTOR TO BE SURFACE/WALL MOUNTED NEXT TO LOUVER/DAMPER. COORDINATE WORK WITH ELECTRICAL.
5. PROVIDE FABRICATED SHEET METAL FRAME TO HOUSE 2-INCH MERV-11 FILTER. INSTALL TO BACK SIDE OF LOUVER. SHEET METAL FRAME SHALL BE ACCESSIBLE TO CHANGE OUT FILTER(S) FOR MAINTENANCE.
6. NEW 18/18 SA DUCT RISES UP AND ROUTES ALONG BOTTOM OF FINISHED CEILING. SA DUCT ROUTES THRU CORE DRILLED CONCRETE WALL. PROVIDE INSULATION AND SEAL AROUND OPENING.
7. 25/20 RA DUCT RISES THEN TRANSITIONS TO 30/12 RA DUCT. RA DUCT ROUTES BELOW SA DUCT. INSTALL 20"Ø SA RISE TO ROUTE THRU CORE DRILLED CONCRETE WALL. EXTEND RA DUCT MINIMAL 12-INCHES PAST OPENING. PROVIDE RA DUCT WITH 1" ACOUSTICALLY LINED INSULATION.
8. RETURN AIR GRILLE WITH SOUND BOOT.
9. EF-1, IN-LINE EXHAUST FAN LOCATED IN CEILING PLENUM. EXHAUST FAN TO RUN CONTINUOUS. PROVIDE TRANSITIONS FROM FAN OPENING TO DUCT SIZE SHOWN. EXTEND DISCHARGE AS SHOWN IN PLAN TO MECHANICAL CHASE. REFER TO SHEET M-4, EQUIPMENT SCHEDULE.
10. RE-BALANCE EXISTING SUPPLY DIFFUSER AS SHOWN ON PLAN.
11. CONNECT NEW 8"Ø SA DUCT AND ROUTE AS SHOWN ON PLAN.
12. BALANCE EXHAUST AS SHOWN ON PLAN.
13. ROUTE 10"Ø EXHAUST DUCT UP THROUGH OPEN AIR MECHANICAL CHASE. TERMINATE 18" ABOVE ROOF WITH WEATHERPROOF CAP.
14. PROVIDE NEW T-STAT TO ASSOCIATED HEAT PUMP UNIT AS SHOWN ON PLAN. INSTALL AT 48" A.F.F.

INDIAN HEALTH SERVICE · IHS · 1955 ·

Mark	Description	Date	Appr.
0	AS-BUILTS	7-01-21	

File Name: Plot Date:
Plot Scale: Plot Scale Tolerance: 1" on Accidents

DESIGN BY: DRAWN BY: REVIEWED BY:

INDIAN HEALTH SERVICES
ALBUQUERQUE, NEW MEXICO

HUITT-ZOLLARS
GranCor CONSTRUCTION EXCELLENCE
QA

INDIAN HEALTH SERVICES
AIHC 1ST AND 3RD FLOOR INTERIOR RENOVATIONS

DEMOLITION AND NEW WORK PLAN
FIRST FLOOR

SHEET NO.
M-1

SEQUENCE NO.
SHEET 9 OF 31

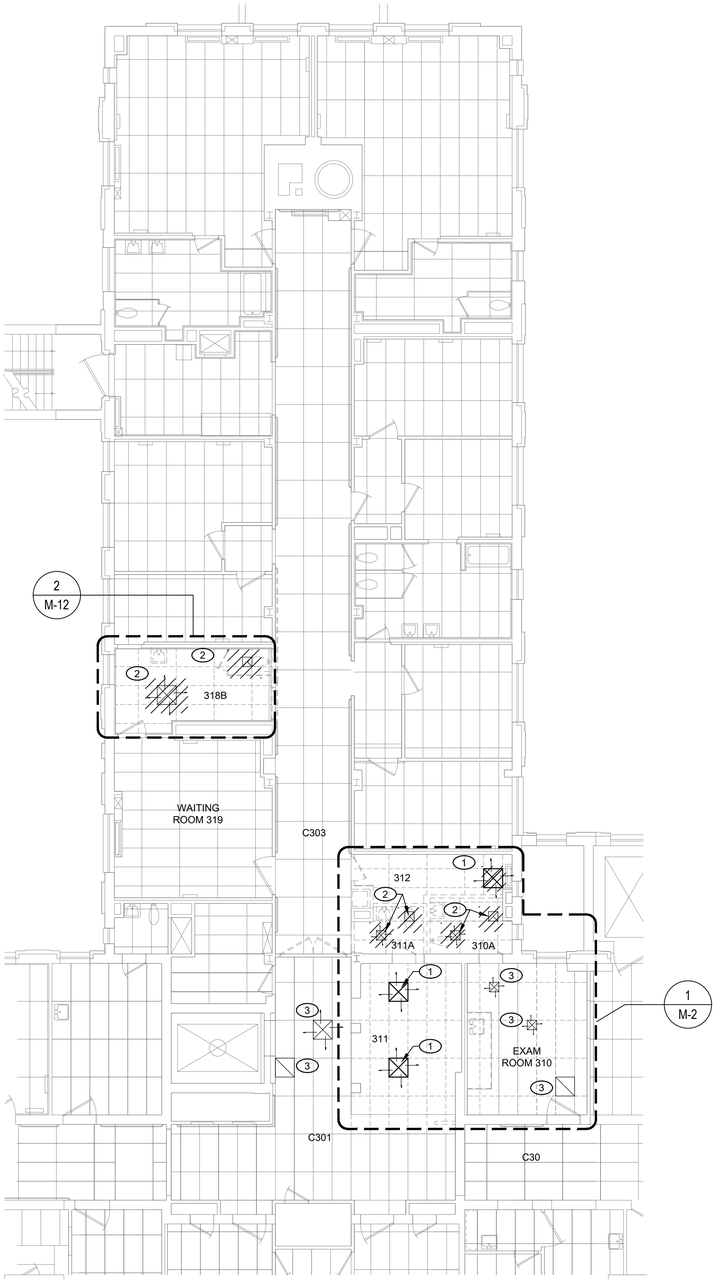

MECHANICAL
DEMOLITION PLAN - 3RD FLOOR

A1

1/8" = 1'-0"

N

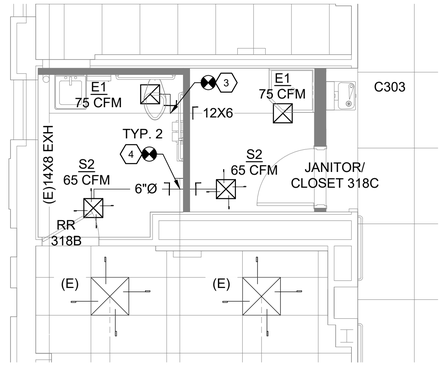

RM 318B AND 318C
MECHANICAL NEW WORK PLAN

2

1/4" = 1'-0"

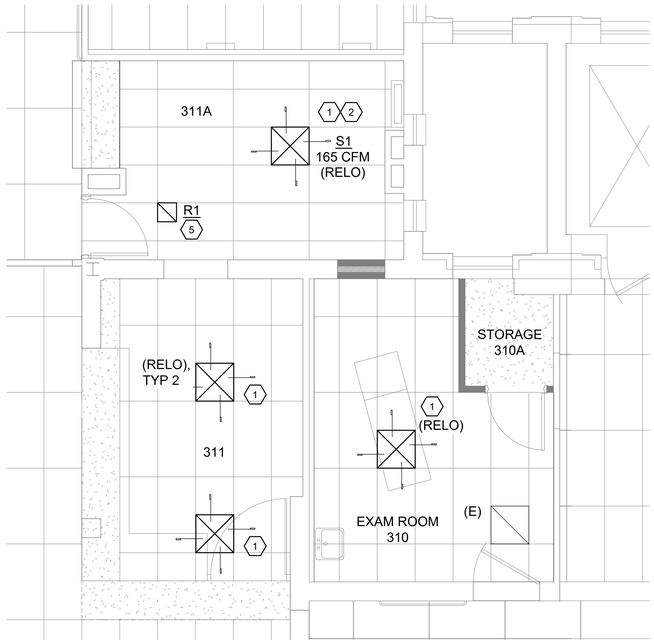

RM 310 & 311
MECHANICAL NEW WORK PLAN

1

1/4" = 1'-0"

GENERAL NOTES

A. PROVIDE AND INSTALL MATERIAL AND EQUIPMENT AS REQUIRED BY UPC, UMC, NFPA, LIFE SAFETY CODE, GAS CODE, AND ALL OTHER LOCAL CODES AND ORDINANCES THAT APPLY WETHER SHOWN ON THE DRAWINGS OR NOT. WHERE THERE IS A DISCREPANCY BETWEEN THE CODE OR ORDINANCES AND THE DRAWINGS, THE MORE STRINGENT APPLICATION SHALL APPLY.
B. LAYOUT AND INSTALL COMPLETE AND FUNCTIONAL MECHANICAL SYSTEMS, INCLUDING TEMPORARY CUTOFF OF EXISTING UTILITIES, AND ALL CUTTING, PATCHING, AND REPAIR ASSOCIATED WITH INSTALLING THE SYSTEMS.
C. ALL DIFFUSERS, GRILLES AND REGISTERS SHALL BE COORDINATED WITH CEILING GRID, LIGHTING LAYOUT AND WALL TYPES.
D. PROVIDE ALL DUCTWORK CONNECTIONS AND TRANSITIONS AT GRILLES, DIFFUSERS, REGISTERS, FILTERS, COILS, AND OTHER LOCATIONS WHERE REQUIRE. CONSTRUCT ALL TRANSITIONS AND CONNECTIONS ACCORDING TO SMACNA STANDARDS.
E. PROVIDE TEST AND BALANCE.

DEMOLITION KEYED NOTES (X)

1. EXISTING AIR DISTRIBUTION DIFFUSER/GRILLE TO BE REMOVED AND REUSED. CLEAN DIFFUSER, AND OR GRILLE BEFORE REINSTALLING/CONNECTING TO NEW DUCTWORK.
2. DEMO EXISTING AIR DISTRIBUTION AND DEMO BACK DUCTWORK AND CAP SEALTIGHT. REFER TO NEW WORK PLAN.
3. EXISTING DIFFUSER TO REMAIN.

KEYED NOTES (X)

1. RELOCATED DIFFUSER TO ACCOMMODATE NEW REFLECTED CEILING PLAN. COORDINATE WITH ARCHITECTURAL RCP.
2. RE-BALANCE EXISTING SUPPLY AIR DIFFUSER AS SHOWN ON PLAN.
3. CONNECT NEW 6"Ø EXHAUST DUCT FROM EXISTING BRANCH. PROVIDE BALANCING DAMPER, TYPICAL.
4. CONNECT NEW 6"Ø SUPPLY AIR DUCT FROM EXISTING BRANCH. PROVIDE BALANCING DAMPER, TYPICAL.
5. RETURN AIR GRILLE WITH SOUND BOOT.

INDIAN HEALTH SERVICE · IHS · 1955 ·

Mark	Description	Date	Appr
0	AS-BUILTS	7-01-21	

File Name:
Plot Scale:
Plot Date:
Dimensions & Tolerance

DESIGN BY:
DRAWN BY:
REVIEWED BY:

INDIAN HEALTH SERVICES
ALBUQUERQUE, NEW MEXICO

HUITT-ZOLLARS
GranCor Construction Excellence

INDIAN HEALTH SERVICES
AIHC 1ST AND 3RD FLOOR INTERIOR RENOVATIONS
DEMOLITION AND NEW WORK PLANS
THIRD FLOOR

SHEET NO.
M-2

SEQUENCE NO.
SHEET 10 OF 31

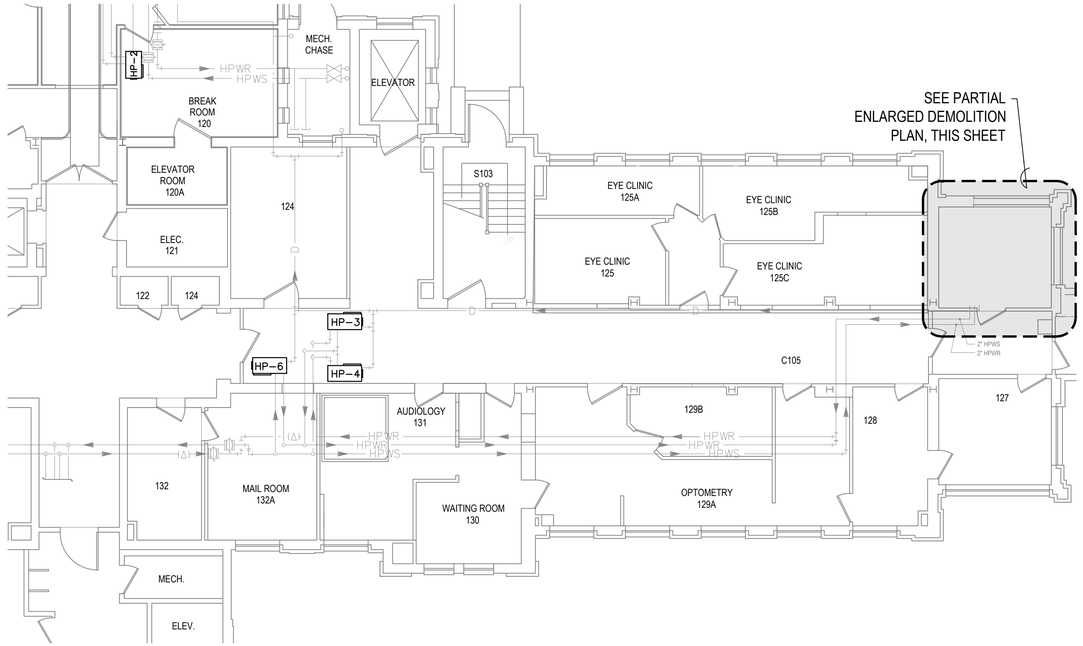

C2 MECHANICAL - PIPING DEMOLITION PLAN FIRST FLOOR

1/8" = 1'-0"

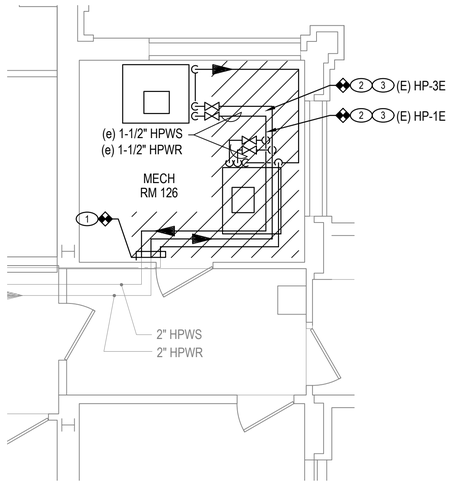

C4 PARTIAL ENLARGED DEMOLITION PLAN

1/4" = 1'-0"

A1 MECHANICAL - PIPING NEW WORK PLAN FIRST FLOOR

1/8" = 1'-0"

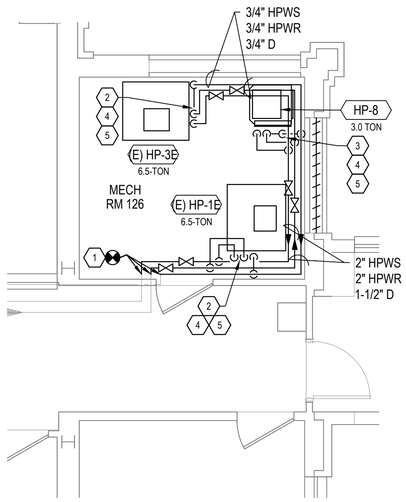

A4 PARTIAL ENLARGED NEW WORK PLAN

1/4" = 1'-0"

GENERAL NOTES

A. PROVIDE AND INSTALL MATERIAL AND EQUIPMENT AS REQUIRED BY UPC, UMC, NFPA, LIFE SAFETY CODE, GAS CODE, AND ALL OTHER LOCAL CODES AND ORDINANCES THAT APPLY WETHER SHOWN ON THE DRAWINGS OR NOT. WHERE THERE IS A DISCREPANCY BETWEEN THE CODE OR ORDINANCES AND THE DRAWINGS, THE MORE STRINGENT APPLICATION SHALL APPLY.

B. LAYOUT AND INSTALL COMPLETE AND FUNCTIONAL MECHANICAL SYSTEMS, INCLUDING TEMPORARY CUTOFF OF EXISTING UTILITIES, AND ALL CUTTING, PATCHING, AND REPAIR ASSOCIATED WITH INSTALLING THE SYSTEMS.

C. COORDINATE WORK WITH GENERAL CONTRACTOR.

D. PROVIDE AND INSTALL ALL MECHANICAL/PIPING EQUIPMENT, TRANSFORMERS, RELAYS AND OTHER ELEMENTS NECESSARY FOR A COMPLETE AND FUNCTIONAL SYSTEM. COMPLETE ALL 24 VOLT CONTROL WIRING AND EQUIPMENT TO THE ABOVE. ALL LINE VOLTAGE WING SHALL BE COMPLETED BY THE ELECTRICAL CONTRACTOR TO THE ABOVE.

E. CONTRACTOR'S RESPONSIBLE FOR VERIFYING SPACE LIMITATIONS BEFORE DUCTWORK FABRICATION AND PIPING, AND SHALL MAKE CHANGES ACCORDINGLY. PROVIDE ALL NECESSARY TRANSITIONS. COORDINATE LOCATION WITH ELECTRICAL.

F. VERIFY EQUIPMENT SPECIFIED IS CORRECT FOR FIELD APPLICATION INCLUDING BUT NOT LIMITED TO SIZES, LOCATIONS, CLEARANCES, STRUCTURAL CONSISTENCIES, ETC. BEFORE ORDERING, INSTALL, OR MAKING ANY CHANGES, DELETIONS, OR ADDITIONS TO ANY AND ALL APPLICATIONS THAT APPLY BEFORE ORDERING EQUIPMENT. SUBMIT CHANGES, ADDITIONS AND/OR MODIFICATIONS REQUIRED, TO ENGINEER FOR APPROVAL. NO CHANGE ORDERS OR PASSAGE OF LIABILITY BY THE CONTRACTOR(S) WILL BE ALLOWED AS A RESULT OF THE CONTRACTOR(S) FAILURE TO VERIFY EQUIPMENTS.

G. COORDINATE ALL PROPOSED ROOF PENETRATIONS WITH GENERAL CONTRACTOR AND ARCHITECT AND RELOCATE IF NECESSARY. COORDINATE WITH GENERAL CONTRACTOR/ARCHITECT/OWNER.

DEMOLITION KEYED NOTES (X)

1. CAP EXISTING HPWR, HPWS AND DRAIN. REFER TO NEW WORK PLAN FOR COORDINATION.
2. EXISTING WATER SOURCE HEAT PUMP TO BE RELOCATED AND RECONFIGURED. REFER TO SHEET M-1, NEW WORK PLAN FOR COORDINATION.
3. REMOVE EXISTING 1-1/2" HPWS, 1-1/2" HPWR AND 3/4" DRAIN SYSTEM COMPLETE, INCLUDING FITTINGS, VALVES, AND SUPPORTS. REFER TO NEW PIPING WORK PLAN FOR COORDINATION.

KEYED NOTES (X)

1. CONNECT NEW 2" HPWS, 2" HPWR AND 1-1/2" DRAIN SYSTEM.
2. ROUTE 1-1/2" HPWS AND 1-1/2" HPWR TO (E) HEAT PUMP UNITS.
3. ROUTE AND CONNECT 3/4" HPWS, 3/4" HPWR AND 3/4" DRAIN TO NEW HP-8, HEAT PUMP UNIT. REFER TO SHEET M-4, EQUIPMENT SCHEDULE.
4. REFER TO TYPICAL HEAT PUMP CONNECTION DETAIL, SHEET M-4.
5. PROVIDE NEW HK-1, HOSE KITS TO EACH HEAT PUMP UNIT.

INDIAN HEALTH SERVICE · IHS · 1955 ·

Mark	Description	Date	Appr.
0	AS-BUILTS	4-22-20	

File Name:
Plot Scale:
Plot Date:
No Accidents and No Tolerance

DESIGN BY:
DRAWN BY:
REVIEWED BY:

INDIAN HEALTH SERVICES
ALBUQUERQUE, NEW MEXICO

HUITT-ZOLLARS
GranCor CONSTRUCTION EXCELLENCE

INDIAN HEALTH SERVICES
AIHC 1ST AND 3RD FLOOR INTERIOR RENOVATIONS

PIPING DEMOLITION & NEW WORK PLANS FIRST FLOOR

SHEET NO.
M-3

SEQUENCE NO.
SHEET 11 OF 31

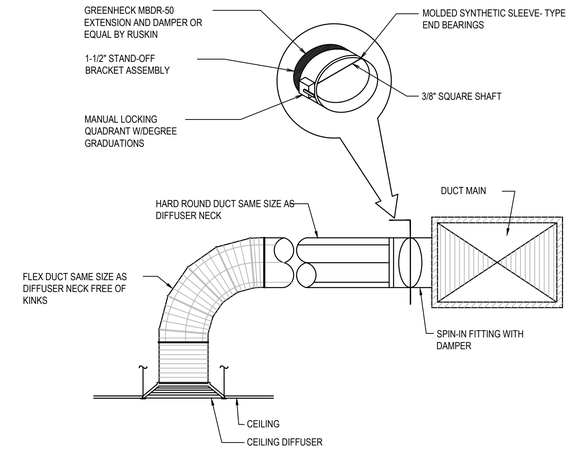

1 M-3 CEILING DIFFUSER DETAIL
SCALE: NONE

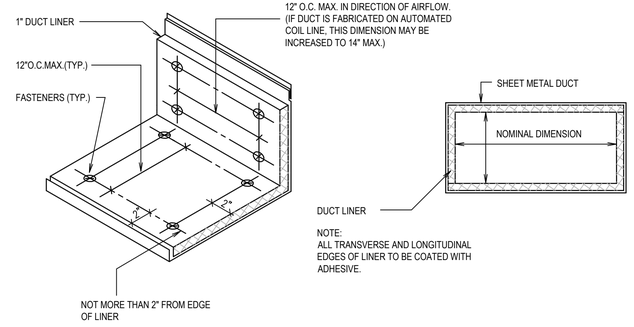

2 M-3 DUCT LINER DETAIL
SCALE: NONE

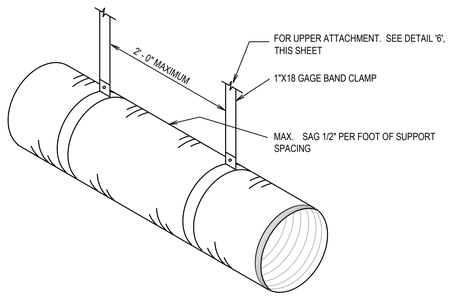

3 M-3 FLEXIBLE DUCT SUPPORT DETAIL
SCALE: NONE

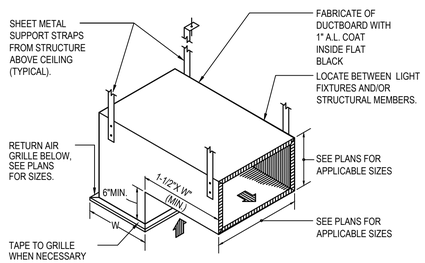

4 M-3 RA GRILLE SOUND BOOT DETAIL
SCALE: NONE

HEAT PUMP (WATER SOURCE) SCHEDULE

SYMBOL	MANUFACTURER AND MODEL	NOMINAL TONNAGE	DESIGN AIRFLOW	COIL PERFORMANCE													ELECTRICAL								EER	FLOW RATE	FLUID PD
				COOLING							HEATING						ELECTRICAL						MOTOR				
				NET SENSIBLE	ENT. FLUID TEMP	LVG. FLUID TEMP	ENT. DRY BULB	LVG. DRY BULB	ENT. WET BULB	LVG. WET BULB	NET CAPACITY	ENT. FLUID TEMP	LVG. FLUID TEMP	ENT. DRY BULB	LVG. DRY BULB	VOLT/PH	MCA	MOCP	ESP	TOTAL ESP	TOTAL FLA	TYPE	POWER			
HP-8	TRANE WSHP MODEL EXVF0364	3.0	1200 CFM	28.7 MBH	85°	93.8°	80°	54.7°	62°	52.5°	48.3 MBH	70°	61.4°	65°	107.6°	460/3	10.5	15	0.50	0.70	9.10	ECM	0.75 HP	16.80	9.0 GPM	0.70

NOTES:
1. PROVIDE HOSE KIT TO EACH HEAT PUMP COMPRISED OF: TWO T & P TEST PORTS, TWO SHUT-OFF BALL, ONE MESH STRAINER, ONE BELL AND GOSSETT FLOW CONTROL VALVE, TWO FLAME AND SMOKE RATED HOSES WITH UNIONS. REFER TO TYPICAL HEAT PUMP CONNECTION DETAIL.
2. SIZE AND INSTALL REFRIGERANT PIPING ACCORDING TO MANUFACTURER'S RECOMMENDATIONS. UNIT SELECTED AT AN ELEVATION OF 5,000 FT ABOVE SEA LEVEL.
3. MOUNT UNIT LEVEL ON EQUIPMENT PAD.
4. ELECTRICAL CONTRACTOR SHALL PROVIDE DISCONNECT SWITCH. REFER TO ELECTRICAL DRAWINGS FOR ADDITIONAL INFORMATION.

(E) HEAT PUMP SCHEDULE

(EXISTING HEAT PUMP UNITS)

SYMBOL	MODEL	NOMINAL TONNAGE	COOLING		HEATING	ELECTRICAL		WATER FLOW GPM	ESP IN WG	WPD FT H2O
			TOTAL MBH	SENSIBLE MBH	TOTAL MBH	V/PH	FLA			
HP-1E	WPVD080	6.5	79.49	77.02	96.11	460/3	18.3	16.80	0.50	6.84
HP-3E	WPVD080	6.5	79.49	77.02	96.11	460/3	18.3	16.80	0.50	6.84

SEQUENCE OF OPERATION

TYPICAL HEAT PUMP UNIT ZONE:

A USER DEFINABLE SCHEDULE WILL EXIST FOR ALL EMS CONTROLLED HEAT PUMP ZONES. TWO MODES OF OPERATION FOR SETPOINTS WILL EXIST. ONE FOR THE OCCUPIED MODE AND ONE FOR THE UNOCCUPIED MODE. IN EITHER MODE THERE WILL BE TWO TEMPERATURE SETPOINTS, ONE FOR COOLING AND ONE FOR HEATING, SEPARATED BY A DEADBAND. AN OPTIMUM START ALGORITHM WILL TRANSITION THE UNOCCUPIED SETPOINTS TO THEIR OCCUPIED VALUES.

THE HEAT PUMPS WILL BE ENABLED FOR OPERATION BY EITHER THE USER DEFINABLE SCHEDULE OR BY A LOCAL OVERRIDE SWITCH LOCATED ON THE ZONE SENSOR FOR EACH HEAT PUMP. ONCE A HEAT PUMP HAS BEEN ENABLED, THE CONTROLLER (T540) WILL VERIFY THAT THERE IS ON HEAT PUMP SHUTDOWN COMMAND BEING BROADCAST BY THE CIRCULATION PUMP CONTROLLER. IF THERE IS NO SUCH SHUTDOWN COMMAND BEING BROADCAST, HEAT PUMP WILL BE ENERGIZED.

A TWO WAY ISOLATION VALVE WILL EXIST ON EACH UNIT THAT WILL OPEN ANYTIME THAT UNIT'S FAN IS ENERGIZED. A ZONE SENSOR FOR EACH UNIT WILL MONITOR THE TEMPERATURE WITHIN THE CONTROLLED SPACE, AND WILL CONTROL THE UNIT COMPRESSOR AND REVERSING VALVE IN ORDER TO MAINTAIN THE ZONE TEMPERATURE WITHIN THE DEFINED SETPOINTS.

EXHAUST FAN SCHEDULE

SYMBOL	MANUFACTURER AND MODEL	TYPE	SERVICE	CONTROLS	CFM	FAN STATIC (IN. W.C)	FAN RPM	VOLT / PH	MOTOR SIZE (HP)	SOUND (SONES)	APPROX. WEIGHT (LBS.)
EF-1	GREENHECK SQ-98-VG	IN-LINE EXHAUST FAN	CLINIC RM 125, RESTROOM 136, STERILE RM 132	CONTINUOUS	445	1.0	2500	115/1ϕ	0.5	24	55

NOTES:
1. MOUNTED IN CEILING PLENUM AND SUSPENDED FROM STRUCTURE.
2. PROVIDE THERMAL OVERLOAD PROTECTION, BACKDRAFT DAMPERS, ALUMINUM GRILLE, FACTORY INSTALLED DISCONNECT SWITCH, AND SOLID STATE SPEED CONTROLLER.

EQUIVALENT MANUFACTURERS:
1. TWIN CITY FAN, PENNBARRY, COOK.

AIR DISTRIBUTION DEVICE SCHEDULE

SYMBOL	DESCRIPTION	MANUFACTURER AND MODEL	TYPE	MATERIAL	FINISH	REMARKS
S1	SUPPLY DIFFUSER	PRICE ASCD	LAY-IN	ALUMINUM	BAKED ENAMEL, WHITE	24/24 SQUARE CONE DIFFUSER. NECK SIZE AS INDICATED.
S2	SUPPLY DIFFUSER	PRICE ASCD	HARD CEILING	ALUMINUM	BAKED ENAMEL, WHITE	12/12 SQUARE CONE DIFFUSER WITH DAMPER. NECK SIZE AS INDICATED.
R1	RETURN AIR GRILLE	PRICE 80	LAY-IN	ALUMINUM	BAKED ENAMEL, WHITE	24/12 RECTANGULAR RETURN GRILLE. 1/2" X 1/2" EGG CRATE GRILLE, LAY-IN FRAME
E1	EXHAUST GRILLE	PRICE	LAY-IN/SURFACE	ALUMINUM	BAKED ENAMEL, WHITE	24/12 RECTANGULAR PANEL, 22/10 NECK SIZE. 1/2" X 1/2" X 1/2" EGG CRATE CORE. FURNISH WITH SQUARE TO ROUND TRANSITION. RAPID MOUNT FRAME AND OBD ADJUSTABLE THRU FACE.

EQUIVALENT MANUFACTURES:
1. KRUEGER, NAILOR, TITUS

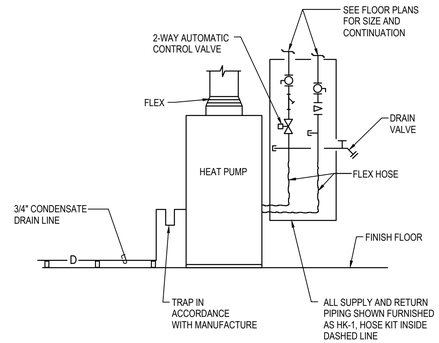

5 M-3 TYPICAL HEAT PUMP CONNECTION DETAIL
SCALE: NONE

INDIAN HEALTH SERVICE · IHS · 1955

Mark	Description	Date	Appr
0	AS-BUILTS	4-22-20	

File Name:
Plot Scale:
Plot Date:
Do Not Scale Drawing - Accidents and Tolerance

DESIGN BY:
DRAWN BY:
REVIEWED BY:

INDIAN HEALTH SERVICES
ALBUQUERQUE, NEW MEXICO

HUITT-ZOLLARS
GranCor Construction Excellence
QA Engineering

INDIAN HEALTH SERVICES
AIHC 1ST AND 3RD FLOOR INTERIOR RENOVATIONS

MECHANICAL EQUIPMENT SCHEDULES & DETAILS

SHEET NO.
M-4

SEQUENCE NO.
SHEET 12 OF 31

PLUMBING SYMBOL LEGEND

(SOME SYMBOLS AND ABBREVIATIONS MAY NOT BE USED ON THIS PROJECT)

GENERAL

X — KEYED NOTE IDENTIFIER

1 / P1 — DETAIL IDENTIFIER
1 = DETAIL NUMBER
P1 = DRAWING NUMBER SHOWING DETAIL

XX-X — EQUIPMENT IDENTIFIER

PIPING LABELS

- COLD WATER (CW)
- HOT WATER (HW)
- 140° HOT WATER (140° HW)
- HOT WATER RECIRC (HWC)
- SS — SANITARY SEWER
- GW — GREASE WASTE
- V — VENT
- NG — NATURAL GAS
- D — CONDENSATE DRAIN
- FP — FIRE PROTECTION
- PIPE IN SLEEVE

PIPING SYMBOLS

- BALL VALVE
- CHECK VALVE
- DIAPHRAGM VALVE
- GATE VALVE
- GATE VALVE (0S & Y)
- GLOBE VALVE
- NEEDLE VALVE
- PLUG VALVE (GAS COCK)
- PRESSURE REDUCING VALVE
- RELIEF OR SAFETY VALVE
- SOLENOID VALVE
- EXPANSION LOOP
- STRAINER
- STRAINER W/BLOW-OFF VALVE
- BALANCING VALVE
- BACK WATER VALVE
- VALVE IN RISE
- GAS PRESSURE REGULATOR
- CAP OR PLUG
- ELBOW - TURNED UP
- ELBOW - TURNED DOWN
- TEE - OUTLET UP
- TEE - OUTLET DOWN
- FLANGE CONNECTION
- UNION
- WALL CLEAN OUT
- CLEAN OUT
- DOUBLE CLEAN OUT
- VENT THROUGH ROOF
- FLOOR DRAIN / FLOOR SINK
- FIRE DEPARTMENT CONNECTION
- HOSE BIBB, FREEZE-LESS WALL HYDRANT
- TRAP PRIMER
- WASHER BOX

ABBREVIATIONS

A	
AFF	ABOVE FINISHED FLOOR
AFG	ABOVE FINISHED GRADE
A/C	AIR CONDITIONING
AHU	AIR HANDLING UNIT
B	
BOP	BOTTOM OF PIPE
BTUH	BTU PER HOUR
BP	BUILDING PRESSURE
BV	BALANCING VALVE
BWV	BACKWATER VALVE
C	
CO	CLEANOUT
COTG	CLEANOUT TO GRADE
CONT.	CONTINUATION
CFCI	CONTRACTOR FURNISHED, CONTRACTOR INSTALLED
CW	COLD WATER
CWS	COLD WATER SUPPLY
D	
D	DRAIN
DCO	DOUBLE CLEAN OUT
DEMO	DEMOLITION
DWH	DOMESTIC WATER HEATER
E	
EXH	EXHAUST
EXV	EXHAUST VENT
F	
FCO	FLOOR CLEANOUT
FD	FLOOR DRAIN
FLEX	FLEXIBLE
FLEX CONN	FLEXIBLE CONNECTOR
FP	FIRE PROTECTION
FPM	FEET PER MINUTE
FS	FLOOR SINK
FT	FEET
G	
GALV	GALVANIZED
GF/CI	GOVERNMENT FURNISHED, CONTRACTOR INSTALLED
GF/GI	GOVERNMENT FURNISHED, GOVERNMENT INSTALLED
GI	GREASE INTERCEPTOR
GPH	GALLONS PER HOUR
GPM	GALLONS PER MINUTE
H	
HB	HOSE BIBB
HD	HEAD
HP	HORSEPOWER
HT	HEIGHT
HW	HOT WATER
140° HW	140° HOT WATER
HWC	HOT WATER RECIRC.
HYD	HYDRANT
HZ	HERTZ
I	
IN	INCHES
ID	INNER DIAMETER
K	
KW	KILOWATT
KWH	KILOWATT HOUR
L	
LP	LIQUID PROPANE
M	
MAX	MAXIMUM
MIN	MINIMUM
N	
NA	NOT APPLICABLE
NIC	NOT IN CONTRACT
NO.	NUMBER (QUANTITY)
NPW	NON-POTABLE WATER
O	
OC	ON CENTER
OD	OUTSIDE DIAMETER
OFCI	OWNER FURNISHED, CONTRACTOR INSTALLED
OFOI	OWNER FURNISHED, OWNER INSTALLED
P	
POC	POINT OF CONNECTION
PSI	POUNDS PER SQUARE INCH
PRV	PRESSURE REDUCING VALVE
Q	
QTY	QUANTITY
R	
RPBFP	REDUCE PRESSURE BACKFLOW PREVENTOR
RPM	REVOLUTIONS PER MINUTE
S	
SS	SANITARY SEWER
SST	STAINLESS STEEL
T	
TBD	TO BE DETERMINED
TP	TRAP PRIMER
TYP	TYPICAL
U	
UNO	UNLESS NOTED OTHERWISE
V	
V	VENT, VOLTS
VAC	VACUUM
VTR	VENT THRU ROOF
W	
WCO	WALL CLEANOUT
WF	WALL FAUCET

DEMOLITION GENERAL NOTES

A. CONTRACTOR SHALL VERIFY LOCATION OF ALL PIPING, EQUIPMENT, ETC. SERVED BY EXISTING EQUIPMENT TO BE REMOVED. CONTRACTOR SHALL REMOVE SUCH ITEMS ONLY IF THEY DO NOT SERVE FIXTURES TO REMAIN. ALL PIPING SHALL BE CAPPED IN A CONCEALED LOCATION AND TO THE NEAREST SHUT-OFF VALVE.
B. CONTRACTOR SHALL BE RESPONSIBLE FOR REPAIRING AND FINISHING SURFACES (WALLS, FLOORS, CEILINGS) DAMAGED DURING REMOVAL OF EQUIPMENT AND PIPING UNLESS REMOVAL OR RENOVATION OF SURFACE IS COVERED UNDER ANOTHER SECTION OF THIS CONTRACT.
C. CONTRACTOR SHALL RETURN ALL PLUMBING FIXTURE UNITS, PIPING, ETC. TO OWNER IN ACCORDANCE WITH DIRECTION OF THE ARCHITECT. IF OWNER DOES NOT WANT THESE ITEMS, THEN CONTRACTOR SHALL DISPOSE OF ITEMS PROPERLY.
D. PIPE ROUTING IS APPROXIMATE ONLY. EACH BIDDER SHALL SATISFY HIMSELF AS TO EXISTING BUILDING CONDITIONS BEFORE SUBMITTING HIS BID. NO ALLOWANCE SHALL BE MADE AFTER CONTRACT IS AWARDED TO ALLOW FOR LACK OF PRE-BID INSPECTION OF BUILDING BY SUCCESSFUL BIDDER.
E. COORDINATE WORK WITH OTHER TRADES TO MINIMIZE CONFLICTS AND "DOWN TIME".
F. FIELD VERIFY ALL DIMENSIONS AND CONDITIONS PRIOR TO COMMENCEMENT OF WORK. SHOULD ANY DISCREPANCIES BE DISCOVERED, VERIFY INTENT WITH THE ARCHITECT BEFORE PROCEEDING.
G. MAINTAIN ALL MECHANICAL, ELECTRICAL, PLUMBING AND COMMUNICATION SERVICES TO OWNER'S OPERATIONAL AREAS WHILE PERFORMING WORK. PROVIDE ALL BYPASS, CROSS CONNECTS AND/OR TEMPORARY ROUTINGS AND CONNECTIONS AS REQUIRED TO INSURE FULL OPERATION OF ALL SERVICES TO ALL AREAS NOT UNDER CONSTRUCTION - AT NO ADDITIONAL COST.
H. CARE SHALL BE TAKEN TO AVOID MECHANICAL DUCTWORK, ELECTRICAL EQUIPMENT AND AIR HANDLING EQUIPMENT ABOVE CEILING.
I. THIS CONTRACTOR SHALL BE RESPONSIBLE FOR COORDINATING ROUTING WITH OTHER DISCIPLINES, RELOCATION OF PIPING DUE TO CONFLICTS SHALL BE AT THE EXPENSE OF THIS CONTRACTOR.

GENERAL PROJECT NOTES

APPLICABLE TO ALL PLUMBING SHEETS. COMPLETE ALL WORK IN FULL COMPLIANCE WITH U.P.C., U.M.C., I.B.C., LIFE SAFETY CODE, N.F.P.A., ADA, AND ALL LOCAL CODES AND ORDINANCES. REFER TO ARCHITECTURAL DRAWINGS FOR ADAABAAG MOUNTING HEIGHTS.

A. REFER TO SPECIFICATION MANUAL FOR PRODUCT INFORMATION, PERFORMANCE REQUIREMENTS, SUBMITTALS AND ACCEPTABLE PRODUCT APPLICATION AND INSTALLATION.

B. REFER TO PLUMBING FIXTURE SCHEDULE FOR FIXTURE, PIPE SIZING, AND ACCESSORIES INFORMATION.

C. ALL BRANCHES SHALL BE VALVED AND ALL VALVES SHALL HAVE UNIONS ADJACENT. ACCESS PANELS AND DOORS SHALL BE FURNISHED TO GENERAL CONTRACTOR FOR INSTALLATION AND ACCESS TO VALVES WHERE REQUIRED. LOCATE ADDITIONAL VALVES AS SHOWN ON DRAWINGS. SEE SPECIFICATIONS FOR ACCESS DOOR REQUIREMENTS.

D. ALL PIPING SHALL PITCH TO DRAIN AND CONTRACTOR SHALL PROVIDE VALVING FOR SYSTEM DRAINAGE. CONTRACTOR SHALL DELIVER A MARKED-UP SET OF PLANS TO THE OWNER (PRIOR TO FINAL PAYMENT) SHOWING ALL BRANCH VALVES AND ALL DRAINAGE POINTS.

E. CARE SHALL BE TAKEN TO AVOID MECHANICAL DUCTWORK, ELECTRICAL EQUIPMENT AND AIR HANDLING EQUIPMENT ABOVE CEILING. THIS CONTRACTOR SHALL BE RESPONSIBLE FOR COORDINATING ROUTING WITH OTHER DISCIPLINES, RELOCATION OF PIPING DUE TO CONFLICTS SHALL BE AT THE EXPENSE OF THIS CONTRACTOR.

F. PIPING BELOW ROOF OR BELOW FLOOR SHALL RUN AS CLOSE AS POSSIBLE TO STRUCTURE AND MAINTAIN SLOPE PER CODE AND SPECIFICATIONS.

G. PROVIDE 12"x12" MINIMUM SIZE ACCESS PANELS FOR VALVES, WATER HAMMER ARRESTORS, AND ALL OTHER DEVICES ABOVE HARD CEILINGS AND BEHIND WALLS UNLESS OTHERWISE NOTED. COORDINATE WITH GENERAL CONTRACTOR.

H. RUN ALL VERTICAL PIPES IN WALL SPACES OR INDICATED CHASES, OR EXPOSED IN MECHANICAL/JANITOR ROOMS.

I. DEVICES NOT SHOWN ON THE FLOOR PLANS ARE SHOWN ON DIAGRAMS, OR DETAILS, OR ARE INCLUDED IN NOTES OR SPECIFICATIONS.

J. ALL SEWER AND VENT PIPING SHALL BE PVC. PVC PIPING SHALL BE INSTALLED PER CURRENT ASTM STANDARD PRACTICE FOR INSTALLATION OF THERMOPLASTIC PIPE FOR SEWERS AND OTHER GRAVITY-FLOW APPLICATIONS.

K. ALL PIPING SHALL BE CONCEALED WHERE POSSIBLE. PIPING SHALL BE INSTALLED IN A NEAT AND PROFESSIONAL MANNER.

L. SECURE ALL PIPING TO WALLS FOR A RIGID INSTALLATION WITH UNISTRUT BRACKETS AND GASKETED PIPE CLAMPS.

M. REFER TO SPECIFICATION MANUAL FOR PRODUCT INFORMATION, PERFORMANCE REQUIREMENTS, SUBMITTALS AND ACCEPTABLE PRODUCT APPLICATION AND INSTALLATION.

N. DOMESTIC WATER SHALL BE ROUTED ABOVE CEILING AND DOWN IN WALLS SERVING INDIVIDUAL PLUMBING FIXTURES WITH THE USE OF COPPER PIPING. DOMESTIC WATER SUPPLY LINES SHALL BE INSULATED WITH JACKETED INSULATION (R-3) AND SUPPORTED THROUGHOUT.

O. WITHOUT EXCEPTION, ELIMINATION OR INTERRUPTION OF ANY PIPING INSULATION FOR HANGERS OR SUPPORTS IS NOT ACCEPTABLE. PROVIDE INSERTS, FOR THE PLACEMENT OF PIPING SUPPORT. CRUSHING OF INSULATION IS NOT ACCEPTABLE.

P. PROVIDE INDIVIDUAL (WALL OR FLOOR) CLEANOUTS IN ADDITION TO THOSE SHOWN ON PLANS AS FOLLOWS:
P.A. GENERAL: ALL WASTE CHANGES OF DIRECTION AND CODE DISTANCES.
P.B. TOILET ROOMS: WASTE CONNECTED TO FIRST FIXTURE IN A GROUP.

Q. DRAWINGS ARE CONSIDERED SCHEMATIC IN NATURE. PROVIDE REQUIRED FITTINGS AND OFFSETS FOR A COMPLETELY OPERATIONAL INSTALLATION.

R. TEST PIPING PRIOR TO INSTALLATION OF INSULATION.

S. LABEL ALL VALVES. PROVIDE ISOLATION VALVES AT ALL COLD AND HOT WATER BRANCHES FROM MAINS SERVING ONE OR MORE FIXTURES.

T. DO NOT RUN PIPING OVER ANY ELECTRICAL PANEL, REGARDLESS OF HEIGHT.

U. RUN PIPING AS HIGH AS POSSIBLE IN CEILING SPACES.

V. FIREPROOF ALL PENETRATIONS THROUGH FIRE RATED WALLS AND FLOORS.

W. VALVES ABOVE CEILINGS SHALL BE LOCATED AT LEAST 12" AWAY FROM WALLS.

X. SANITARY WASTE SHALL BE SLOPED AT 1/4" PER FOOT MINIMUM, UNLESS NOTED OTHERWISE.

Y. PIPING SUPPORTED FROM WALL, SUCH AS DOMESTIC WATER, SHALL BE SUPPORTED SO AS NOT TO DAMAGE THE BUILDING INSULATION AND VAPOR BARRIERS. PROVIDE SUPPORT EXTENSIONS TO KEEP PIPING AWAY FROM INSULATION AND MOISTURE PROOF SUPPORT PENETRATIONS.

INDIAN HEALTH SERVICE · IHS · 1955

Mark	Description	Date	Appr
0	AS-BUILTS	4-22-20	

File Name: | Plot Date:
Plot Scale:
Do Not Scale Drawing — Accept Dimensions and Tolerance

DESIGN BY: | DRAWN BY: | REVIEWED BY:

INDIAN HEALTH SERVICES
ALBUQUERQUE, NEW MEXICO

HUITT-ZOLLARS
GranCor Construction Excellence
QA Quality Assurance Engineering

INDIAN HEALTH SERVICES
AIHC 1ST AND 3RD FLOOR INTERIOR RENOVATIONS

SYMBOL, LEGEND AND GENERAL PROJECT NOTES

SHEET NO.
P-0

SEQUENCE NO.
SHEET 13 OF 31

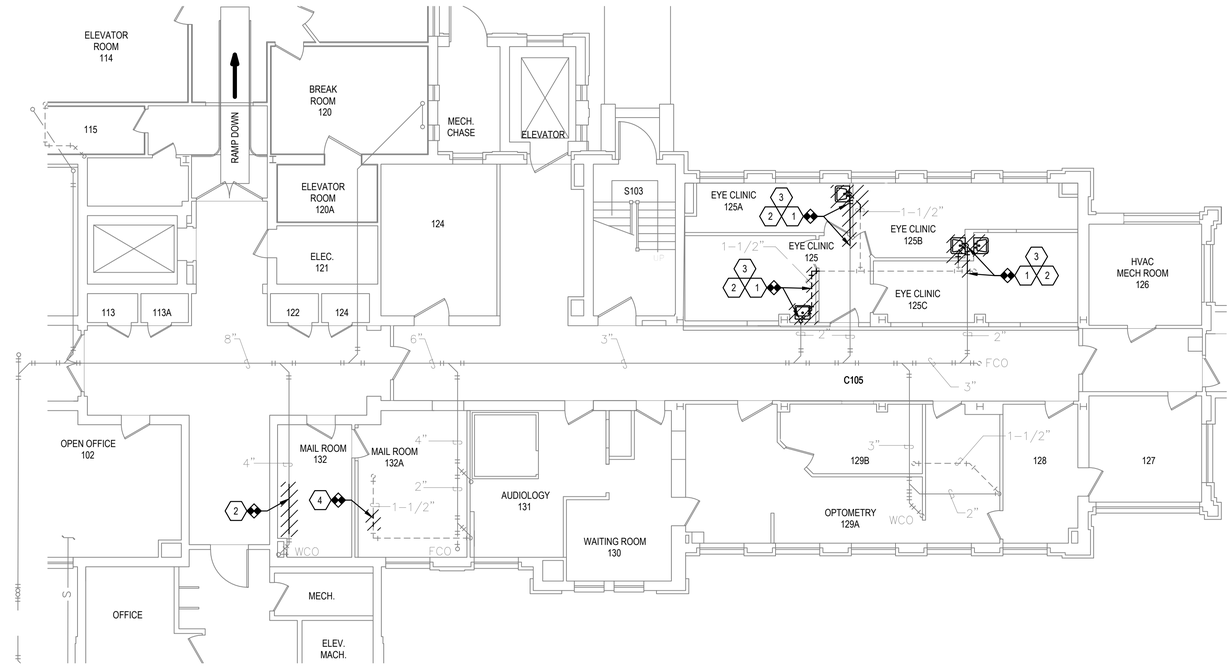

C2 PLUMBING WASTE & VENT DEMOLITION PLAN FIRST FLOOR

1/8" = 1'-0"

N

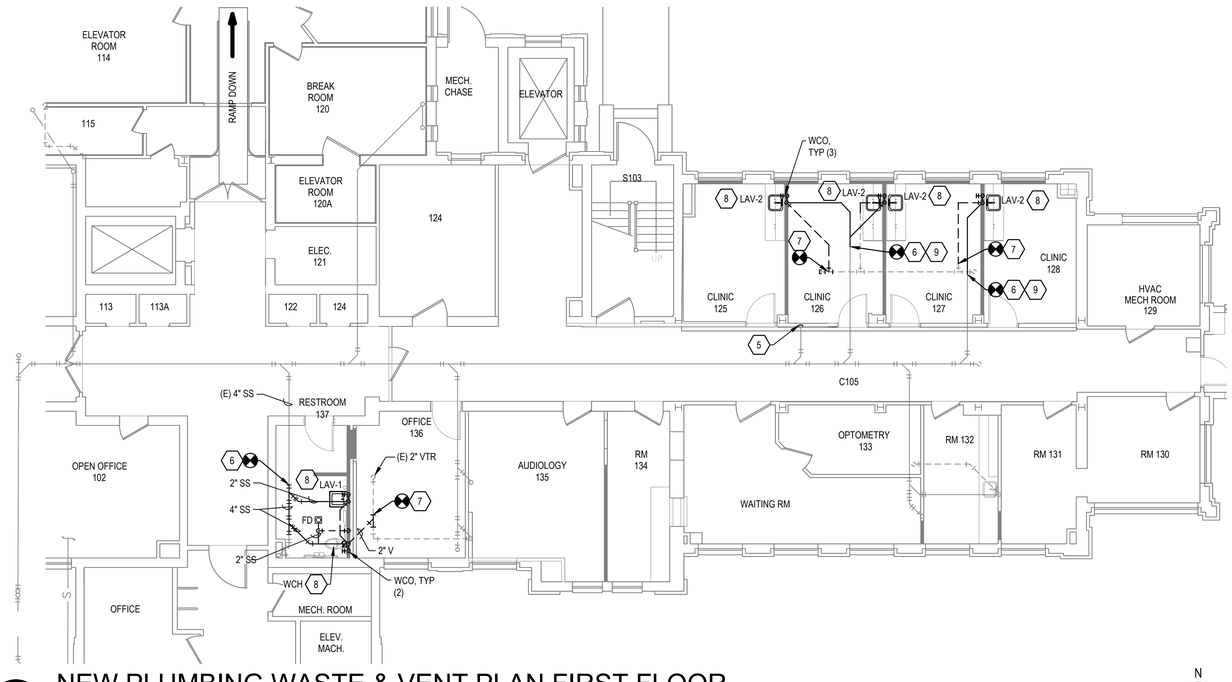

A2 NEW PLUMBING WASTE & VENT PLAN FIRST FLOOR

1/8" = 1'-0"

N

GENERAL NOTES

A. REFER TO SHEET P-0, PLUMBING GENERAL NOTES.
B. REFER TO SHEET P-5, PLUMBING DETAILS AND FIXTURE SCHEDULE.

KEYED NOTES (X)

1. DISCONNECT AND REMOVE EXISTING PLUMBING FIXTURE.
2. SAW-CUT EXISTING CONCRETE SLAB TO LIMITS SHOWN FOR NEW TIE-IN CONNECTION.
3. DEMO CONNECTED SANITARY WASTE AND VENT PIPING BACK. EXISTING WASTE AND VENT BRANCH MAIN SHALL BE USED. REFER TO NEW WORK FOR CONTINUATION.
4. DEMO SECTION(S) OF VENT PIPING FOR NEW TIE-IN CONNECTION. REFER TO NEW WORK FOR CONTINUATION.
5. CAP EXISTING WASTE PIPING, LEAKTIGHT.
6. CONNECT NEW WASTE PIPING AND TIE-INTO EXISTING. VERIFY INVERT ELEVATIONS AND ENSURE SYSTEM HAS POSITIVE FLOW. PIPE SIZING SHOWN PER PLAN.
7. CONNECT NEW VENT PIPING AND TIE-INTO EXISTING. PIPE SIZING SHOWN PER PLAN. ROUTING IS DIAGRAMMATIC.
8. REFER TO SHEET P-5, PLUMBING FIXTURE SCHEDULE FOR INFORMATION.
9. PATCH AND REPAIR SAW CUT TO MATCH EXISTING FINISH FLOOR ELEVATION. REFER TO ARCHITECTURAL FINISH SCHEDULE.

INDIAN HEALTH SERVICE · PHS · 1955 ·

Mark	Description	Date	Appr
0	AS-BUILTS	4-22-20	

File Name:
Plot Scale:
Plot Date:
No Accidents Zero Tolerance

DESIGN BY: NQM
DRAWN BY: NQM
REVIEWED BY: JA

INDIAN HEALTH SERVICES
ALBUQUERQUE, NEW MEXICO

HUITT-ZOLLARS
GranCor Construction Management
QA

INDIAN HEALTH SERVICES
AIHC 1ST AND 3RD FLOOR INTERIOR RENOVATIONS

WASTE & VENT DEMO & NEW WORK PLAN FIRST FLOOR

SHEET NO.
P-2

SEQUENCE NO.
SHEET 15 OF 31

FIRE PROTECTION & FIRE ALARM GENERAL NOTES

A. EXISTING FIRE SPRINKLER HEADS SHALL REMAIN UNLESS NOTED OTHERWISE. NOTIFY GENERAL CONTRACTOR OF ANY CONFLICTS FOUND IN THE FIELD PRIOR TO DEMOLITION OR NEW WORK.

B. CONTRACTOR SHALL ADJUST LOCATION OF ANY FIRE SPRINKLER HEAD(S) THAT IS IN CONFLICT WITH ANY ASSOCIATED MECHANICAL EQUIPMENT, DUCTWORK, PIPING OR LIGHT FIXTURES. NEW WORK SHALL BE COORDINATED WITH ARCHITECTURAL REFLECTED CEILING PLAN.

DEMOLITION KEYED NOTES (X)

REFER TO SHEET P-0, PLUMBING SYMBOL, LEGEND AND GENERAL PROJECT NOTES.
REFER TO SHEET P-5, PLUMBING DETAILS AND FIXTURE SCHEDULE.
REFER TO SHEET P-4, NEW WORK PLAN FOR CONTINUATION.

1. EXISTING PIPING TO AND FROM MECHANICAL SHAFT TO REMAIN. ENSURE PIPING IS UNDISTURBED DURING DEMOLITION OR NEW WORK.
2. DISCONNECT AND REMOVE PLUMBING FIXTURE COMPLETE.
3. DEMO SUPPLY LINE BACK TO SOURCE AND CAP SEALTIGHT.
4. PROVIDE SHUT-OFF VALVE(S) IF ONE IS NOT INSTALLED.
5. DISCONNECT SUPPLY PIPING FROM PLUMBING FIXTURE. SUPPLY PIPING SHALL BE REUSED. REFER TO SHEET P-4, FOR NEW WORK PLAN.
6. DISCONNECT CONNECTED SANITARY WASTE AND VENT PIPING. EXISTING WASTE AND VENT BRANCH SHALL REMAIN OR RE-USED. REFER TO SHEET P-4, FOR CONTINUATION.
7. DEMO SECTION(S) OF VENT PIPING FOR NEW TIE-IN CONNECTION.
8. DEMO WASTE PIPING BACK TO SOURCE AND CAP LEAKTIGHT.
9. EXISTING VTR, VENT THRU ROOF TO REMAIN.
10. PATCH AND REPAIR TO MATCH EXISTING FINISH FLOOR ELEVATION. REFER TO ARCHITECTURAL FINISH SCHEDULE.
11. EXISTING FIRE HOSE CABINET AND SUPPLY PIPE LOCATION.
12. EXISTING FIRE SPRINKLER HEAD TO REMAIN UNLESS NOTED OTHERWISE.
13. SPRINKLER HEAD TO BE REMOVED AND RELOCATED TO ALLOW FOR NEW REFLECTED CEILING PLAN. REFER TO SHEET P-4 FOR NEW WORK PLAN.
14. EXISTING FIRE INSPECTOR TEST VALVE TO REMAIN.

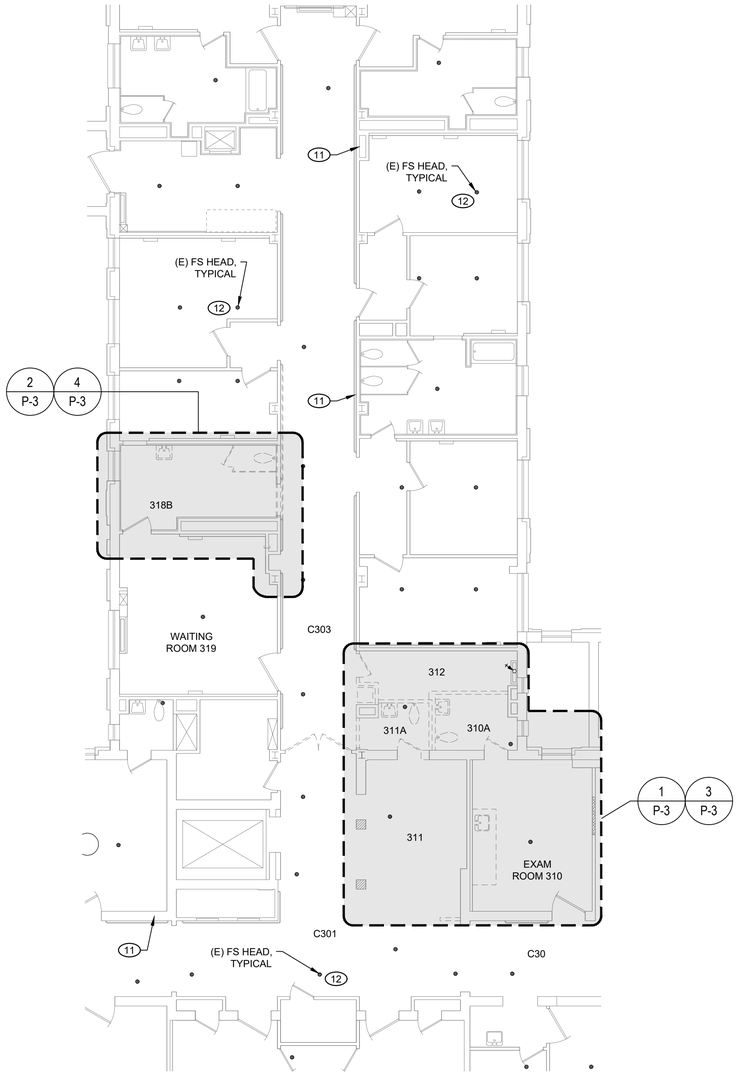

PLUMBING
DEMOLITION PLAN - 3RD FLOOR

A1 1/8" = 1'-0"

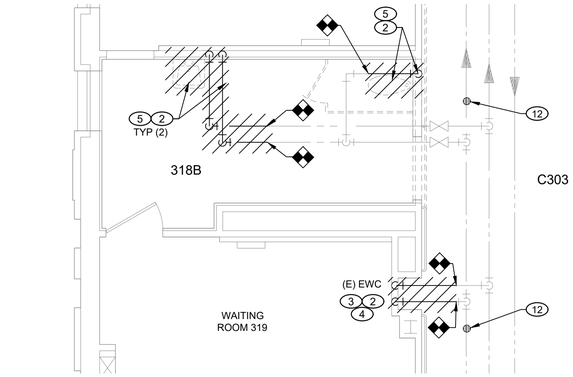

RM 318B
WATER DEMO PLAN

2 1/4" = 1'-0"

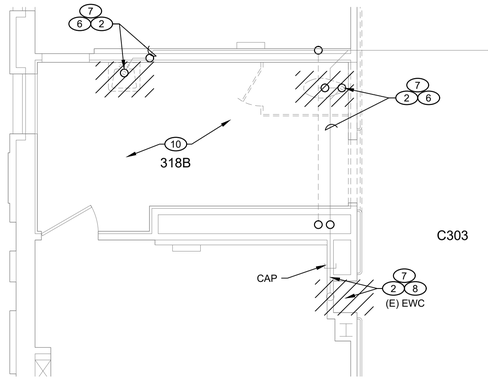

RM 318B
WASTE & VENT DEMO PLAN

4 1/4" = 1'-0"

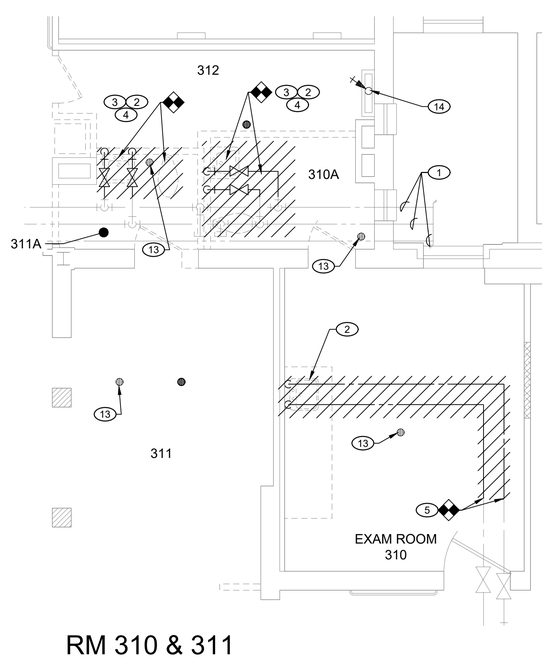

RM 310 & 311
WATER DEMO PLAN

1 1/4" = 1'-0"

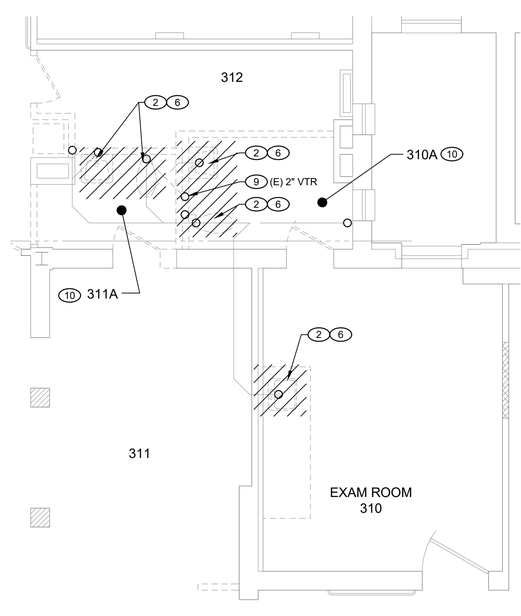

RM 310 & 311
WASTE & VENT DEMO PLAN

3 1/4" = 1'-0"

INDIAN HEALTH SERVICE · IHS · 1955 ·

Mark	Description	Date	Appr
0	AS-BUILTS	4-22-20	

File Name:
Plot Scale:
Plot Date:
Do not Accept Dimensions Without Tolerance

DESIGN BY:
DRAWN BY:
REVIEWED BY:

INDIAN HEALTH SERVICES
ALBUQUERQUE, NEW MEXICO

HUITT-ZOLLARS
GranCor Construction Excellence
QA

INDIAN HEALTH SERVICES
AIHC 1ST AND 3RD FLOOR INTERIOR RENOVATIONS
PLUMBING DEMOLITION PLANS
THIRD FLOOR

SHEET NO.
P-3

SEQUENCE NO.
SHEET 16 OF 31

DEMOLITION & GENERAL NOTES

A. CONTRACTOR SHALL VERIFY LOCATION OF ALL PIPING, EQUIPMENT, ETC. SERVED BY EXISTING EQUIPMENT TO BE REMOVED. CONTRACTOR SHALL REMOVE SUCH ITEMS ONLY IF THEY DO NOT SERVE FIXTURES TO REMAIN. ALL PIPING SHALL BE CAPPED IN A CONCEALED LOCATION AND TO THE NEAREST SHUT-OFF VALVE.

B. CONTRACTOR SHALL BE RESPONSIBLE FOR REPAIRING AND FINISHING SURFACES (WALLS, FLOORS, CEILINGS) DAMAGED DURING REMOVAL OF EQUIPMENT AND PIPING UNLESS REMOVAL OR RENOVATION OF SURFACE IS COVERED UNDER ANOTHER SECTION OF THIS CONTRACT.

C. CONTRACTOR SHALL RETURN ALL PLUMBING FIXTURE UNITS, PIPING, ETC. TO OWNER IN ACCORDANCE WITH DIRECTION OF THE ARCHITECT. IF OWNER DOES NOT WANT THESE ITEMS, THEN CONTRACTOR SHALL DISPOSE OF ITEMS PROPERLY.

D. PIPE ROUTING IS APPROXIMATE ONLY. EACH BIDDER SHALL SATISFY HIMSELF AS TO EXISTING BUILDING CONDITIONS BEFORE SUBMITTING HIS BID. NO ALLOWANCE SHALL BE MADE AFTER CONTRACT IS AWARDED TO ALLOW FOR LACK OF PRE-BID INSPECTION OF BUILDING BY SUCCESSFUL BIDDER.

E. COORDINATE WORK WITH OTHER TRADES TO MINIMIZE CONFLICTS AND "DOWN TIME".

F. FIELD VERIFY ALL DIMENSIONS AND CONDITIONS PRIOR TO COMMENCEMENT OF WORK. SHOULD ANY DISCREPANCIES BE DISCOVERED, VERIFY INTENT WITH THE ARCHITECT BEFORE PROCEEDING.

G. MAINTAIN ALL MECHANICAL, ELECTRICAL, PLUMBING AND COMMUNICATION SERVICES TO OWNER'S OPERATIONAL AREAS WHILE PERFORMING WORK. PROVIDE ALL BYPASS, CROSS CONNECTS AND/OR TEMPORARY ROUTINGS AND CONNECTIONS AS REQUIRED TO INSURE FULL OPERATION OF ALL SERVICES TO ALL AREAS NOT UNDER CONSTRUCTION - AT NO ADDITIONAL COST.

H. ALL PIPING SHALL BE CONCEALED WHERE POSSIBLE. ALL EXPOSED PIPING, WHERE CONCEALMENT IS NOT POSSIBLE SHALL BE INSTALLED IN A NEAT AND PROFESSIONAL MANNER.

I. NO WATER PIPING SHALL BE LOCATED IN OUTSIDE WALLS, UNLESS SHOWN TO BE, AND THEN PIPING TO BE INSULATED AND LOCATED AS CLOSE AS POSSIBLE TO INSIDE OF WALL CAVITY WITH ADDITIONAL INSULATION BETWEEN PIPING AND EXTERIOR OF WALL.

J. ALL BRANCHES SHALL BE VALVED AND ALL VALVES SHALL HAVE UNIONS ADJACENT. ACCESS PANELS AND DOORS SHALL BE FURNISHED TO GENERAL CONTRACTOR FOR INSTALLATION AND ACCESS TO VALVES WHERE REQUIRED. LOCATE ADDITIONAL VALVES AS SHOWN ON DRAWINGS. SEE SPECIFICATIONS FOR ACCESS DOOR REQUIREMENTS.

K. ALL PIPING SHALL PITCH TO DRAIN AND CONTRACTOR SHALL PROVIDE VALVING FOR SYSTEM DRAINAGE. CONTRACTOR SHALL DELIVER A MARKED-UP SET OF PLANS TO THE OWNER (PRIOR TO FINAL PAYMENT) SHOWING ALL BRANCH VALVES AND ALL DRAINAGE POINTS.

L. CARE SHALL BE TAKEN TO AVOID MECHANICAL DUCTWORK, ELECTRICAL EQUIPMENT AND AIR HANDLING EQUIPMENT ABOVE CEILING. THIS CONTRACTOR SHALL BE RESPONSIBLE FOR COORDINATING ROUTING WITH OTHER DISCIPLINES, RELOCATION OF PIPING DUE TO CONFLICTS SHALL BE AT THE EXPENSE OF THIS CONTRACTOR.

M. SECURE ALL PIPING TO WALLS FOR A RIGID INSTALLATION WITH UNISTRUT BRACKETS AND RUBBER NEOPRENE GASKETED PIPE CLAMPS.

N. REFER TO ARCHITECTURAL DRAWINGS FOR MOUNTING HEIGHTS OF ANY WALL MOUNTED PLUMBING FIXTURES.

O. COORDINATE ROUTING OF WASTE PIPING BELOW SLAB WITHIN BUILDING WITH STRUCTURAL FOOTINGS.

P. DOMESTIC WATER SHALL BE ROUTED THROUGHOUT BUILDING ABOVE CEILING AND DOWN IN WALLS SERVING FIXTURES WITH THE USE OF TYPE K COPPER WATER SUPPLY PIPING. PROVIDE MANUFACTURER'S SUPPORT BENDS FOR ANY ELBOWS AND FITTINGS AS REQUIRED.

Q. DOMESTIC WATER PIPING SHALL BE LABELED.

R. REFER TO SHEET P-1 FOR PLUMBING GENERAL NOTES.

S. REFER TO SHEET P-3 FOR PLUMBING DETAILS AND FIXTURE SCHEDULE.

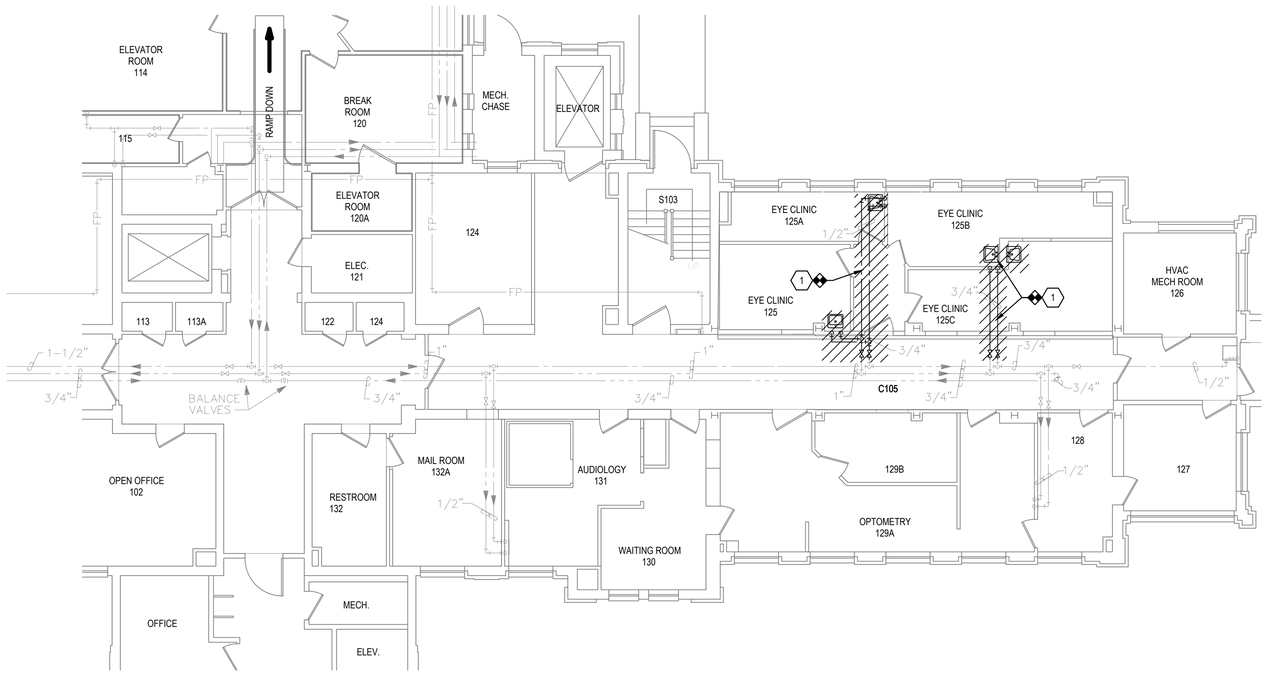

C2 PLUMBING WATER DEMOLITION PLAN FIRST FLOOR

1/8" = 1'-0"

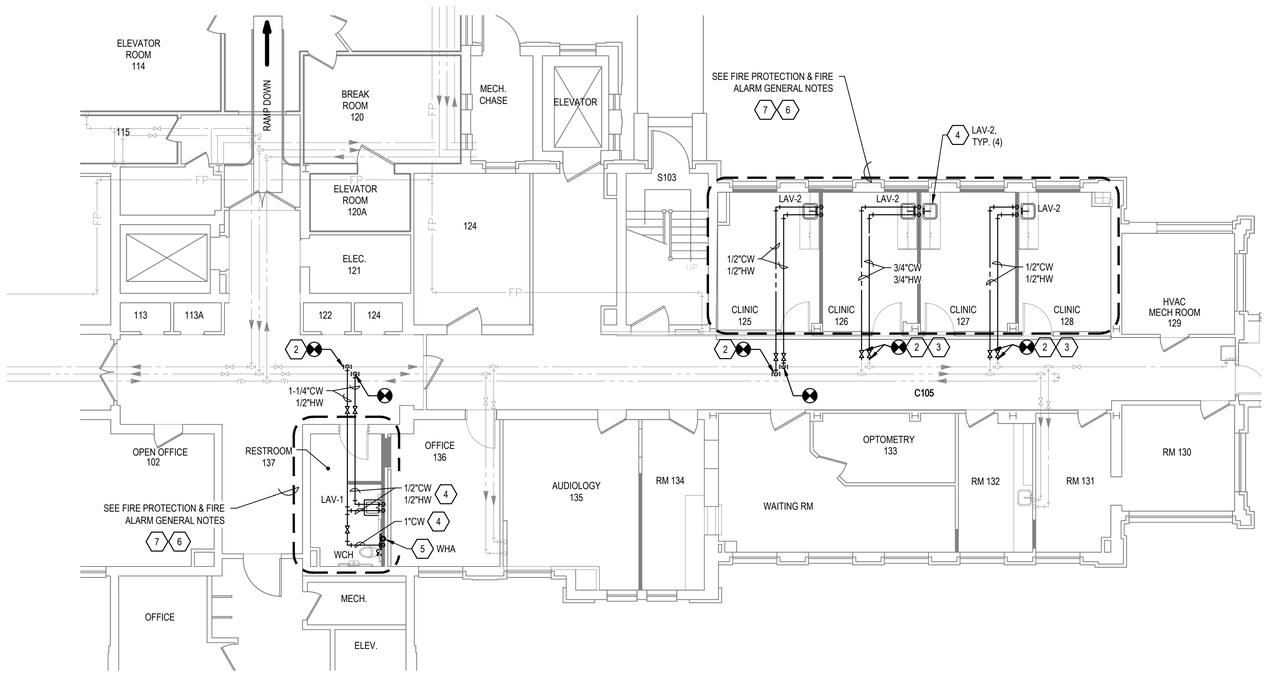

A2 NEW PLUMBING WATER PLAN FIRST FLOOR

1/8" = 1'-0"

KEYED NOTES (X)

1. DISCONNECT WATER SUPPLY PIPING FROM EXISTING PLUMBING FIXTURE, TYPICAL OF (4). DEMO SUPPLY LINE BACK TO SOURCE AND CAP FOR FUTURE USE. REFER TO NEW WORK FOR ADDITIONAL INFORMATION.
2. CONNECT NEW WATER SUPPLY PIPING AND ROUTE TO NEW PLUMBING FIXTURE. SUPPLY PIPE SIZE(S) AS SHOWN ON PLAN.
3. FIELD ASSESS CONDITION OF EXISTING SHUT-OFF VALVE, AND IF REPLACEMENT IS RECOMMENDED.
4. REFER TO SHEET P-5, PLUMBING FIXTURE SCHEDULE FOR PIPE SIZE CONNECTION(S).
5. INSTALL WHA, WATER HAMMER ARRESTOR AT THIS LOCATION. PROVIDE ACCESS PANEL AS REQUIRED. COORDINATE INSTALLATION WITH GC.
6. FIRE PROTECTION CONTRACTOR SHALL ENSURE ROOM MEETS REQUIRED SPRINKLER COVERAGE.
7. ADJUST FIRE SPRINKLER HEAD AS NECESSARY THAT IS IN CONFLICT WITH NEW REFLECTED CEILING PLAN.

FIRE PROTECTION & FIRE ALARM GENERAL NOTES

A. SOUND AND SIGNAL SHOP DRAWINGS SHALL BE PROVIDED TO SHOW EXISTING, NEW OR RELOCATED FIRE ALARM SYSTEM, TO INCLUDE SMOKE DETECTORS AND HORN/CHIME STROBE.

B. FIRE PROTECTION CONTRACTOR TO ENSURE EACH EXAM ROOM MEETS REQUIRED SPRINKLER COVERAGE.

C. EXISTING FIRE SPRINKLER HEADS SHALL REMAIN UNLESS NOTED OTHERWISE. NOTIFY GENERAL CONTRACTOR OF ANY CONFLICTS FOUND IN THE FIELD PRIOR TO DEMOLITION OR NEW WORK.

D. CONTRACTOR SHALL ADJUST LOCATION OF ANY FIRE SPRINKLER HEAD(S) THAT IS IN CONFLICT WITH ANY ASSOCIATED MECHANICAL EQUIPMENT, DUCTWORK, PIPING OR LIGHT FIXTURES. NEW WORK SHALL BE COORDINATED WITH ARCHITECTURAL REFLECTED CEILING PLAN.

Mark	Description	Date	Appr
0	AS-BUILTS	4-22-20	

File Name:
Plot Scale:
Plot Date:
No Accidents and No Tolerance

DESIGN BY: NQM
DRAWN BY: NQM
REVIEWED BY: JA

INDIAN HEALTH SERVICES
ALBUQUERQUE, NEW MEXICO

HUITT-ZOLLARS
GranCor CONSTRUCTION EXCELLENCE

INDIAN HEALTH SERVICES
AIHC 1ST AND 3RD FLOOR INTERIOR RENOVATIONS

WATER DEMO & NEW WORK PLANS FIRST FLOOR

SHEET NO.
P-1

SEQUENCE NO.
SHEET 14 OF 31

C:\Users\fcarrasco\Documents\IHS Optometry Renovation_R18_C_fcarrasco.rvt
2/19/2020 8:44:05 AM

FIRE PROTECTION & FIRE ALARM GENERAL NOTES

A. SOUND AND SIGNAL SHOP DRAWINGS SHALL BE PROVIDED TO SHOW EXISTING, NEW OR RELOCATED FIRE ALARM SYSTEM, TO INCLUDE SMOKE DETECTORS AND HORN/CHIME STROBE.

B. FIRE PROTECTION CONTRACTOR TO ENSURE EACH EXAM ROOM MEETS REQUIRED SPRINKLER COVERAGE.

C. EXISTING FIRE SPRINKLER HEADS SHALL REMAIN UNLESS NOTED OTHERWISE. NOTIFY GENERAL CONTRACTOR OF ANY CONFLICTS FOUND IN THE FIELD PRIOR TO DEMOLITION OR NEW WORK.

D. CONTRACTOR SHALL ADJUST LOCATION OF ANY FIRE SPRINKLER HEAD(S) THAT IS IN CONFLICT WITH ANY ASSOCIATED MECHANICAL EQUIPMENT, DUCTWORK, PIPING OR LIGHT FIXTURES. NEW WORK SHALL BE COORDINATED WITH ARCHITECTURAL REFLECTED CEILING PLAN.

KEYED NOTES (X)

REFER TO SHEET P-0, PLUMBING SYMBOL, LEGEND AND GENERAL PROJECT NOTES.

REFER TO SHEET P-3, PLUMBING DETAILS AND FIXTURE SCHEDULE.

1. EXISTING PIPING TO AND FROM MECHANICAL SHAFT TO REMAIN. ENSURE PIPING IS UNDISTURBED DURING DEMOLITION OR NEW WORK.
2. NEW PLUMBING FIXTURE. REFER TO SHEET P-5, FIXTURE SCHEDULE FOR SPECIFICATION AND PIPE SIZE CONNECTION.
3. CONNECT NEW WATER SUPPLY PIPING FROM BRANCH MAIN AND ROUTE AS INDICATED. SUPPLY PIPE SIZE AS SHOWN ON PLAN. PROVIDE SHUT-OFF VALVE, TYPICAL.
4. CONNECT AND EXTEND WATER SUPPLY PIPING. ROUTING IS DIAGRAMMATIC.
5. INSTALL WHA, WATER HAMMER ARRESTOR AT THIS LOCATION. PROVIDE ACCESS PANEL AS REQUIRED. COORDINATE INSTALLATION WITH GC.
6. FIRE PROTECTION CONTRACTOR SHALL ENSURE ROOM MEETS REQUIRED SPRINKLER COVERAGE.
7. ADJUST FIRE SPRINKLER HEAD AS NECESSARY THAT IS IN CONFLICT WITH NEW REFLECTED CEILING PLAN.
8. CONNECT 3" WASTE TO EXISTING 3" BRANCH. TIE-IN 2" VENT TO EXISTING VENT SYSTEM. COORDINATE ROUTING IN FIELD. PROVIDE ALL REQUIRED FITTINGS.
9. RECONFIGURE EXISTING WASTE AND VENT PIPING FOR INSTALLATION OF NEW EWC-1, ELECTRIC WATER COOLER. REFER TO PLUMBING FIXTURE SCHEDULE FOR ADDITIONAL INFORMATION AND PIPE SIZE CONNECTION(S).
10. EXTEND 1-1/2" VENT TO EXISTING VTR. VERIFY BEST ROUTING IN FIELD.
11. EXISTING FIRE INSPECTOR TEST VALVE.

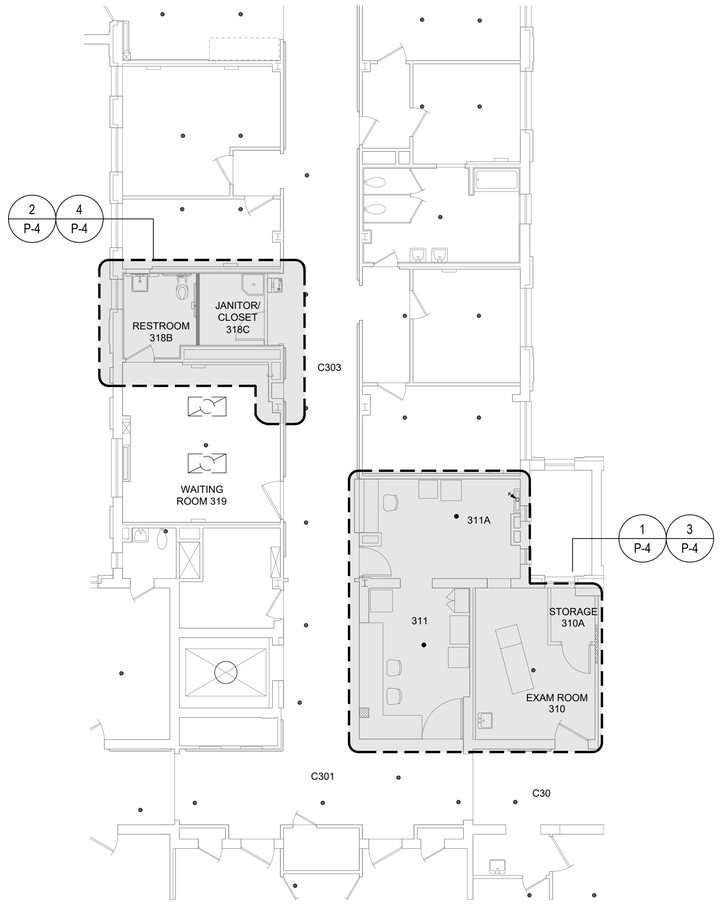

PLUMBING
NEW WORK PLAN - 3RD FLOOR

A1 1/8" = 1'-0"

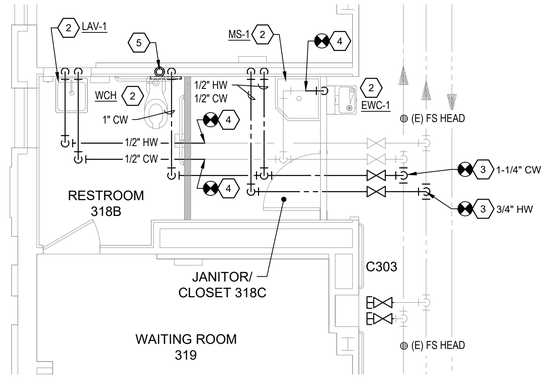

RM 318B, 318C & C303 CORRIDOR
WATER NEW WORK PLAN

2 1/4" = 1'-0"

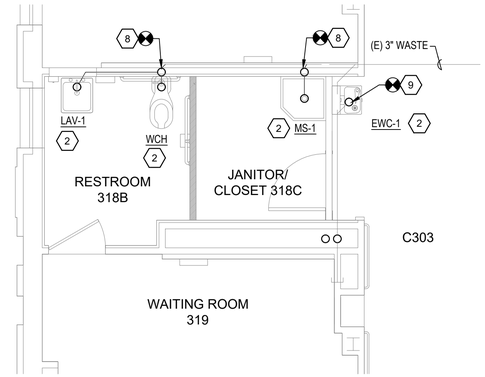

RM 318B, 318C & C303 CORRIDOR
WASTE & VENT NEW WORK PLAN

4 1/4" = 1'-0"

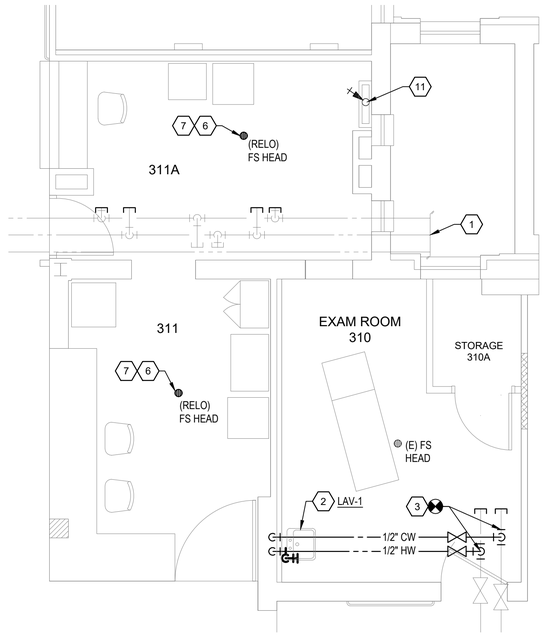

RM 310
WATER NEW WORK PLAN

1 1/4" = 1'-0"

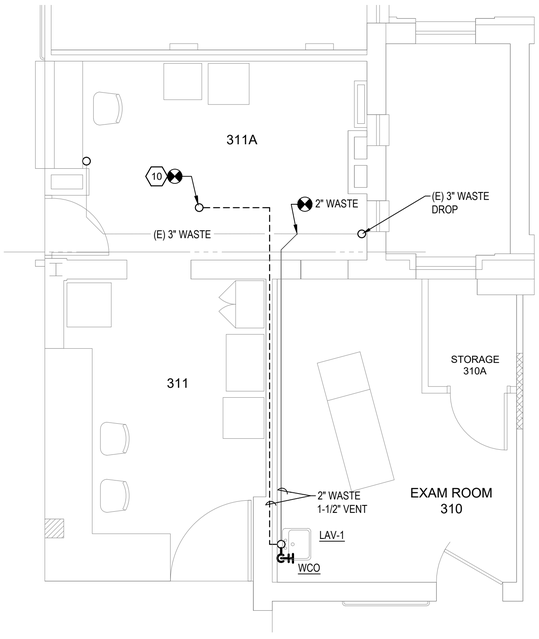

RM 310
WASTE & VENT NEW WORK PLAN

3 1/4" = 1'-0"

Mark	Description	Date	Appr
0	AS-BUILTS	4-22-20	

File Name:
Plot Scale:
Plot Date:
Do not scale drawing. Verify dimensions and report discrepancies before proceeding with work.

DESIGN BY:
DRAWN BY:
REVIEWED BY:

INDIAN HEALTH SERVICES
ALBUQUERQUE, NEW MEXICO

HUITT-ZOLLARS
GranCor Construction Excellence
QA

INDIAN HEALTH SERVICES
AIHC 1ST AND 3RD FLOOR INTERIOR RENOVATIONS
PLUMBING NEW WORK PLANS
THIRD FLOOR

SHEET NO.
P-4

SEQUENCE NO.
SHEET 17 OF 31

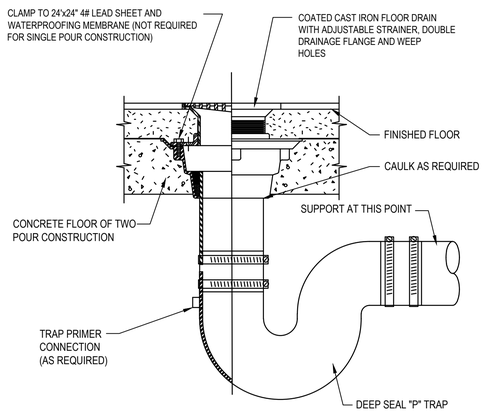

1 / P-3 FLOOR DRAIN DETAIL
SCALE: NONE

PLUMBING FIXTURE SCHEDULE

SYMBOL	DESCRIPTION	ADA	MANUFACTURER AND MODEL	FAUCET MANUFACTURER AND MODEL NUMBER	ACCESSORIES	CONNECTIONS				REMARKS
						CW	HW	WASTE	VENT	
WCH	WATER CLOSET	YES	AMERICAN STANDARD AFWALL MILLENNIUM FLOWISE MODEL 2856.128	SLOAN ECOS HARDWIRE FLUSHOMETER MODEL # 111-1.28	PROVIDE WITH CHURCH 295CT WHITE OPEN FRONT ELONGATED SEAT LESS COVER, J.R. SMITH CONCEALED CARRIER MODEL 0210Y-M54, AND MCGUIRE H166 STOP AND SUPPLY	0'-1 1/4"	-	3"	2"	WALL-HUNG ELONGATED SIPHON JET ACTION BOWL, VITREOUS CHINA, EXPOSED TOP SPUD, 2-1/8" PASSAGEWAY, TOP OF TOILET SEAT AT 18" RIM. COLOR: WHITE
LAV-1	WALL-HUNG LAVATORY	YES	AMERICAN STANDARD LUCERNE 0356.421 - OR- APPROVED EQUAL	ZURN FACUET Z6915-XL, AQUASENSE BATTERY POWERED SINGLE-HOLE DECK FAUCET AT 0.5 GPM, VANDAL RESISTANT AERATOR	PROVIDE GRID DRAIN ASSEMBLY WITH 1-1/4" O.D. TAILPIECE, FLOOR SUPPORTED IN WALL CARRIER WITH CONCEALED ARMS, McQUIRE 2165CCLK SUPPLIES, P-TRAP, TRUEBRO 102/103-W INSULATION KIT	1/2"	1/2"	2"	1-1/2"	21" X 18" VITREOUS CHINA, WALL-HUNG, SELF-DRAINING DECK AREA WITH CONTOURED BACK. LAVATORY WITH CONCEALED ARM CARRIER, CENTER / SINGLE-HOLE ONLY FOR FAUCET. PROVIDE COMPLETE SYSTEM: GRID DRAIN WITH OVERFLOW, (2) ANGLE SUPPLY VALVE WITH STOP AND SUPPLY FLEXIBLE RISER; TRUEBRO LAV GUARD T101W KIT. SEE MANUFACTURE'S ROUGH-IN INSTRUCTIONS PRIOR TO ROUGH-IN FOR PROPER MOUNTING DETAILS. COLOR: WHITE
LAV-2	EXAM ROOM SINK	YES	ELKAY, LRAD1720 TOP MOUNT OFF-CENTERED REAR DRAIN -OR- APPROVED EQUAL	ZURN FAUCET Z6920-XL, AQUASENSE BATTERY POWERED SINGLE-HOLE DECK FAUCET AT 0.5 GPM, VANDAL RESISTANT AERATOR	AERATOR, ELKAY LK500 DRAIN, ANGLE SUPPLY VALVE WITH STOP, SUPPLY FLEXIBLE RISER AND P-TRAP. TRUEBRO LAV GUARD	1/2"	1/2"	2"	1-1/2"	OFF-CENTERED REAR DRAIN 17" x 20" x 6-1/2" DEEP 18 GAUGE, TYPE 304 NICKEL BEARING STAINLESS STEEL, SINGLE COMPARTMENT SINK, SELF-RIMMING, AND COATED UNDERSIDE. SPECIFY SINK WITH 1-HOLES AT 4" CENTERS; GOOSENECK HANDS-FREE BATTERY POWERED FAUCET.
WHA	WATER HAMMER ARRESTOR	-	JAY R. SMITH, 5005 OR APPROVED EQUAL	-	-	-	-	-	-	WATER HAMMER ARRESTOR TO BE SIZED BASED ON QUANTITY OF FIXTURE UNITS SERVED WITHIN A FIXTURE GROUP. STAINLESS STEEL 304 CASING AND BELLOWS CONSTRUCTION, THREADED CONNECTION, PRE-CHARGED, PERMANENTLY SEALED. PIPE SIZE: 1", P.D.I. UNIT RATING: 1-11
FD	FLOOR DRAIN	-	ZURN Z-415	-	TRAP PRIMER SEAL (JR SMITH 2692), TYPE 'B' GRID STRAINER	-	-	2"	1-1/2"	FLOOR DRAIN WITH STRAINER AND ELASTOMERIC TRAP SEAL. SQUARE 6"x 6" INLET STRAINER
WCO	WALL CLEANOUT	N/A	JAY R. SMITH, 4472 OR APPROVED EQUAL	-	-	-	-	-	-	DUCO CAST IRON CLEANOUT TEE AND COUNTERSUNK PLUG WITH STAINLESS STEEL ROUND COVER AND VANDAL PROOF SCREW. SAME SIZE AS SEWER LINE SERVED BY CLEANOUT.

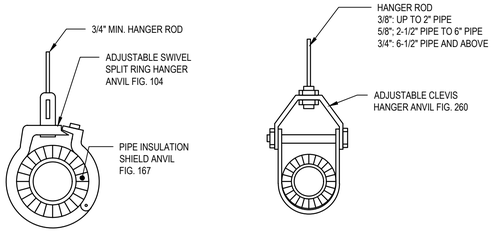

2 / P-3 PIPE SUPPORTS DETAIL
SCALE: NONE

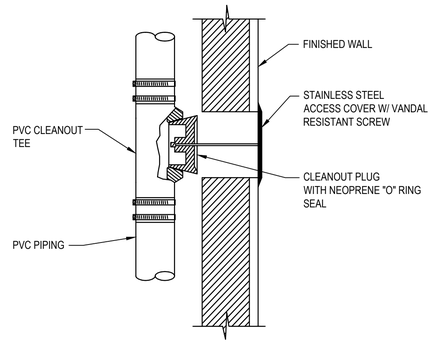

3 / P-3 CLEANOUT THROUGH WALL DETAIL
SCALE: NONE

INDIAN HEALTH SERVICE · IHS · 1955

Mark	Description	Date	Appr
0	AS-BUILTS	4-22-20	

File Name: Plot Scale: Plot Date:
No Accidents Zero Tolerance
DESIGN BY: DRAWN BY: REVIEWED BY:

INDIAN HEALTH SERVICES
ALBUQUERQUE, NEW MEXICO

HUITT-ZOLLARS
GranCor Construction Management
QA ENGINEERING

INDIAN HEALTH SERVICES
AIHC 1ST AND 3RD FLOOR INTERIOR RENOVATIONS

PLUMBING FIXTURE SCHEDULE AND DETAILS

SHEET NO.
P-5

SEQUENCE NO.
SHEET 18 OF 31

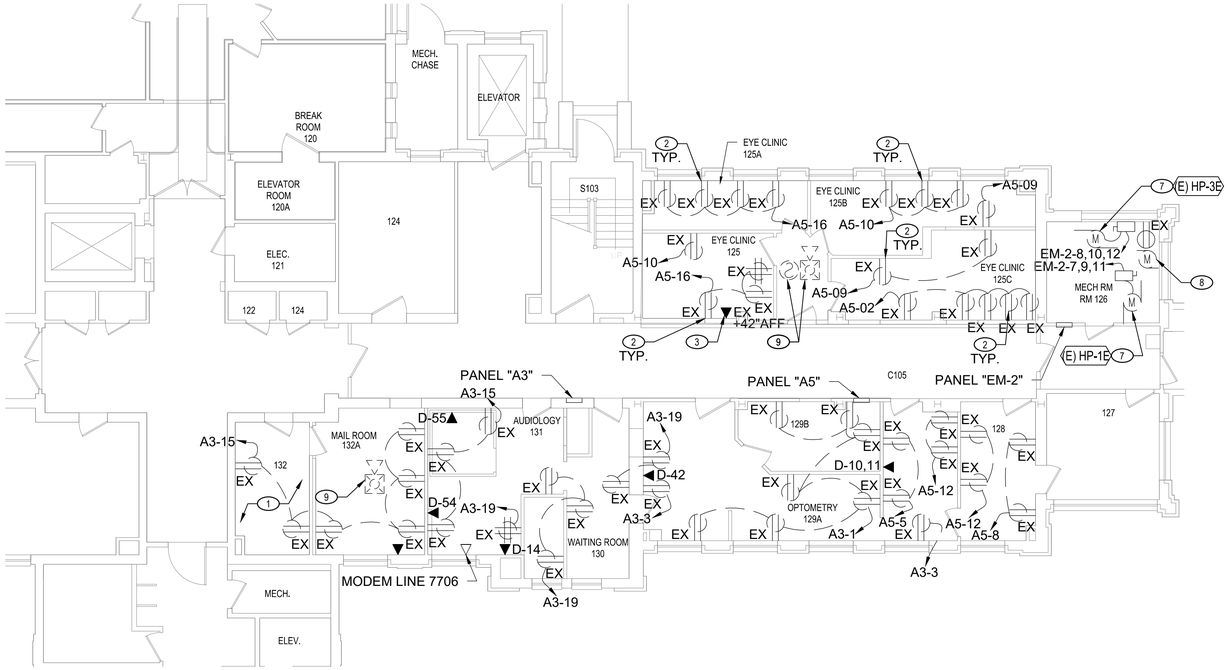

C1 ELECTRICAL DEMOLITION PLAN - LEVEL 1

1/8" = 1'-0"

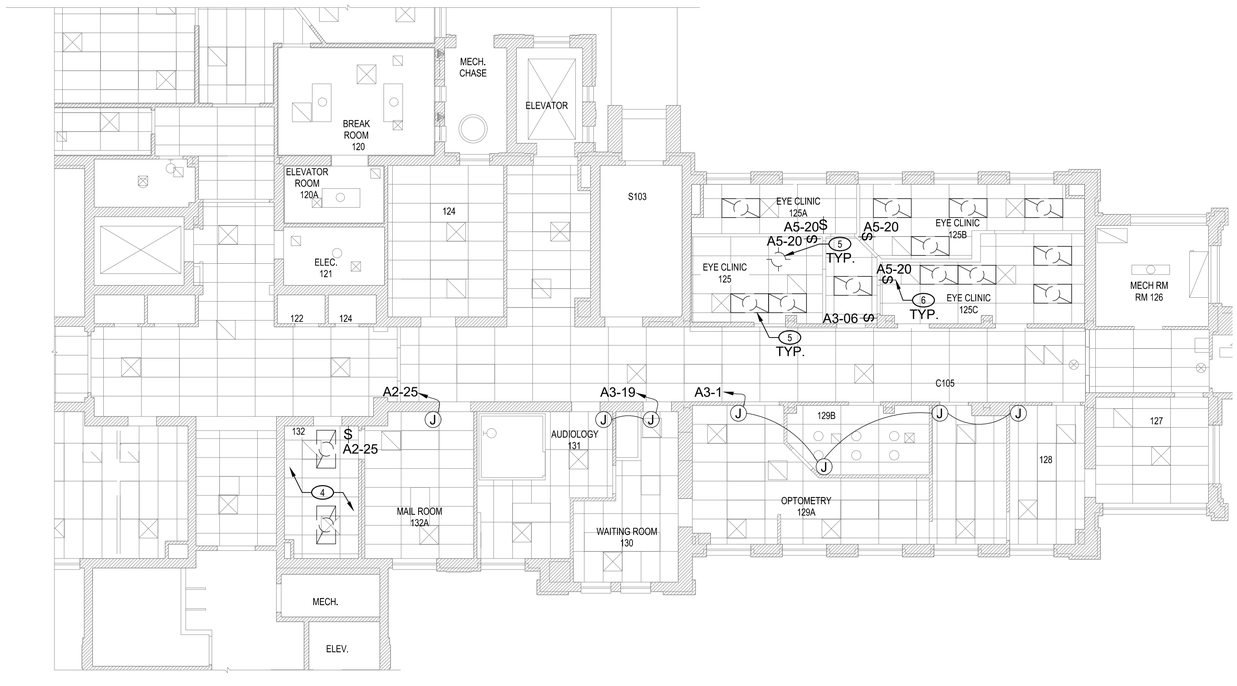

A1 LIGHTING DEMOLITION PLAN - LEVEL 1

1/8" = 1'-0"

SYMBOLS LEGEND

- PANEL AS NOTED
- DISCONNECT SWITCH
- DUPLEX RECEPTACLE 18" AFF U.N.O.
- GFI — DUPLEX RECEPTACLE, GROUND FAULT INTERRUPTER
- EX — EXISTING DUPLEX RECEPTACLE
- DATA OUTLET
- J — JUNCTION BOX
- M — MOTOR
- TOGGLE SWITCH
- 2X4 LIGHT FIXTURE
- FIRE ALARM HORN STROBE COMBINATION
- WALL OR CEILING MOUNTED INTERCONNECTED PHOTOELECTRIC SMOKE DETECTOR/ ALARM WITH BATTERY BACK-UP PER NFPA72, IFC907

GENERAL NOTES

A. THE ELECTRICAL CONTRACTOR SHALL BE RESPONSIBLE FOR COORDINATING AND PROVIDING ALL WORK INDICATED ON THE DRAWINGS, THIS CONSISTS OF FURNISHING ALL LABOR, EQUIPMENT, SUPPLIES, AND MATERIALS IN ADDITION TO PERFORMING ALL OPERATIONS.
B. PERFORM ALL ELECTRICAL WORK IN A NEAT AND WORKMANLIKE MANNER IN FULL COMPLIANCE WITH ALL APPLICABLE CODES AND THE NATIONAL ELECTRICAL CODE (NEC). ALL LOCAL AND STATE REQUIREMENTS SHALL BE OBSERVED DURING THE PERFORMANCE OF THIS WORK.
C. CONTRACTOR SHALL PROMPTLY NOTIFY THE ENGINEER OF ANY AND ALL DISCREPANCIES FOUND BETWEEN CONTRACT DOCUMENTS AND/OR LEGAL OR SAFETY REQUIREMENTS.
D. CONTRACTOR SHALL FOLLOW ALL MANUFACTURER RECOMMENDED INSTALLATION GUIDELINES.
E. CONTRACTOR SHALL FIELD VERIFY EXISTING CONDITIONS PRIOR TO COMMENCING WORK AND NOTIFY ENGINEER OF ANY DISCREPANCIES.
F. ALL CONDUCTORS SHALL BE COPPER, RATED FOR 600 VOLTS WITH TYPE THHN/THWN, 90 DEGREE INSULATION UNLESS OTHERWISE NOTED. MINIMUM WIRE SIZE SHALL BE #12 AWG FOR POWER CIRCUITS. CONDUCTORS SHALL BE SOLID WIRE FOR #12 AWG AND STRANDED FOR #10 AWG OR LARGER. ALL WIRING SHALL BE RUN IN CONDUIT INCLUDING LOW VOLTAGE CONTROL WIRING. SIGNAL WIRING MAY BE RUN IN PVC CONDUIT OR PVC FLEXIBLE TUBING.
G. GENERALLY, CONDUIT SHALL BE EMT, 1/2" MINIMUM. IN AREAS SUBJECT TO DAMAGE CONDUIT SHALL BE RIGID OR IMC TYPE. ALL CONDUIT SHALL BE CONCEALED UNLESS NOTED OTHERWISE.
H. SUPPORT ALL CONDUIT INDEPENDENTLY FROM THE BUILDING STRUCTURE. DO NOT SUPPORT FROM VENTILATION DUCTS, MECHANICAL PIPING, SUSPENDED CEILING GRIDS, OR THEIR HANGERS. USE NEC ACCEPTABLE METHODS OF SUPPORT.
I. INSTALL EXTERIOR WIRING AND DEVICES IN CONDUIT WITH WEATHERPROOF FITTINGS AND IN WEATHERPROOF BOXES. ALL DEVICES AND EQUIPMENT SHALL BE RATED FOR EXTERIOR USE.
J. MAINTAIN A MINIMUM OF 24 INCH SEPARATION BETWEEN POWER CONDUITS AND SIGNAL CONDUITS AS PRACTICAL. ROUTE CONDUITS TO NOT CROSS EACH OTHER. EXPOSED CONDUIT AND DEVICE BOXES IN ALL AREAS FOR COMMUNICATION AND POWER.
K. ALL RECEPTACLES TO BE MOUNTED AT 18" ABOVE FINISH FLOOR UNLESS NOTED OTHERWISE.

DEMOLITION KEYED NOTES (X)

1. DISCONNECT AND REMOVE ALL EXISTING RECEPTACLES IN THIS SPACE. REMOVE CONDUIT AND WIRE BACK TO NEAREST JUNCTION BOX.
2. DISCONNECT AND REMOVE EXISTING RECEPTACLE. REMOVE CONDUIT AND WIRE BACK TO NEAREST JUNCTION BOX.
3. DISCONNECT AND REMOVE DATA OUTLET.
4. DISCONNECT AND REMOVE ALL EXISTING LIGHT FIXTURES IN THIS SPACE. REMOVE CONDUIT AND WIRE BACK TO NEAREST JUNCTION BOX.
5. DISCONNECT AND REMOVE EXISTING LIGHT FIXTURE.
6. DISCONNECT AND REMOVE EXISTING TOGGLE SWITCH.
7. DISCONNECT HEAT PUMP AND DISCONNECT SWITCH. RETAIN DISCONNECT SWITCH, CONDUCTORS, AND CONDUIT FOR RELOCATION.
8. DISCONNECT MOTOR AND CONDUIT FOR MOTORIZED DAMPER FOR RELOCATION TO WALL.
9. DISCONNECT AND REMOVE FIRE ALARM DEVICE.

INDIAN HEALTH SERVICE · IHS · 1955 ·

Mark	Description	Date	Appr
0	AS-BUILTS	4-22-20	

File Name: Plot Scale: Plot Date:
Errors & Omissions Subject to Tolerance

DESIGN BY: W.B. DRAWN BY: W.B. REVIEWED BY: J.C.A.

INDIAN HEALTH SERVICES
ALBUQUERQUE, NEW MEXICO

HUITT-ZOLLARS
GranCor Construction Management
QA Engineering

INDIAN HEALTH SERVICES
AIHC 1ST AND 3RD FLOOR INTERIOR RENOVATIONS

ELECTRICAL DEMOLITION PLANS

SHEET NO. E-1

SEQUENCE NO. SHEET 19 OF 31

C:\Users\fcarrasco\Documents\IHS Optometry Renovation_R18_C_fcarrasco.rvt

2/19/2020 8:44:05 AM

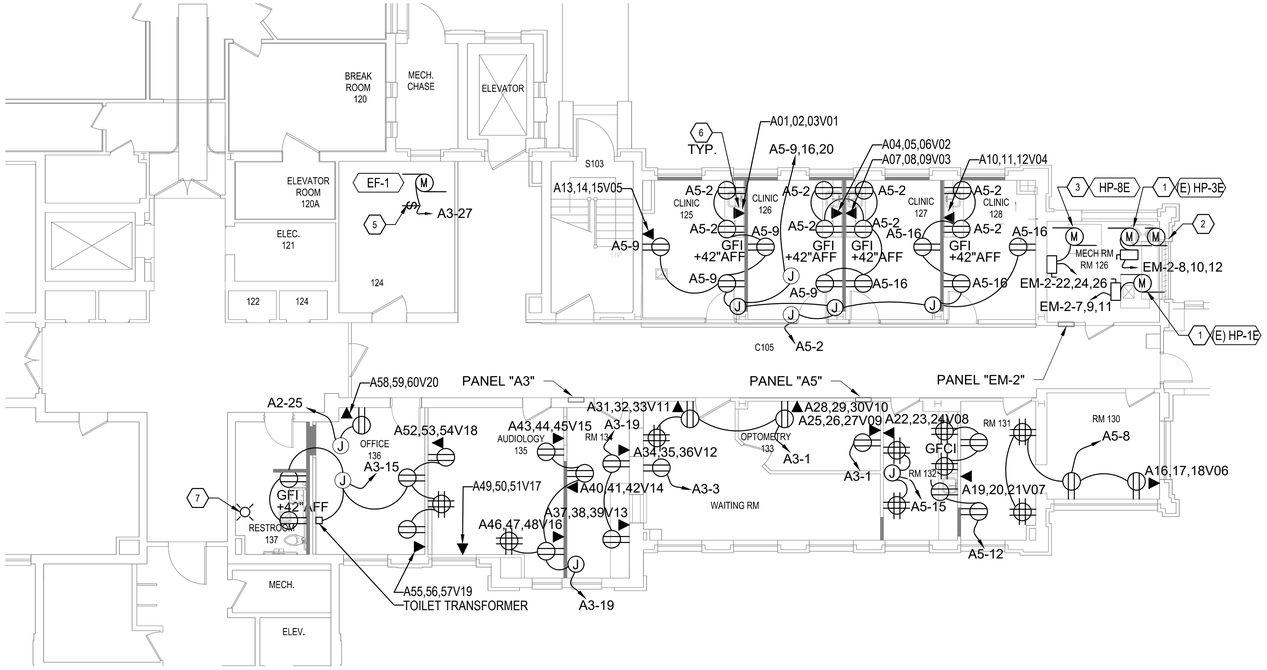

C1 NEW ELECTRICAL PLAN - LEVEL 1

1/8" = 1'-0"

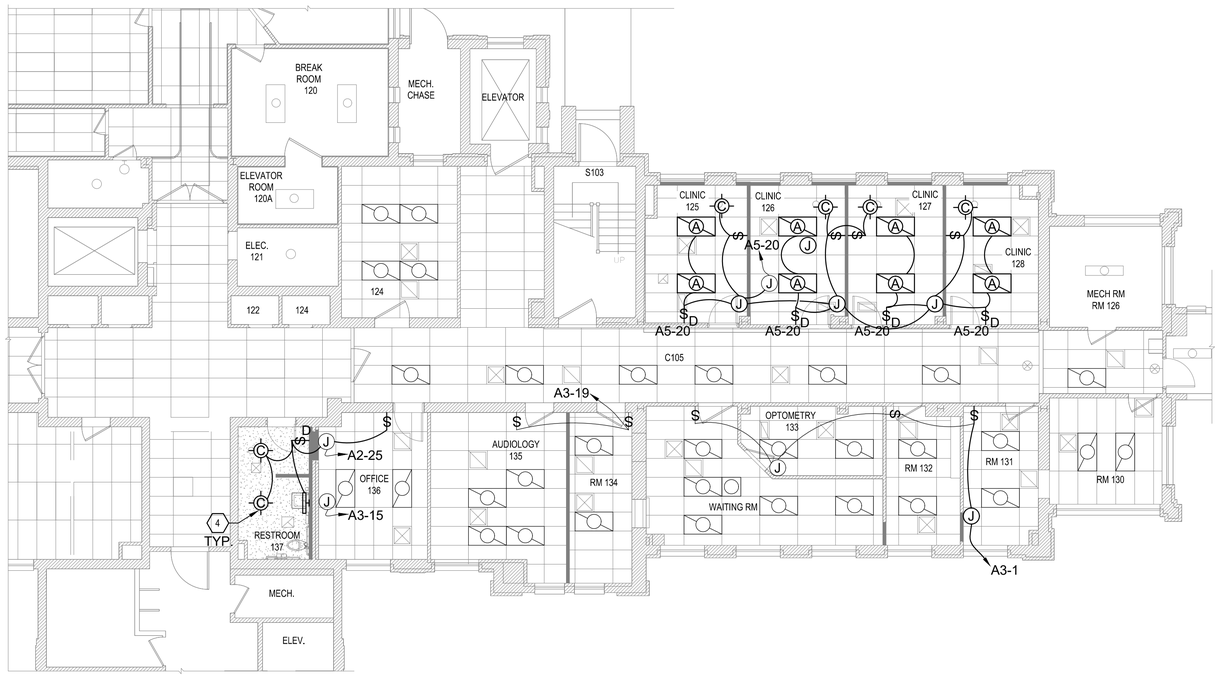

A1 NEW LIGHTING PLAN - LEVEL 1

1/8" = 1'-0"

SYMBOLS LEGEND

- PANEL AS NOTED
- DISCONNECT SWITCH
- DUPLEX RECEPTACLE 18" AFF U.N.O.
- GFI — DUPLEX RECEPTACLE, GROUND FAULT INTERRUPTER
- EX — EXISTING DUPLEX RECEPTACLE
- DATA OUTLET
- J — JUNCTION BOX
- M — MOTOR
- TOGGLE SWITCH
- D — DIMMER SWITCH
- A — 2X4 LIGHT FIXTURE
- C — RECESSED CAN
- WALL VANITY
- FIRE ALARM HORN STROBE COMBINATION
- WALL OR CEILING MOUNTED INTERCONNECTED PHOTOELECTRIC SMOKE DETECTOR/ ALARM WITH BATTERY BACK-UP PER NFPA72, IFC907
- FIRE ALARM STROBE

ROOM #105

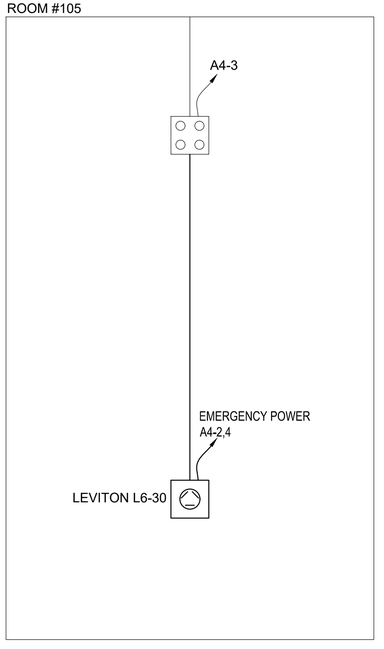

GENERAL NOTES

A. THE ELECTRICAL CONTRACTOR SHALL BE RESPONSIBLE FOR COORDINATING AND PROVIDING ALL WORK INDICATED ON THE DRAWINGS, THIS CONSISTS OF FURNISHING ALL LABOR, EQUIPMENT, SUPPLIES, AND MATERIALS IN ADDITION TO PERFORMING ALL OPERATIONS.
B. PERFORM ALL ELECTRICAL WORK IN A NEAT AND WORKMANLIKE MANNER IN FULL COMPLIANCE WITH ALL APPLICABLE CODES AND THE NATIONAL ELECTRICAL CODE (NEC). ALL LOCAL AND STATE REQUIREMENTS SHALL BE OBSERVED DURING THE PERFORMANCE OF THIS WORK.
C. CONTRACTOR SHALL PROMPTLY NOTIFY THE ENGINEER OF ANY AND ALL DISCREPANCIES FOUND BETWEEN CONTRACT DOCUMENTS AND/OR LEGAL OR SAFETY REQUIREMENTS.
D. CONTRACTOR SHALL FOLLOW ALL MANUFACTURER RECOMMENDED INSTALLATION GUIDELINES.
E. CONTRACTOR SHALL FIELD VERIFY EXISTING CONDITIONS PRIOR TO COMMENCING WORK AND NOTIFY ENGINEER OF ANY DISCREPANCIES.
F. ALL CONDUCTORS SHALL BE COPPER, RATED FOR 600 VOLTS WITH TYPE THHN/THWN, 90 DEGREE INSULATION UNLESS OTHERWISE NOTED. MINIMUM WIRE SIZE SHALL BE #12 AWG FOR POWER CIRCUITS. CONDUCTORS SHALL BE SOLID WIRE FOR #12 AWG AND STRANDED FOR #10 AWG OR LARGER. ALL WIRING SHALL BE RUN IN CONDUIT INCLUDING LOW VOLTAGE CONTROL WIRING. SIGNAL WIRING MAY BE RUN IN PVC CONDUIT OR PVC FLEXIBLE TUBING.
G. GENERALLY, CONDUIT SHALL BE EMT, 1/2" MINIMUM. IN AREAS SUBJECT TO DAMAGE CONDUIT SHALL BE RIGID OR IMC TYPE. ALL CONDUIT SHALL BE CONCEALED UNLESS NOTED OTHERWISE.
H. SUPPORT ALL CONDUIT INDEPENDENTLY FROM THE BUILDING STRUCTURE. DO NOT SUPPORT FROM VENTILATION DUCTS, MECHANICAL PIPING, SUSPENDED CEILING GRIDS, OR THEIR HANGERS. USE NEC ACCEPTABLE METHODS OF SUPPORT.
I. INSTALL EXTERIOR WIRING AND DEVICES IN CONDUIT WITH WEATHERPROOF FITTINGS AND IN WEATHERPROOF BOXES. ALL DEVICES AND EQUIPMENT SHALL BE RATED FOR EXTERIOR USE.
J. MAINTAIN A MINIMUM OF 24 INCH SEPARATION BETWEEN POWER CONDUITS AND SIGNAL CONDUITS AS PRACTICAL. ROUTE CONDUITS TO NOT CROSS EACH OTHER. EXPOSED CONDUIT AND DEVICE BOXES IN ALL AREAS FOR COMMUNICATION AND POWER.
K. ALL RECEPTACLES TO BE MOUNTED AT 18" ABOVE FINISH FLOOR UNLESS NOTED OTHERWISE.

KEYED NOTES (X)

1. INSTALL EXISTING HEAT PUMP AND DISCONNECT SWITCH. EXTEND EXISTING CONDUCTORS AND CONDUIT FOR RELOCATION AS REQUIRED. RECONNECT TO EXISTING BRANCH CIRCUIT.
2. INSTALL EXISTING MOTOR AND CONDUIT FOR MOTORIZED DAMPER FOR RELOCATION TO WALL.
3. INSTALL NEW HEAT PUMP (HP-8).
4. CONNECT NEW LIGHT FIXTURE TO EXISTING LIGHTING BRANCH CIRCUIT IN SPACE.
5. EF-1 TOGGLE DISCONNECT SWITCH MOUNTED TO UNIT ENCLOSURE.
6. DATA TO TERMINATE IN 1ST FLOOR WEST WING ROOM 105B.
7. PROVIDE AND INSTALL FIRE ALARM STROBE.

INDIAN HEALTH SERVICE · IHS · 1955

Mark	Description	Date	Appr
0	AS-BUILTS	4-22-20	

File Name: Plot Scale: Plot Date:
Be on the Lookout for Accidents and Slippery Conditions

DESIGN BY: W.B.
DRAWN BY: W.B.
REVIEWED BY: J.C.A.

INDIAN HEALTH SERVICES
ALBUQUERQUE, NEW MEXICO

HUITT-ZOLLARS ENGINEERS
GranCor CONSTRUCTION MANAGEMENT
QA

INDIAN HEALTH SERVICES
AIHC 1ST AND 3RD FLOOR INTERIOR RENOVATIONS

ELECTRICAL NEW WORK PLANS

SHEET NO.
E-2

SEQUENCE NO.
SHEET 20 OF 31

C:\Users\fcarrasco\Documents\IHS Optometry Renovation_R18_C_fcarrasco.rvt
2/19/2020 8:44:05 AM

SYMBOLS LEGEND

	DUPLEX RECEPTACLE 18" AFF U.N.O.
GFI	DUPLEX RECEPTACLE, GROUND FAULT INTERRUPTER
EX	EXISTING DUPLEX RECEPTACLE
EX	EXISTING FOURPLEX RECEPTACLE
J	JUNCTION BOX

SYMBOLS LEGEND

S	TOGGLE SWITCH
S D	DIMMER SWITCH
A	2X4 LIGHT FIXTURE
C	RECESSED CAN
	EXIT SIGN
	FIRE ALARM HORN STROBE COMBINATION
	WALL OR CEILING MOUNTED INTERCONNECTED PHOTOELECTRIC SMOKE DETECTOR/ ALARM WITH BATTERY BACK-UP PER NFPA72, IFC907
	FIRE ALARM STROBE

GENERAL NOTES

A. THE ELECTRICAL CONTRACTOR SHALL BE RESPONSIBLE FOR COORDINATING AND PROVIDING ALL WORK INDICATED ON THE DRAWINGS, THIS CONSISTS OF FURNISHING ALL LABOR, EQUIPMENT, SUPPLIES, AND MATERIALS IN ADDITION TO PERFORMING ALL OPERATIONS.
B. PERFORM ALL ELECTRICAL WORK IN A NEAT AND WORKMANLIKE MANNER IN FULL COMPLIANCE WITH ALL APPLICABLE CODES AND THE NATIONAL ELECTRICAL CODE (NEC). ALL LOCAL AND STATE REQUIREMENTS SHALL BE OBSERVED DURING THE PERFORMANCE OF THIS WORK.
C. CONTRACTOR SHALL PROMPTLY NOTIFY THE ENGINEER OF ANY AND ALL DISCREPANCIES FOUND BETWEEN CONTRACT DOCUMENTS AND/OR LEGAL OR SAFETY REQUIREMENTS.
D. CONTRACTOR SHALL FOLLOW ALL MANUFACTURER RECOMMENDED INSTALLATION GUIDELINES.
E. CONTRACTOR SHALL FIELD VERIFY EXISTING CONDITIONS PRIOR TO COMMENCING WORK AND NOTIFY ENGINEER OF ANY DISCREPANCIES.
F. ALL CONDUCTORS SHALL BE COPPER, RATED FOR 600 VOLTS WITH TYPE THHN/THWN, 90 DEGREE INSULATION UNLESS OTHERWISE NOTED. MINIMUM WIRE SIZE SHALL BE #12 AWG FOR POWER CIRCUITS. CONDUCTORS SHALL BE SOLID WIRE FOR #12 AWG AND STRANDED FOR #10 AWG OR LARGER. ALL WIRING SHALL BE RUN IN CONDUIT INCLUDING LOW VOLTAGE CONTROL WIRING. SIGNAL WIRING MAY BE RUN IN PVC CONDUIT OR PVC FLEXIBLE TUBING.
G. GENERALLY, CONDUIT SHALL BE EMT, 1/2" MINIMUM. IN AREAS SUBJECT TO DAMAGE CONDUIT SHALL BE RIGID OR IMC TYPE. ALL CONDUIT SHALL BE CONCEALED UNLESS NOTED OTHERWISE.
H. SUPPORT ALL CONDUIT INDEPENDENTLY FROM THE BUILDING STRUCTURE. DO NOT SUPPORT FROM VENTILATION DUCTS, MECHANICAL PIPING, SUSPENDED CEILING GRIDS, OR THEIR HANGERS. USE NEC ACCEPTABLE METHODS OF SUPPORT.
I. INSTALL EXTERIOR WIRING AND DEVICES IN CONDUIT WITH WEATHERPROOF FITTINGS AND IN WEATHERPROOF BOXES. ALL DEVICES AND EQUIPMENT SHALL BE RATED FOR EXTERIOR USE.
J. MAINTAIN A MINIMUM OF 24 INCH SEPARATION BETWEEN POWER CONDUITS AND SIGNAL CONDUITS AS PRACTICAL. ROUTE CONDUITS TO NOT CROSS EACH OTHER. EXPOSED CONDUIT AND DEVICE BOXES IN ALL AREAS FOR COMMUNICATION AND POWER.
K. ALL RECEPTACLES TO BE MOUNTED AT 18" ABOVE FINISH FLOOR UNLESS NOTED OTHERWISE.

DEMOLITION KEYED NOTES (X)

1. DISCONNECT AND REMOVE EXISTING RECEPTACLE. REMOVE CONDUIT AND WIRE BACK TO NEAREST JUNCTION BOX.
2. DISCONNECT AND REMOVE EXISTING LIGHT FIXTURE. REMOVE CONDUIT AND WIRE BACK TO NEAREST JUNCTION BOX. RETAIN BRANCH CIRCUIT FOR REUSE.
3. DISCONNECT AND REMOVE EXISTING TOGGLE SWITCH. RETAIN BRANCH CIRCUIT FOR REUSE.
4. DISCONNECT AND REMOVE FIRE ALARM DEVICE.
5. DISCONNECT AND REMOVE EXISTING RECEPTACLE FOR RELOCATION. RETAIN CONDUIT, WIRE, AND BRANCH CIRCUIT.
6. DISCONNECT AND REMOVE TOGGLE SWITCH FOR RELOCATION. RETAIN CONDUIT, WIRE, AND BRANCH CIRCUIT.
7. DISCONNECT AND REMOVE POWER FOR EXISTING ELECTRIC WATER COOLER. RETAIN WIRING AND BRANCH CIRCUIT FOR RELOCATION.

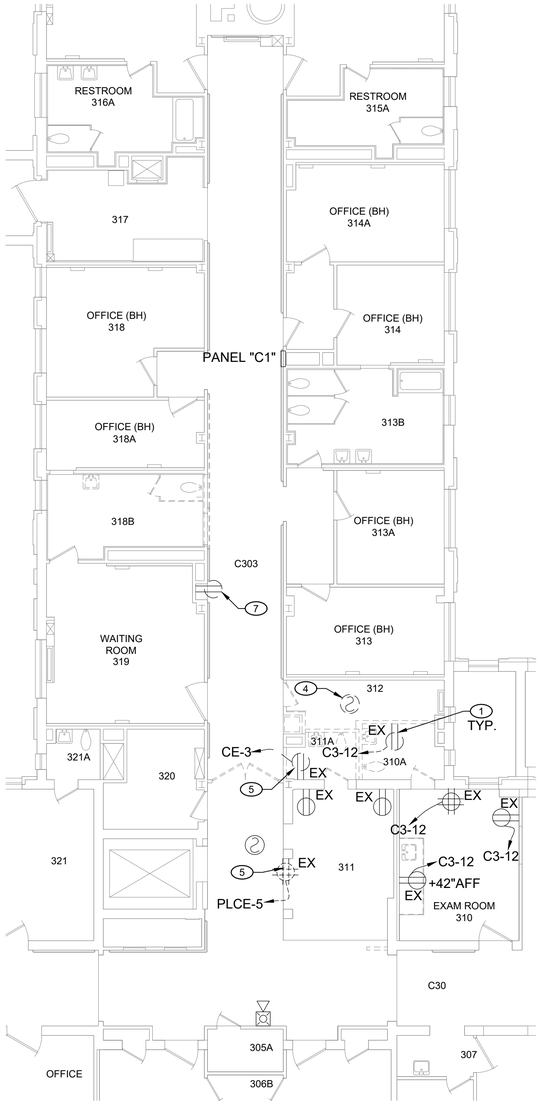

A1 ELECTRICAL DEMOLITION PLAN - LEVEL 3

1/8" = 1'-0"

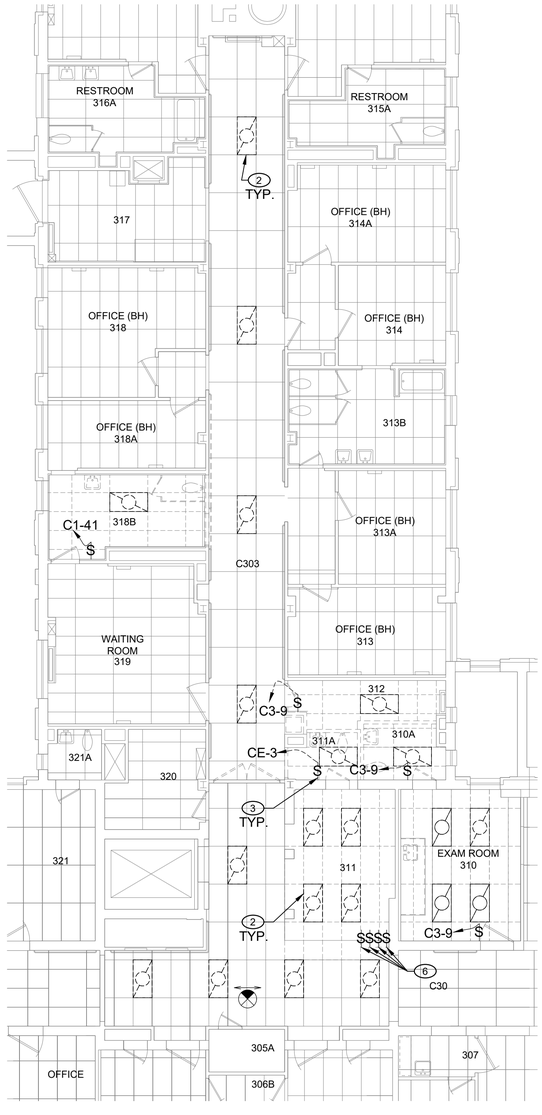

A3 LIGHTING DEMOLITION PLAN - LEVEL 3

1/8" = 1'-0"

INDIAN HEALTH SERVICE · IHS · 1955 ·

Mark	Description	Date	Appr
0	AS-BUILTS	7-01-21	

File Name:
Plot Scale:
Plot Date:
No Accidents and Tolerance

DESIGN BY: W.B.
DRAWN BY: W.B.
REVIEWED BY: J.C.A.

INDIAN HEALTH SERVICES
ALBUQUERQUE, NEW MEXICO

HUITT-ZOLLARS
GranCor Construction Excellence
QA Engineering

INDIAN HEALTH SERVICES
AIHC 1ST AND 3RD FLOOR INTERIOR RENOVATIONS

ELECTRICAL DEMOLITION PLANS

SHEET NO.
E-3

SEQUENCE NO.
SHEET 21 OF 31

SYMBOLS LEGEND

- DUPLEX RECEPTACLE 18" AFF U.N.O.
- GFI — DUPLEX RECEPTACLE, GROUND FAULT INTERRUPTER
- EX — EXISTING DUPLEX RECEPTACLE
- EX — EXISTING FOURPLEX RECEPTACLE
- J — JUNCTION BOX
- DATA OUTLET
- WALL VANITY
- L6-30/ 208V TWIST LOCK RECEPTACLE

SYMBOLS LEGEND

- TOGGLE SWITCH
- D — DIMMER SWITCH
- A — 2X4 LIGHT FIXTURE
- A — 2X4 EMERGENCY LIGHT FIXTURE
- C — RECESSED CAN
- EXIT SIGN
- FIRE ALARM HORN STROBE COMBINATION
- WALL OR CEILING MOUNTED INTERCONNECTED PHOTOELECTRIC SMOKE DETECTOR/ ALARM WITH BATTERY BACK-UP PER NFPA72, IFC907
- FIRE ALARM STROBE

GENERAL NOTES

A. THE ELECTRICAL CONTRACTOR SHALL BE RESPONSIBLE FOR COORDINATING AND PROVIDING ALL WORK INDICATED ON THE DRAWINGS, THIS CONSISTS OF FURNISHING ALL LABOR, EQUIPMENT, SUPPLIES, AND MATERIALS IN ADDITION TO PERFORMING ALL OPERATIONS.
B. PERFORM ALL ELECTRICAL WORK IN A NEAT AND WORKMANLIKE MANNER IN FULL COMPLIANCE WITH ALL APPLICABLE CODES AND THE NATIONAL ELECTRICAL CODE (NEC). ALL LOCAL AND STATE REQUIREMENTS SHALL BE OBSERVED DURING THE PERFORMANCE OF THIS WORK.
C. CONTRACTOR SHALL PROMPTLY NOTIFY THE ENGINEER OF ANY AND ALL DISCREPANCIES FOUND BETWEEN CONTRACT DOCUMENTS AND/OR LEGAL OR SAFETY REQUIREMENTS.
D. CONTRACTOR SHALL FOLLOW ALL MANUFACTURER RECOMMENDED INSTALLATION GUIDELINES.
E. CONTRACTOR SHALL FIELD VERIFY EXISTING CONDITIONS PRIOR TO COMMENCING WORK AND NOTIFY ENGINEER OF ANY DISCREPANCIES.
F. ALL CONDUCTORS SHALL BE COPPER, RATED FOR 600 VOLTS WITH TYPE THHN/THWN, 90 DEGREE INSULATION UNLESS OTHERWISE NOTED. MINIMUM WIRE SIZE SHALL BE #12 AWG FOR POWER CIRCUITS. CONDUCTORS SHALL BE SOLID WIRE FOR #12 AWG AND STRANDED FOR #10 AWG OR LARGER. ALL WIRING SHALL BE RUN IN CONDUIT INCLUDING LOW VOLTAGE CONTROL WIRING. SIGNAL WIRING MAY BE RUN IN PVC CONDUIT OR PVC FLEXIBLE TUBING.
G. GENERALLY, CONDUIT SHALL BE EMT, 1/2" MINIMUM. IN AREAS SUBJECT TO DAMAGE CONDUIT SHALL BE RIGID OR IMC TYPE. ALL CONDUIT SHALL BE CONCEALED UNLESS NOTED OTHERWISE.
H. SUPPORT ALL CONDUIT INDEPENDENTLY FROM THE BUILDING STRUCTURE. DO NOT SUPPORT FROM VENTILATION DUCTS, MECHANICAL PIPING, SUSPENDED CEILING GRIDS, OR THEIR HANGERS. USE NEC ACCEPTABLE METHODS OF SUPPORT.
I. INSTALL EXTERIOR WIRING AND DEVICES IN CONDUIT WITH WEATHERPROOF FITTINGS AND IN WEATHERPROOF BOXES. ALL DEVICES AND EQUIPMENT SHALL BE RATED FOR EXTERIOR USE.
J. MAINTAIN A MINIMUM OF 24 INCH SEPARATION BETWEEN POWER CONDUITS AND SIGNAL CONDUITS AS PRACTICAL. ROUTE CONDUITS TO NOT CROSS EACH OTHER. EXPOSED CONDUIT AND DEVICE BOXES IN ALL AREAS FOR COMMUNICATION AND POWER.
K. ALL RECEPTACLES TO BE MOUNTED AT 18" ABOVE FINISH FLOOR UNLESS NOTED OTHERWISE.

KEYED NOTES (X)

1. PROVIDE AND INSTALL RECEPTACLE.
2. REPLACE EXISTING LIGHT FIXTURE. REUSE EXISTING LIGHTING BRANCH CIRCUIT AND SWITCHING.
3. PROVIDE AND INSTALL TOGGLE SWITCH.
4. REINSTALL EXISTING TOGGLE SWITCH WITH EXISTING BRANCH CIRCUIT AND WIRING. MAINTAIN EXISTING SWITCH FUNCTIONALITY.
5. REINSTALL EXISTING RECEPTACLE .
6. PROVIDE AND INSTALL DATA OUTLET.
7. REINSTALL EXISTING FIXTURE IN NEW CEILING GRID. REUSE EXISTING BRANCH CIRCUIT AND SWITCHING.
8. CHANGE TOGGLE SWITCH THAT CONTROLS 2X4 FIXTURES IN ROOM 311 TO DIMMER SWITCH.
9. PROVIDE AND INSTALL LIGHT FIXTURE. SWITCH FIXTURE AS INDICATED.
10. EXTEND CONDUIT AND WIRE AS REQUIRED TO RE-USE EXISTING ELECTRIC WATER COOLER BRANCH CIRCUIT.
11. COORDINATE CONDUIT ROUTING WITH FIRE INSPECTOR TEST PORT IN WALL.

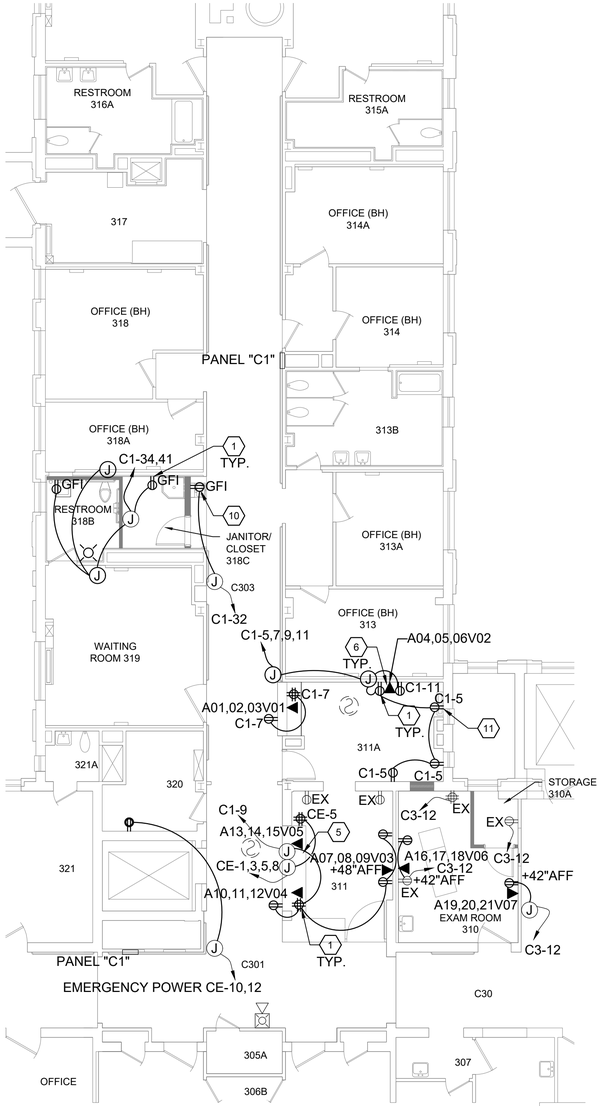

A1 NEW ELECTRICAL PLAN - LEVEL 3

1/8" = 1'-0"

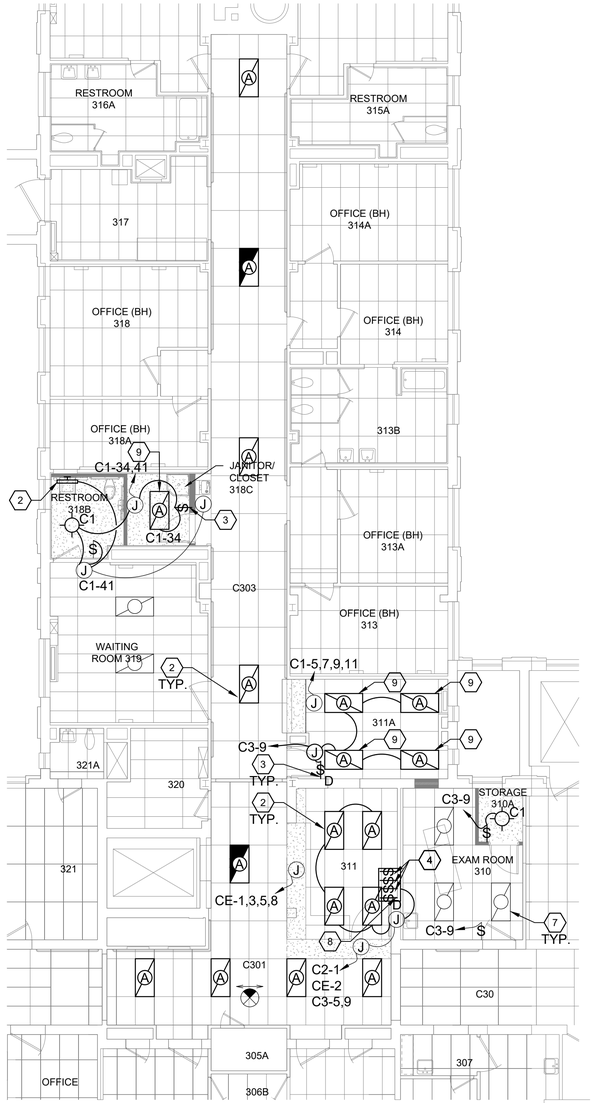

A3 NEW LIGHTING PLAN - LEVEL 3

1/8" = 1'-0"

INDIAN HEALTH SERVICE · IHS · 1955 ·

Mark	Description	Date	Appr
0	AS-BUILTS	7-01-21	

File Name:
Plot Scale:
Plot Date:
Plan Accidents are Tolerance

DESIGN BY: W.B.
DRAWN BY: W.B.
REVIEWED BY: J.C.A.

INDIAN HEALTH SERVICES
ALBUQUERQUE, NEW MEXICO

HUITT-ZOLLARS
GranCor Construction Excellence

INDIAN HEALTH SERVICES
AIHC 1ST AND 3RD FLOOR INTERIOR RENOVATIONS

ELECTRICAL NEW WORK PLANS

SHEET NO.
E-4

SEQUENCE NO.
SHEET 22 OF 31

LUMINAIRE SCHEDULE

1. ABBREVIATIONS: C=CEILING; P=PENDANT; R=RECESSED; S=SURFACE; T=TRACK; W =W ALL; AI=AS INDICATED; CB=CONCRETE BASE.
2. SINGLE NUMERAL PREFIX IN LAMP COLUMN INDICATES NUMBER OF LAMPS IN LUMINAIRE (e.g., (2) F32T8/SPX35/ECO).
3. LAMPS ARE SPECIFIED BY MFG'S LAMP ORDERING CODE, NOT ANSI CODE NUMBER. LAMPS LISTED ARE OSRAM SYLVANIA UNLESS OTHERW ISE NOTED.
4. MANUFACTURER AND CATALOG NUMBER LISTED ARE PRIMARY SPECIFICATION AND INDICATE DESIGN INTENT. ALTERNATE MANUFACTURERS ARE GIVEN BY NAME ONLY. IF MANUFACTURER IS NOT LISTED, THEY SHALL COMPLY W ITH THE SUBSTITUTION SECTION OF THE SPECIFICATIONS.
5. " * * " DENOTES MANUFACTURER'S CATALOG NUMBER LISTING FOR CEILING TYPE MOUNTING OPTION. CONTRACTOR SHALL COORDINATE W ITH FINAL APPROVED CEILING FINISH PRIOR TO ORDERING.
6. FIRST NAMED MANUFACTURER AND CATALOG NUMBER CONSTITUTE BASIS OF DESIGN. ALTERNATE MANUFACTURERS SUBMITTED MUST MEET CONSTRUCTION, OPERABILITY, PHOTOMETRIC AND AESTHETIC CRITERIA SET FORTH BY BASIS OF DESIGN PUBLISHED INFORMATION.

TYPE	MANUFACTURER/#	ALTERNATE MFG'R	DESCRIPTION	MTG.	LAMPING	VOLTS	WATTS
A	**WILLIAMS LT-24-L40-840-DIM-UNV**	APPROVED EQUAL	2X4 LED TROFFER,3,972 DELIVERED LUMENS, INTEGRAL ELECTRONIC DRIVER, 4000K	R	INTEGRAL LED	UNV	32
C	**WILLIAMS 6DR-TL-L15-840-DIM-UNV-OW-OF-CS**	APPROVED EQUAL	6" ROUND DOWNLIGHT WITH TRIMLOCK RELECTOR RETENTION SYSTEM, 1,497 DELIVERED LUMENS, INTEGRAL ELECTRONIC DRIVER, 4000K	R	INTEGRAL LED	UNV	13.8
C1	**WILLIAMS 6DR-TL-L15-830-DIM-UNV-OW-OF-CS**	APPROVED EQUAL	6" ROUND DOWNLIGHT WITH TRIMLOCK RELECTOR RETENTION SYSTEM, 1,497 DELIVERED LUMENS, INTEGRAL ELECTRONIC DRIVER, 3000K	R	INTEGRAL LED	UNV	13.8
V	**KUZCO 601001-LED**	APPROVED EQUAL	26"VANITY, OPAL LENS, 1,503 DELIVERED LUMENS, INTEGRAL ELECTRONIC DRIVER, 3000K	W	INTEGRAL LED	UNV	29

EXISTING PANEL 'CE'(MODIFIED CIRCUITS ARE SHADED)

VOLTAGE:	120/208V	**FRAME:**	100A FRAME	**MIN AIC RATING:**	-
PHASE:	3 PHASE	**MAIN:**	100A MB	**CIRCUITS:**	14
WIRE:	4 WIRE	**ENCLOSURE:**	NEMA 1 DOOR-IN-DOOR	**MOUNTING:**	RECESSED
FEED:	BOTTOM	**LOCATION:**			

CKT NO	BKR RTNG	LOAD DESCRIPTION	VA	CONNECTED VA LOAD A	B	C	VA	LOAD DESCRIPTION	BKR RTNG	CKT NO
1	20A/1	RECEPT 311		0				HALLWAY LIGHTS NORTH	20A/1	2
3	20A/1	RECEPT 311			0			SPARE	20A/1	4
5	20A/1	J-BOX 311				0		EMERGENCY LIGHTING	20A/1	6
7	20A/1	SPARE		0				D-2	20A/1	8
9	20A/1	SPARE			0			UPS COMM ROOM #320	30A/2	10
11	20A/1	SPARE				0				12
13	20A/1	SPARE		0				SPARE	20A/1	14
		CONNECTED LOAD (VA) PER PHASE		0	0	0	**0**	**TOTAL CONNECTED LOAD (VA)**		
							0.0	**TOTAL CONNECTED LOAD (AMPS)**		

KEYED NOTES (X)

1. CONTRACTOR TO AS BUILT AND VERIFY PANEL SCHEDULES.

(1)

EXISTING PANEL 'C1'(MODIFIED CIRCUITS ARE SHADED)

VOLTAGE:	120/208V	**FRAME:**	125A FRAME	**MIN AIC RATING:**	-
PHASE:	3 PHASE	**MAIN:**	125A MB	**CIRCUITS:**	42
WIRE:	4 WIRE	**ENCLOSURE:**	NEMA 1 DOOR-IN-DOOR	**MOUNTING:**	RECESSED
FEED:	-	**LOCATION:**	CORRIDOR		

CKT NO	BKR RTNG	LOAD DESCRIPTION	VA	CONNECTED VA LOAD A	B	C	VA	LOAD DESCRIPTION	BKR RTNG	CKT NO
1	20A/1	LIGHTS 316		0				LIGHTS 315,313A, 313B	20A/1	2
3	20A/1	LIGHTS 314,314A,315A			0			SPARE	20A/1	4
5	20A/1	RECEPTACLES 311A	720			720		RECEPTACLE 313B	20A/1	6
7	20A/1	RECEPTACLES 311A	900	900				SPARE	20A/1	8
9	20A/1	RECEPTACLES 311	900		900			SPARE	20A/1	10
11	20A/1	RECEPTACLE 311A PRINTIER/COPIER	720			720		SPARE	20A/1	12
13	20A/1	SPARE		0				RECEPTACLE N. CORRIDOR	20A/1	14
15	20A/1	RECEPTACLES 315,317			0			RECEPTACLE 315	20A/1	16
17	20A/1	RECEPTACLES DR. OFFICE				0		RECEPTACLE 315	20A/1	18
19	20A/1	RECEPTACLES DR. OFFICE		0				RECEPTACLE 318	20A/1	20
21	20A/1	SPARE			0			RECEPTACLE 318, 318A	20A/1	22
23	20A/1	RECEPTACLESX 314, 314A				0		RECEPTACLE 319	20A/1	24
25	20A/1	RECEPTACLES 314		0				RECEPTACLES	20A/1	26
27	20A/1	RECEPTACLES 317			0			RECEPTACLES	20A/1	28
29	20A/1	SPARE				0		SPARE	20A/1	30
31	20A/1	RECEPTACLE 316		0				USED	20A/1	32
33					0			RECEPTACLES 318A, 318C, N. CORRIDOR	20A/1	34
35	20A/3	SPARE				0		LIGHTS	20A/1	36
37				0				SPARE	20A/1	38
39	20A/1	LIGHTS 318,318A			0			SPARE	20A/2	40
41	20A/1	LIGHTS 318B, 318C, 319				0				42
		CONNECTED LOAD (VA) PER PHASE	900	900	1440		**3240**	**TOTAL CONNECTED LOAD (VA)**		
							9.0	**TOTAL CONNECTED LOAD (AMPS)**		

(1)

EXISTING PANEL 'A3'(MODIFIED CIRCUITS ARE SHADED)

VOLTAGE:	120/208V	**FRAME:**	100A FRAME	**MIN AIC RATING:**	10,000
PHASE:	3 PHASE	**MAIN:**	100A MB	**CIRCUITS:**	24
WIRE:	4 WIRE	**ENCLOSURE:**	NEMA 1 DOOR-IN-DOOR	**MOUNTING:**	SURFACE
FEED:	BOTTOM	**LOCATION:**			

CKT NO	BKR RTNG	LOAD DESCRIPTION	VA	CONNECTED VA LOAD A	B	C	VA	LOAD DESCRIPTION	BKR RTNG	CKT NO
1	20A/1	LIGHTS 129A, 129B, 129, 128	900	900				RECEPTACLE RM 126	20A/1	2
3	20A/1	RECEPTACLES OPTOMETRY	900		900			UPS TRANSFORMER OPD	20A/1	4
5	20A/1	ELEVATOR LOBY RECEPTACLE	720			720		LIGHTS C105	20A/1	6
7	20A/1	LIGHTS C105	900	900				LIGHTS 124	20A/1	8
9	20A/1	UNKNOWN	900		900			RECEPTACLE STAIRWELL 103	20A/1	10
11	20A/1	UPS BURR	900			900		NORTH EXIT SIGN	20A/1	12
13	20A/1	SPARE		0				SPARE	??A/1	14
15	20A/1	RECEPTACLES AUDIOLOGY, RM 132	720		720					16
17	20A/1	NORTH RECEPTACLES RM 124				0		SPARE	20A/1	18
19	20A/1	HALLWAY RECEPTACLES, LIGHTS RM 130, 131		0				SPARE	20A/1	20
21	20A/1	UNKNOWN			0			SPARE	20A/1	22
23	20A/1	UNKNOWN				0		ELEVATOR LIGHT, RECEPTACLE	20A/1	24
25	20A/1	UNKNOWN		0				SOUND BOOTH RECEPTACLE	20A/1	26
27	20A/1	EF-1	1176		1176			MECHANICAL SHAFT LIGHTS	20A/1	28
29	50A/2	SPARE				0		MECHANICAL SHAFT RECEPTACLES	20A/1	30
31				0				SPACE		32
33	-	SPACE			0			SPACE		34
35	-	SPACE				0		SPACE		36
		CONNECTED LOAD (VA) PER PHASE	1800	3696	1620		**7116**	**TOTAL CONNECTED LOAD (VA)**		
							19.8	**TOTAL CONNECTED LOAD (AMPS)**		

(1)

EXISTING PANEL 'A5'(MODIFIED CIRCUITS ARE SHADED)

VOLTAGE:	120/208V	**FRAME:**	100A FRAME	**MIN AIC RATING:**	10,000
PHASE:	3 PHASE	**MAIN:**	100A MB	**CIRCUITS:**	24
WIRE:	4 WIRE	**ENCLOSURE:**	NEMA 1 DOOR-IN-DOOR	**MOUNTING:**	SURFACE
FEED:	BOTTOM	**LOCATION:**			

CKT NO	BKR RTNG	LOAD DESCRIPTION	VA	CONNECTED VA LOAD A	B	C	VA	LOAD DESCRIPTION	BKR RTNG	CKT NO
1	20A/1	LIGHTS C106, DOOR OPERATOR	720	1440			720	RECEPT. 125A, 125B, 125C, W CORRIDOR	20A/1	2
3	20A/1	1ST FLOOR E EXIT LIGHT, 2ND FLOOR W EXIT L	720		1620		900	RECEPT. 129A	20A/1	4
5	20A/1	RECEPTACLES 129	900			1800	900	LIGHTS 126, 127, RECEPTACLES 126, 127, C106	20A/1	6
7	20A/1	LIGHTS 125, 125A,125B, 125C	900	1620			720	RECEPTACLES 127, 128	20A/1	8
9	20A/1	LIGHTS 125B, RECEPTACLES 125	720		1440		720	RECEPTACLES 125A, 125C	20A/1	10
11	20A/1	LIGHTS 125C, RECEPTACLES 125C	900			1620	720	RECEPTACLES 129	20A/1	12
13	20A/1	UNKNOWN	900	1620			720	RECEPTACLES 129	20A/1	14
15	50A/2	SPARE			720		720	RECEPTACLES 125, 125A	20A/1	16
17						900	900	LIGHTS 125, RECEPTACLES 125	20A/1	18
19	60A/2	SPARE		412			412	LIGHTING	20A/1	20
21					0			SPACE	-	22
23	-	SPACE				0		SPACE	-	24
		CONNECTED LOAD (VA) PER PHASE	5092	3780	4320		**13192**	**TOTAL CONNECTED LOAD (VA)**		
							36.7	**TOTAL CONNECTED LOAD (AMPS)**		

(1)

EXISTING PANEL 'EM-2' (MODIFIED CIRCUITS ARE SHADED)

VOLTAGE:	480Y/277V	**FRAME:**	125A FRAME	**MIN AIC RATING:**	10,000
PHASE:	3 PHASE	**MAIN:**	MAIN LUG ONLY	**CIRCUITS:**	30
WIRE:	4 WIRE	**ENCLOSURE:**	NEMA 1 DOOR-IN-DOOR	**MOUNTING:**	SURFACE
FEED:	BOTTOM	**LOCATION:**			

CKT NO	BKR RTNG	LOAD DESCRIPTION	VA	CONNECTED VA LOAD A	B	C	VA	LOAD DESCRIPTION	BKR RTNG	CKT NO
1			5069	8420			3351			2
3	20A/3	HP-4E	5069		8420		3351	HP-2E	20A/3	4
5			5069			8420	3351			6
7			5069	8420			3351			8
9	30A/3	HP-1E	5069		8420		3351	HP-3E	30A/3	10
11			5069			8420	3351			12
13				0						14
15	20A/3	SPARE			0			SPARE	20A/3	16
17						0				18
19	20A/1	HP-5E	1200	2400			1200	HP-6E	20A/1	20
21	20A/1	SPARE			2417		2417			22
23	-	SPACE				2417	2417	HP-8	15A/3	24
25	-	SPACE		2417			2417			26
27	-	SPACE			0			SPACE	-	28
29	-	SPACE				0		SPACE	-	30
		CONNECTED LOAD (VA) PER PHASE	21657	19257	19257		**60171**	**TOTAL CONNECTED LOAD (VA)**		
							72.5	**TOTAL CONNECTED LOAD (AMPS)**		

INDIAN HEALTH SERVICE · IHS · 1955 ·

Mark	Description	Date	Appr
0	AS-BUILTS	7-01-21	

File Name: Plot Date:
Plot Scale:
Do not scale drawing. Refer to Tolerance

DESIGN BY: W.B.
DRAWN BY: W.B.
REVIEWED BY: J.C.A.

INDIAN HEALTH SERVICES
ALBUQUERQUE, NEW MEXICO

HUITT-ZOLLARS
GranCor Construction Management
QA Engineering

INDIAN HEALTH SERVICES
AIHC 1ST AND 3RD FLOOR INTERIOR RENOVATIONS

ELECTRICAL SCHEDULES

SHEET NO.
E-5

SEQUENCE NO.
SHEET 23 OF 31

FIRE ALARM REPLACEMENT

ALBUQUERQUE IHS HOSPITAL

801 Vassar Dr. N.E.
Albuquerque, New Mexico 87106

Fire Alarm Plans
As-Builts

INDEX OF DRAWINGS

SHT NO.	DESCRIPTION
G-1	COVER SHEET
FA-1	FIRST FLOOR FIRE ALARM PLAN
FA-2	SECOND FLOOR AREA-A FIRE ALARM PLAN
FA-3	SECOND FLOOR AREA-B FIRE ALARM PLAN
FA-4	THIRD FLOOR FIRE ALARM PLAN
FA-5	FOURTH FLOOR/PENTHOUSE FIRE ALARM PLAN
FA-6	RISER DIAGRAM
FA-7	BATTERY CALC's

BUILDING OWNER:

Albuquerque Area Indian Health Services
Second Floor Altura Offices
4101 Indian School Road N.E.
Albuquerque, N.M. 87110
(505) 248-4500

INSTALLATION CONTRACTOR:

SUMMIT FIRE & SECURITY
7131 WASHINGTON ST. NE
ALBUQUERQUE, NM 87109
(505) 884-1217

SUMMIT
FIRE & SECURITY
7131 WASHINGTON ST NE
ALBUQUERQUE, NM 87109
(505) 884-1217

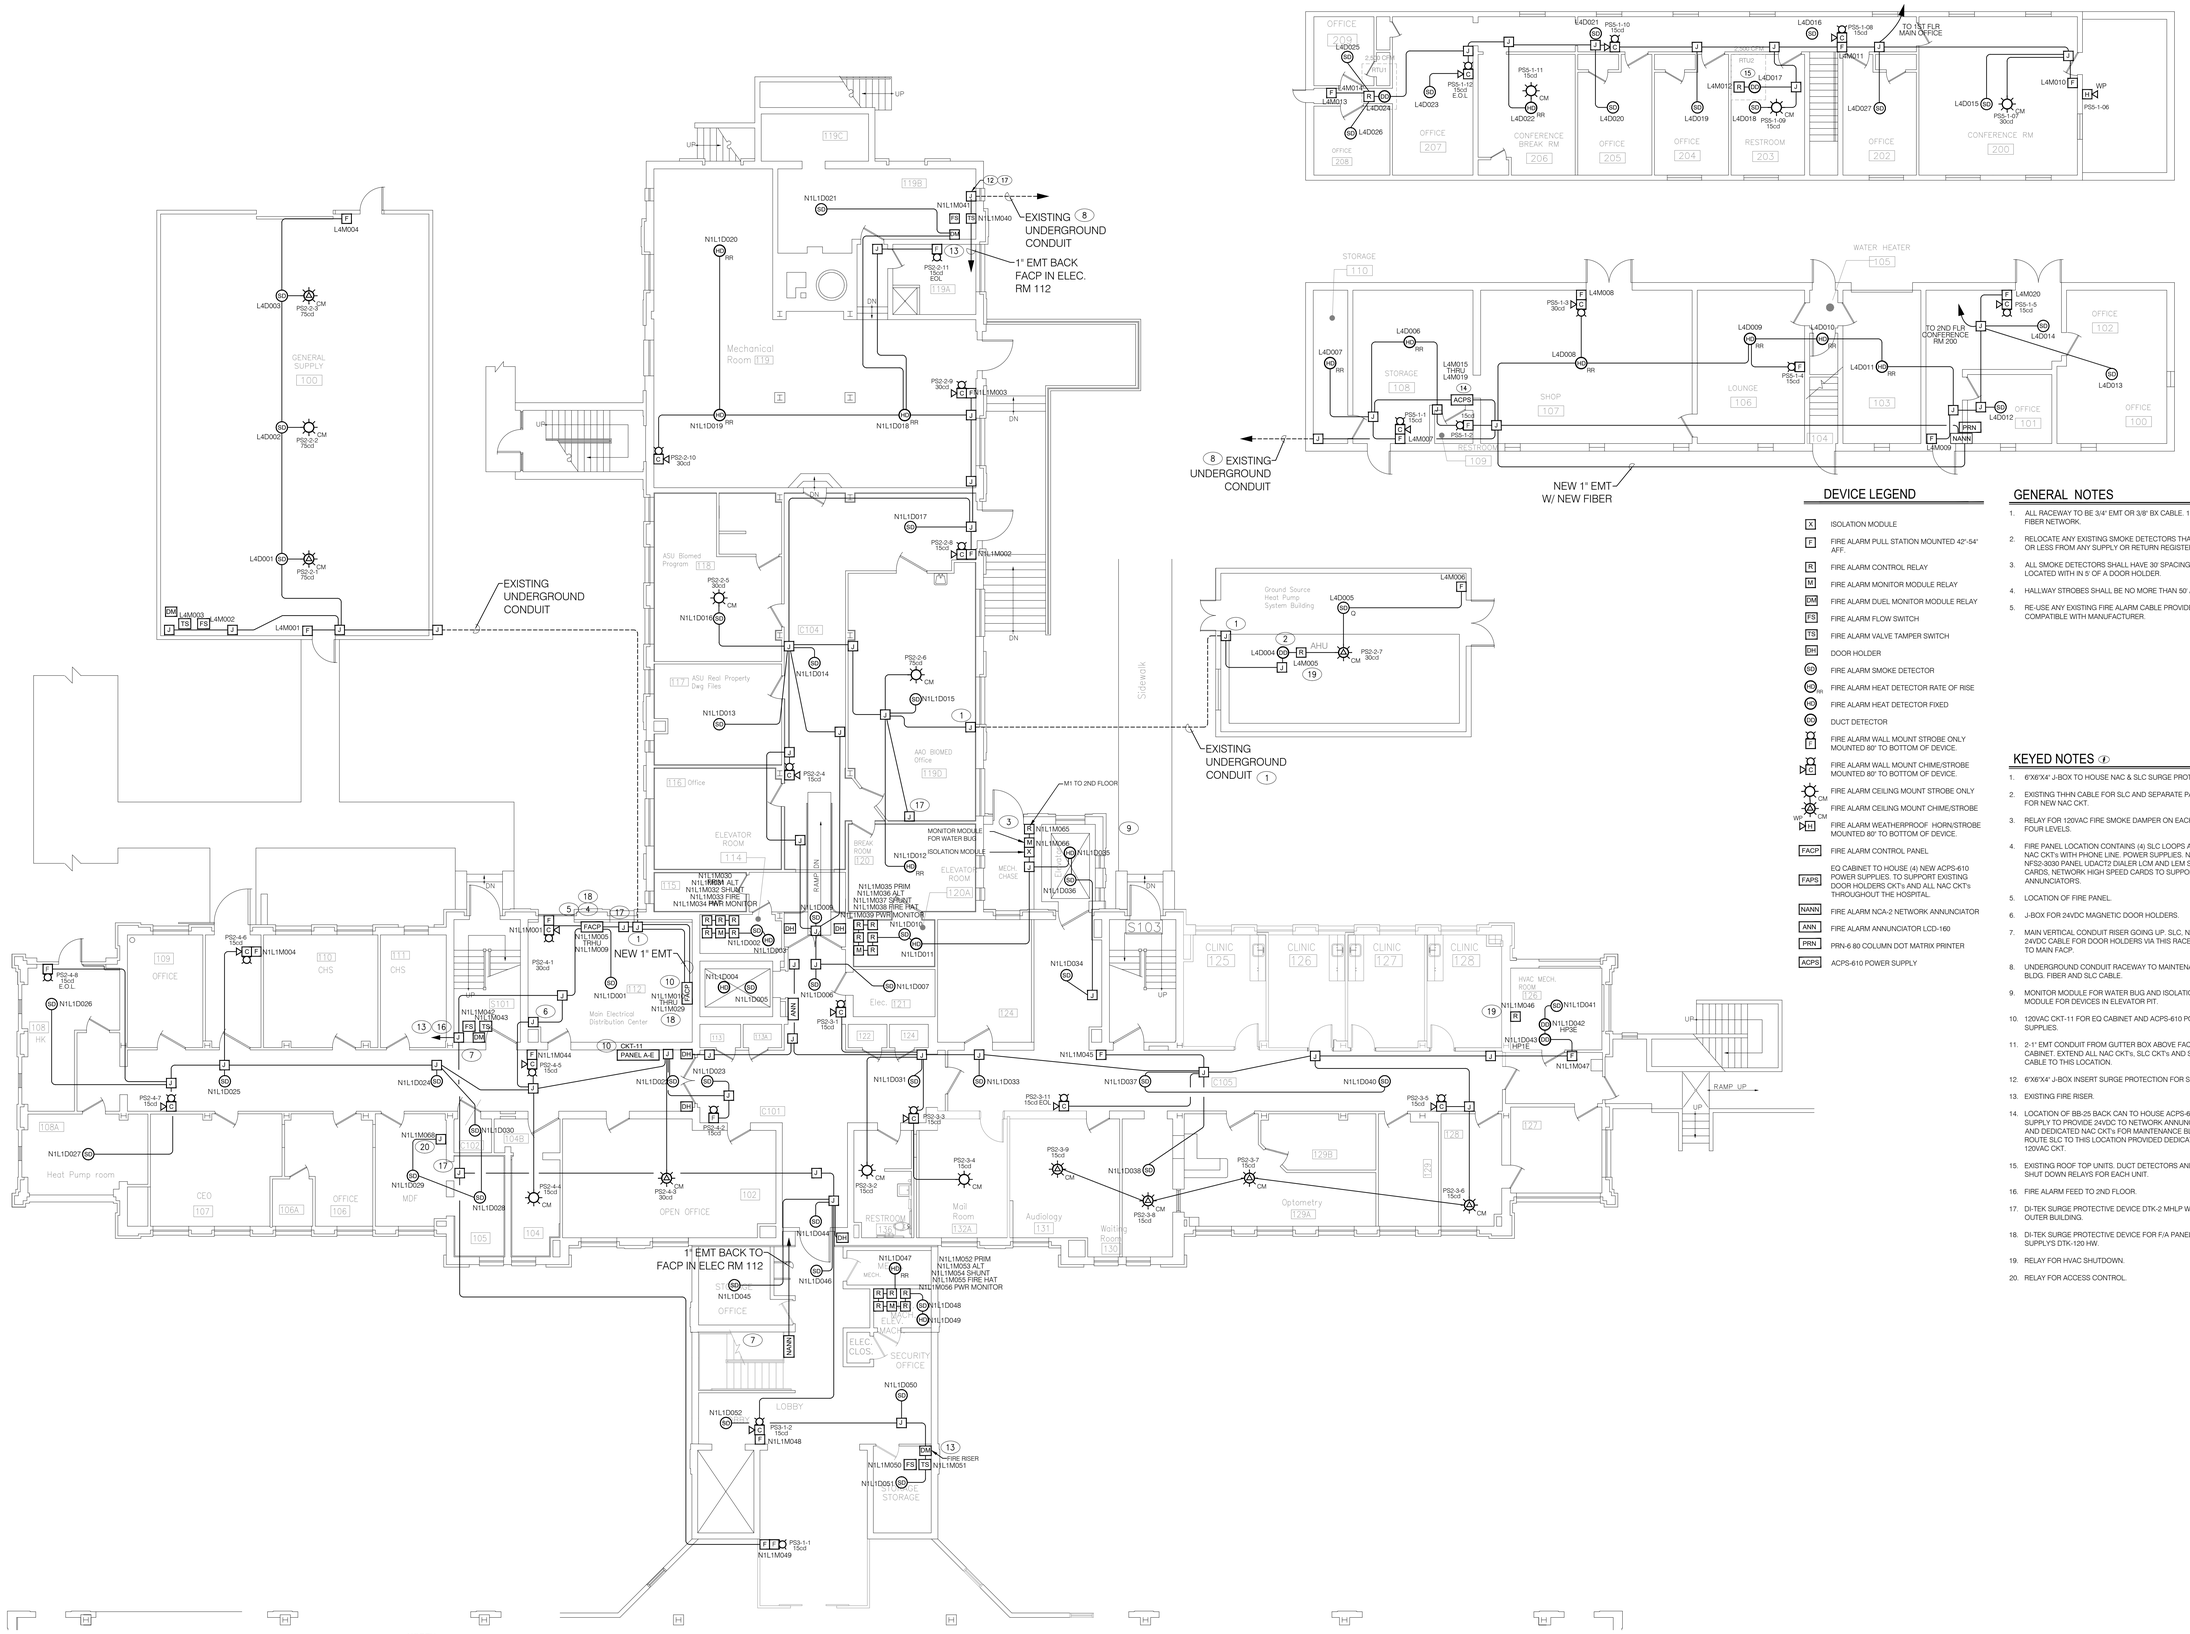

DEVICE LEGEND

- X — ISOLATION MODULE
- F — FIRE ALARM PULL STATION MOUNTED 42"-54" AFF.
- R — FIRE ALARM CONTROL RELAY
- M — FIRE ALARM MONITOR MODULE RELAY
- DM — FIRE ALARM DUEL MONITOR MODULE RELAY
- FS — FIRE ALARM FLOW SWITCH
- TS — FIRE ALARM VALVE TAMPER SWITCH
- DH — DOOR HOLDER
- SD — FIRE ALARM SMOKE DETECTOR
- SD RR — FIRE ALARM HEAT DETECTOR RATE OF RISE
- HD — FIRE ALARM HEAT DETECTOR FIXED
- DD — DUCT DETECTOR
- F — FIRE ALARM WALL MOUNT STROBE ONLY MOUNTED 80" TO BOTTOM OF DEVICE.
- C — FIRE ALARM WALL MOUNT CHIME/STROBE MOUNTED 80" TO BOTTOM OF DEVICE.
- CM — FIRE ALARM CEILING MOUNT STROBE ONLY
- WP CM — FIRE ALARM CEILING MOUNT CHIME/STROBE
- WP H — FIRE ALARM WEATHERPROOF HORN/STROBE MOUNTED 80" TO BOTTOM OF DEVICE.
- FACP — FIRE ALARM CONTROL PANEL
- FAPS — EQ CABINET TO HOUSE (4) NEW ACPS-610 POWER SUPPLIES TO SUPPORT EXISTING DOOR HOLDERS CKT's AND ALL NAC CKT's THROUGHOUT THE HOSPITAL.
- NANN — FIRE ALARM NCA-2 NETWORK ANNUNCIATOR
- ANN — FIRE ALARM ANNUNCIATOR LCD-160
- PRN — PRN-6 80 COLUMN DOT MATRIX PRINTER
- ACPS — ACPS-610 POWER SUPPLY

GENERAL NOTES

1. ALL RACEWAY TO BE 3/4" EMT OR 3/8" BX CABLE. 1" EMT FOR FIBER NETWORK.
2. RELOCATE ANY EXISTING SMOKE DETECTORS THAT ARE 3' OR LESS FROM ANY SUPPLY OR RETURN REGISTER.
3. ALL SMOKE DETECTORS SHALL HAVE 30' SPACING AND BE LOCATED WITH IN 5' OF A DOOR HOLDER.
4. HALLWAY STROBES SHALL BE NO MORE THAN 50' APART.
5. RE-USE ANY EXISTING FIRE ALARM CABLE PROVIDED ITS COMPATIBLE WITH MANUFACTURER.

KEYED NOTES

1. 6"X6"X4" J-BOX TO HOUSE NAC & SLC SURGE PROTECTORS.
2. EXISTING THHN CABLE FOR SLC AND SEPARATE PAIR FOR NEW NAC CKT.
3. RELAY FOR 120VAC FIRE SMOKE DAMPER ON EACH OF THE FOUR LEVELS.
4. FIRE PANEL LOCATION CONTAINS (4) SLC LOOPS AND (7) NAC CKT's WITH PHONE LINE. POWER SUPPLIES, NOTIFIER NFS2-3030 PANEL UDACT2 DAILER LCM AND LEM SLC LOOP CARDS, NETWORK HIGH SPEED CARDS TO SUPPORT NCA-2 ANNUNCIATORS.
5. LOCATION OF FIRE PANEL.
6. J-BOX FOR 24VDC MAGNETIC DOOR HOLDERS.
7. MAIN VERTICAL CONDUIT RISER GOING UP. SLC, NAC AND 24VDC CABLE FOR DOOR HOLDERS VIA THIS RACEWAY BACK TO MAIN FACP.
8. UNDERGROUND CONDUIT RACEWAY TO MAINTENANCE BLDG. FIBER AND SLC CABLE.
9. MONITOR MODULE FOR WATER BUG AND ISOLATION MODULE FOR DEVICES IN ELEVATOR PIT.
10. 120VAC CKT-11 FOR EQ CABINET AND ACPS-610 POWER SUPPLIES.
11. 2-1" EMT CONDUIT FROM GUTTER BOX ABOVE FACP TO EQ CABINET. EXTEND ALL NAC CKT's, SLC CKT's AND SYNC CABLE TO THIS LOCATION.
12. 6"X6"X4" J-BOX INSERT SURGE PROTECTION FOR SLC.
13. EXISTING FIRE RISER.
14. LOCATION OF BB-25 BACK CAN TO HOUSE ACPS-610 POWER SUPPLY TO PROVIDE 24VDC TO NETWORK ANNUNCIATOR AND DEDICATED NAC CKT's FOR MAINTENANCE BLDG. ROUTE SLC TO THIS LOCATION PROVIDED DEDICATED 120VAC CKT.
15. EXISTING ROOF TOP UNITS. DUCT DETECTORS AND AHU SHUT DOWN RELAYS FOR EACH UNIT.
16. FIRE ALARM FEED TO 2ND FLOOR.
17. DI-TEK SURGE PROTECTIVE DEVICE DTK-2 MHLP WB FOR OUTER BUILDING.
18. DI-TEK SURGE PROTECTIVE DEVICE FOR F/A PANEL / POWER SUPPLYS DTK-120 HW.
19. RELAY FOR HVAC SHUTDOWN.
20. RELAY FOR ACCESS CONTROL.

SUMMIT FIRE & SECURITY
7131 WASHINGTON ST. N.E.
ALBUQUERQUE, NM 87109
(505) 884-1217

INDIAN HEALTH SERVICES ALBUQUERQUE INDIAN HOSPITAL (ALBQ. SERVICE UNIT)

801 VASSAR DR. NE
ALBUQUERQUE NM, 87106

6	05/13/21	3RD FLOOR JAN AS-BUILT
5	03/08/21	1ST & 3RD FLOOR AS-BUILTS
4	01/18/17	AS-BUILTS
3	11/30/16	RELOCATE PRINTER TO MAINT.
		BLDG. DEMO PULL STATION IN
		3RD FL LOBBY 311/ AS-BUILT
2	08/17/15	AS-BUILT
1	03/02/15	ISSUE FOR CONSTRUCTION
0	10/31/14	PRELIMINARY BID
	DATE:	DESCRIPTION:

CHECKED BY:	B.B.
DRAWN BY:	V.F.
FILE NAME:	IHS ALBQ HOSP 1ST FL FA-1
SCALE:	1/8" = 1'-0"

SHEET TITLE:

1ST FLOOR FIRE ALARM PLAN

FA-1

PAGE: 1 OF 7

W:\MSO\IHS\Albq Sites\Albq Hosp\Albq Hosp Fire Alarm As-Built\DWGS\IHS Albq Hosp 1st FA-1.dwg

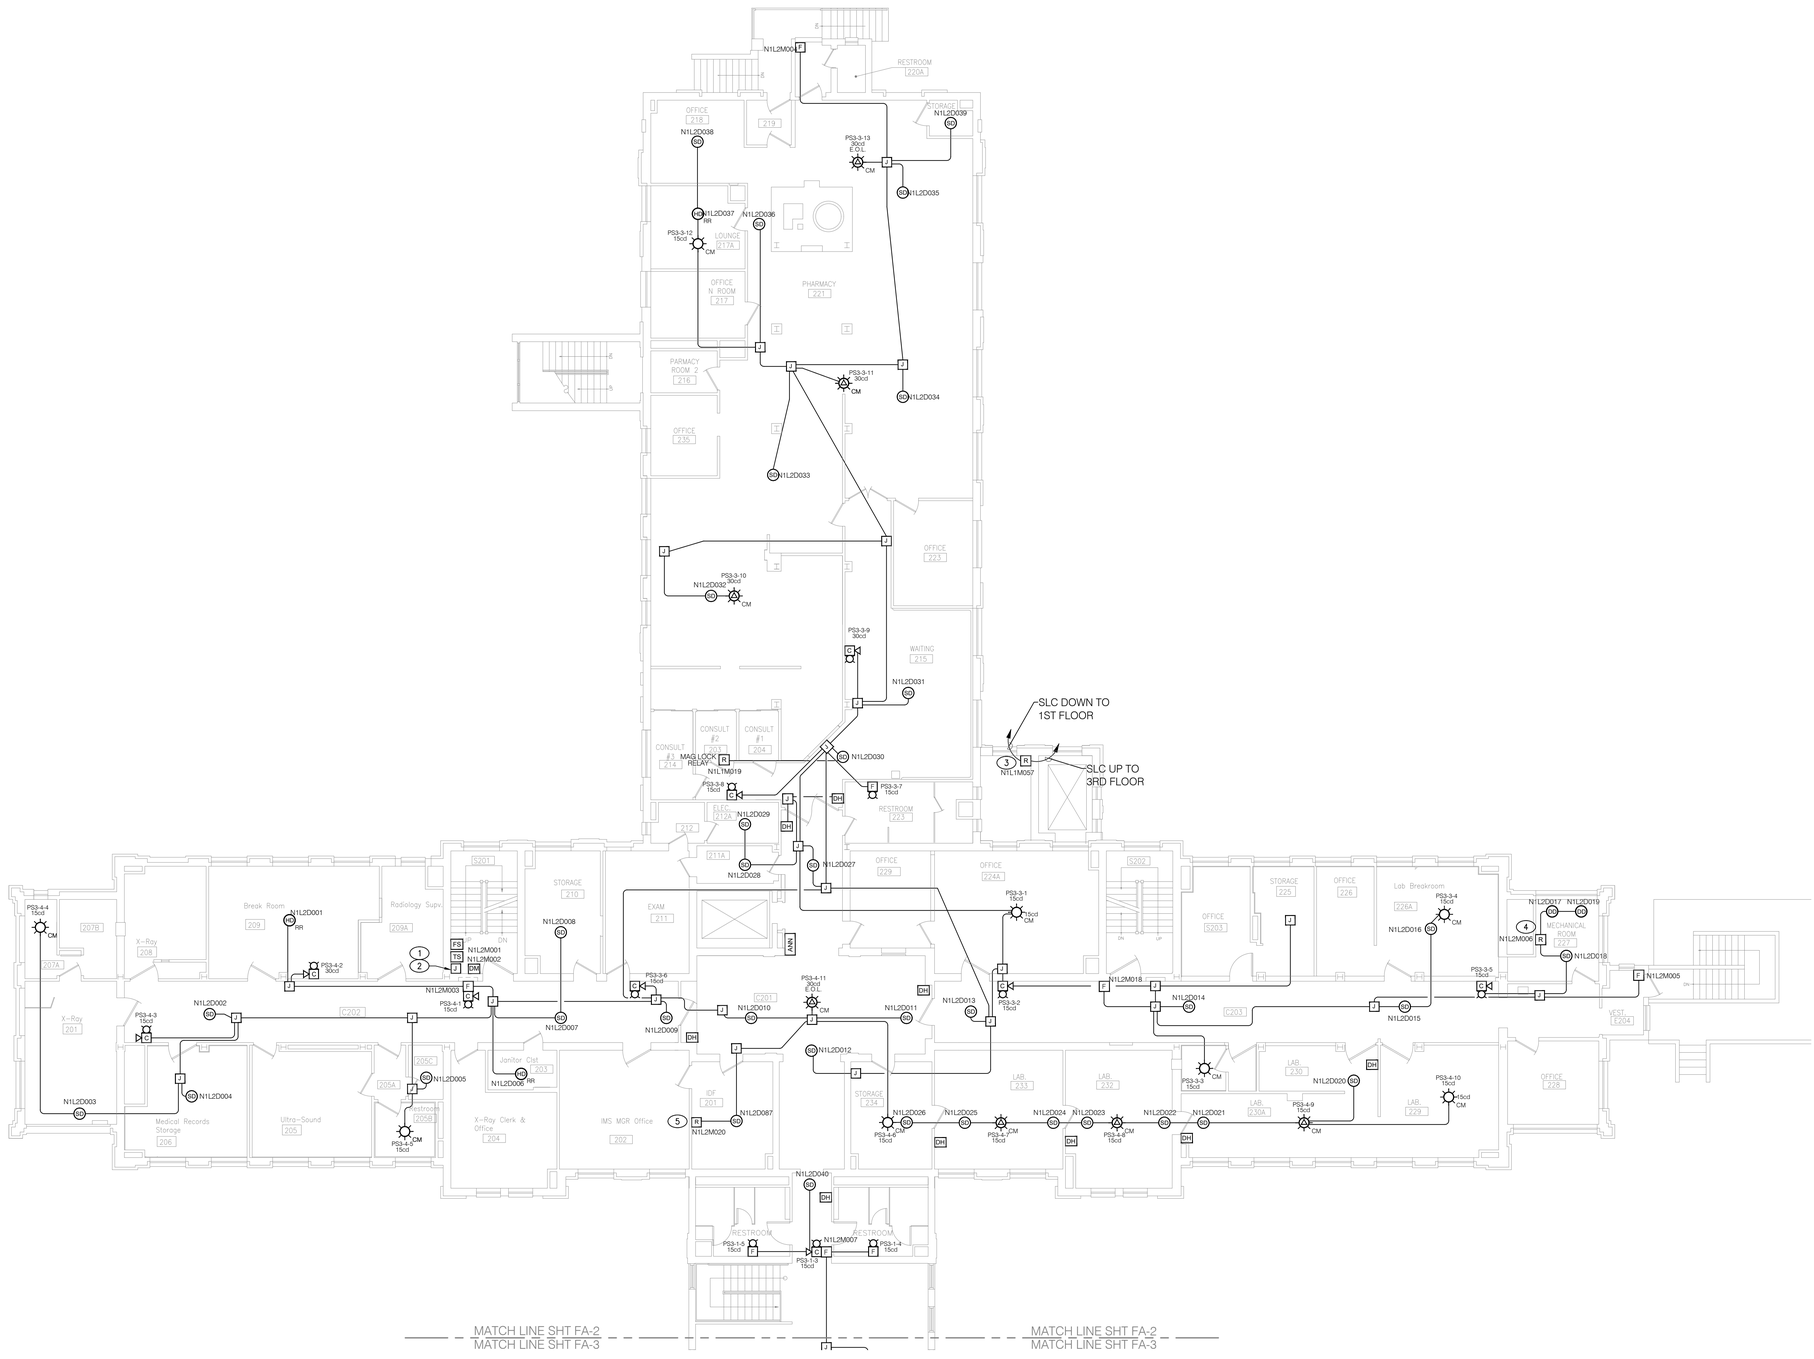

NORTH

SECOND FLOOR AREA-A - FIRE ALARM PLAN

1/8" = 1'-0"

GENERAL NOTES

1. 7 ROOFTOP UNITS RELAY IN MECHANICAL CHASE FOR DAMPER CONTROL.
2. ALL RACEWAY TO BE 3/4" EMT OR 3/8" BX CABLE.
3. RELOCATE ANY EXISTING SMOKE DETECTORS THAT ARE 3' OR LESS FROM ANY SUPPLY REGISTER.
4. ALL SMOKE DETECTORS SHALL HAVE 30' SPACING AND BE LOCATED WITH IN 5' OF A DOOR HOLDER.
5. HALLWAY STROBES SHALL BE NO MORE THAN 50' APART.
6. RE-USE ANY EXISTING FIRE ALARM CABLE PROVIDED ITS COMPATIBLE WITH MANUFACTURER.

KEYED NOTES

1. MAIN CONDUIT RISER VERTICAL UP STAIRS. ROUTE NEW SLC CABLE 24VDC DOOR HOLDER CKT AND 4 NEW NAC CKT's.
2. ROUTE (4) #14AWG2 CONDUCTOR CABLES FOR A TOTAL OF (4) NAC CKT's FOR THE 2nd FLOOR ACPS#2.
3. RELAY FOR 120VAC FIRE SMOKE DAMPER ON EACH OF THE FOUR LEVELS.
4. RELAY FOR HVAC SHUTDOWN.
5. RELAY FOR ACCESS CONTROL.

DEVICE LEGEND

X	ISOLATION MODULE
F	FIRE ALARM PULL STATION MOUNTED 42"-54" AFF.
R	FIRE ALARM CONTROL RELAY
M	FIRE ALARM MONITOR MODULE RELAY
DM	FIRE ALARM DUEL MONITOR MODULE RELAY
FS	FIRE ALARM FLOW SWITCH
TS	FIRE ALARM VALVE TAMPER SWITCH
DH	DOOR HOLDER
SD	FIRE ALARM SMOKE DETECTOR
HD	FIRE ALARM HEAT DETECTOR RATE OF RISE
HD	FIRE ALARM HEAT DETECTOR FIXED
DD	DUCT DETECTOR
	FIRE ALARM WALL MOUNT STROBE ONLY MOUNTED 80" TO BOTTOM OF DEVICE.
H	FIRE ALARM WALL MOUNT CHIME/STROBE MOUNTED 80" TO BOTTOM OF DEVICE.
WP CM	FIRE ALARM CEILING MOUNT STROBE ONLY
CM	FIRE ALARM CEILING MOUNT CHIME/STROBE
H	FIRE ALARM WEATHERPROOF HORN/STROBE MOUNTED 80" TO BOTTOM OF DEVICE.
FACP	FIRE ALARM CONTROL PANEL
FAPS	EQ CABINET TO HOUSE (4) NEW ACPS-610 POWER SUPPLIES. TO SUPPORT EXISTING DOOR HOLDERS CKTs AND ALL NAC CKT's THROUGHOUT THE HOSPITAL.
NANN	FIRE ALARM NCA-2 NETWORK ANNUNCIATOR
ANN	FIRE ALARM ANNUNCIATOR LCD-160
PRN	PRN-6 80 COLUMN DOT MATRIX PRINTER

SUMMIT
FIRE & SECURITY
7131 WASHINGTON ST. N.E.
ALBUQUERQUE, NM. 87109
(505) 884-1217

INDIAN HEALTH SERVICES
ALBUQUERQUE
INDIAN HOSPITAL
(ALBQ. SERVICE UNIT)
801 VASSAR DR. NE
ALBUQUERQUE NM, 87106

6	05/13/21	3RD FLOOR JAN AS-BUILT
5	03/08/21	1ST & 3RD FLOOR AS-BUILTS
4	01/18/17	AS-BUILTS
3	11/30/16	RELOCATE PRINTER TO MAINT.
		BLDG. DEMO PULL STATION IN
		3RD FL LOBBY 311/ AS-BUILT
2	08/17/15	AS-BUILT
1	03/02/15	ISSUE FOR CONSTRUCTION
0	10/31/14	PRELIMINARY BID
	DATE:	DESCRIPTION:

CHECKED BY:	B.B.
DRAWN BY:	V.F.
FILE NAME:	IHS ALBQ HOSP 2ND FL FA-2
SCALE:	1/8" = 1'-0"

SHEET TITLE:

2ND FLOOR
AREA-A
FIRE ALARM PLAN

FA-2

PAGE: 2 OF 7

W:\MISC\IHS\Albq Sites\Albq Hosp\Albq Hosp Fire Alarm As-Built\DWGS\IHS Albq Hosp 2nd FA 2-3.dwg

GENERAL NOTES

1. 7 ROOFTOP UNITS RELAY IN MECHANICAL CHASE FOR DAMPER CONTROL.
2. ALL RACEWAY TO BE 3/4" EMT OR 3/8" BX CABLE.
3. RELOCATE ANY EXISTING SMOKE DETECTORS THAT ARE 3' OR LESS FROM ANY SUPPLY REGISTER.
4. ALL SMOKE DETECTORS SHALL HAVE 30' SPACING AND BE LOCATED WITH IN 5' OF A DOOR HOLDER.
5. HALLWAY STROBES SHALL BE NO MORE THAN 50' APART.
6. RE-USE ANY EXISTING FIRE ALARM CABLE PROVIDED ITS COMPATIBLE WITH MANUFACTURER.

KEYED NOTES

1. RELAY FOR HVAC SHUTDOWN.
2. ROOFTOP AIR HANDLING UNITS WITH DUCT SMOKE DETECTORS LOCATED ABOVE CEILING.
3. RELAY FOR ACCESS CONTROL.

DEVICE LEGEND

X	ISOLATION MODULE
F	FIRE ALARM PULL STATION MOUNTED 42"-54" AFF.
R	FIRE ALARM CONTROL RELAY
M	FIRE ALARM MONITOR MODULE RELAY
DM	FIRE ALARM DUEL MONITOR MODULE RELAY
FS	FIRE ALARM FLOW SWITCH
TS	FIRE ALARM VALVE TAMPER SWITCH
DH	DOOR HOLDER
SD	FIRE ALARM SMOKE DETECTOR
HD ROR	FIRE ALARM HEAT DETECTOR RATE OF RISE
HD	FIRE ALARM HEAT DETECTOR FIXED
DD	DUCT DETECTOR
S	FIRE ALARM WALL MOUNT STROBE ONLY MOUNTED 80" TO BOTTOM OF DEVICE.
H/S	FIRE ALARM WALL MOUNT CHIME/STROBE MOUNTED 80" TO BOTTOM OF DEVICE.
CM	FIRE ALARM CEILING MOUNT STROBE ONLY
H/S CM	FIRE ALARM CEILING MOUNT CHIME/STROBE
WP H	FIRE ALARM WEATHERPROOF HORN/STROBE MOUNTED 80" TO BOTTOM OF DEVICE.
FACP	FIRE ALARM CONTROL PANEL
FAPS	EQ CABINET TO HOUSE (4) NEW ACPS-610 POWER SUPPLIES. TO SUPPORT EXISTING DOOR HOLDERS CKTs AND ALL NAC CKT's THROUGHOUT THE HOSPITAL.
NANN	FIRE ALARM NCA-2 NETWORK ANNUNCIATOR
ANN	FIRE ALARM ANNUNCIATOR LCD-160
PRN	PRN-6 80 COLUMN DOT MATRIX PRINTER

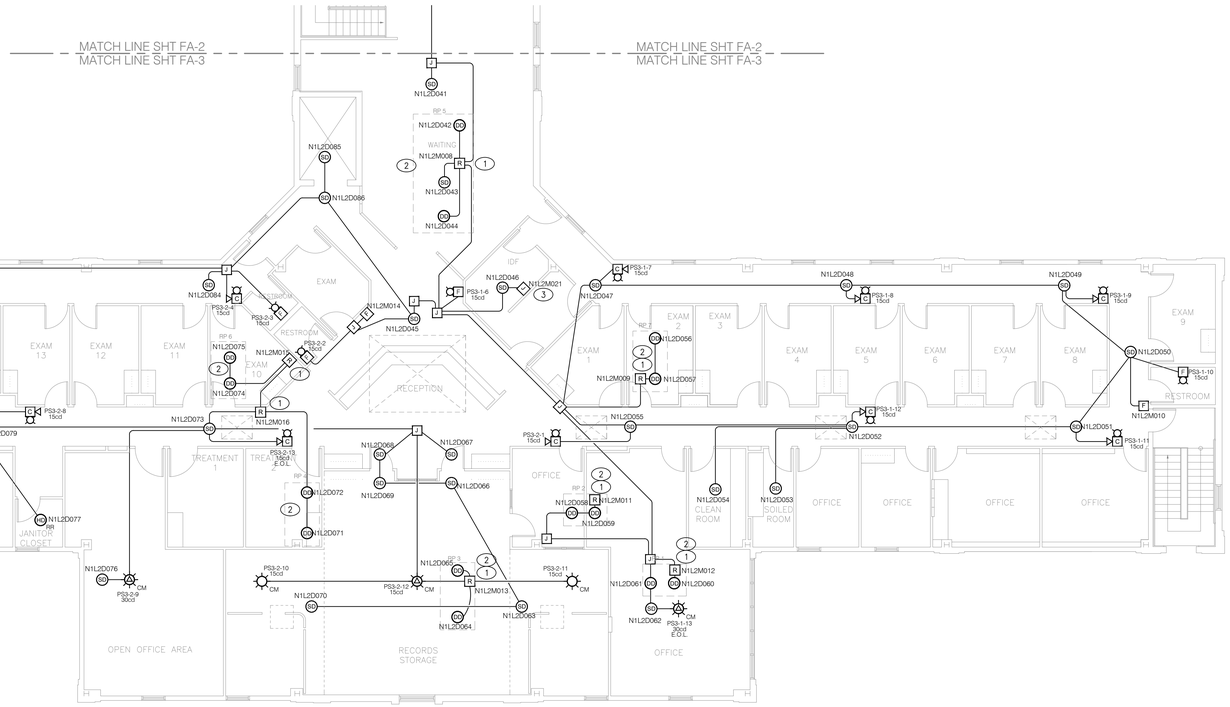

NORTH

SECOND FLOOR AREA-B - FIRE ALARM PLAN

1/8" = 1'-0"

SUMMIT FIRE & SECURITY
7131 WASHINGTON ST. N.E.
ALBUQUERQUE, NM 87109
(505) 884-1217

INDIAN HEALTH SERVICES
ALBUQUERQUE INDIAN HOSPITAL
(ALBQ. SERVICE UNIT)
801 VASSAR DR. NE
ALBUQUERQUE NM, 87106

6	05/13/21	3RD FLOOR JAN AS-BUILT
5	03/08/21	1ST & 3RD FLOOR AS-BUILTS
4	01/18/17	AS-BUILTS
3	11/30/16	RELOCATE PRINTER TO MAINT.
		BLDG. DEMO PULL STATION IN
		3RD FL LOBBY 311/ AS-BUILT
2	08/17/15	AS-BUILT
1	03/02/15	ISSUE FOR CONSTRUCTION
0	10/31/14	PRELIMINARY BID
	DATE:	DESCRIPTION:

CHECKED BY:	B.B.
DRAWN BY:	V.F.
FILE NAME:	IHS ALBQ HOSP 2ND FL FA-2
SCALE:	1/8" = 1'-0"

SHEET TITLE:

2ND FLOOR
AREA-B
FIRE ALARM PLAN

FA-3

PAGE: 3 OF 7

Reuse of this drawing and design is prohibited without written consent of Summit Fire & Security. Drawings and design are property of Summit Fire & Security.

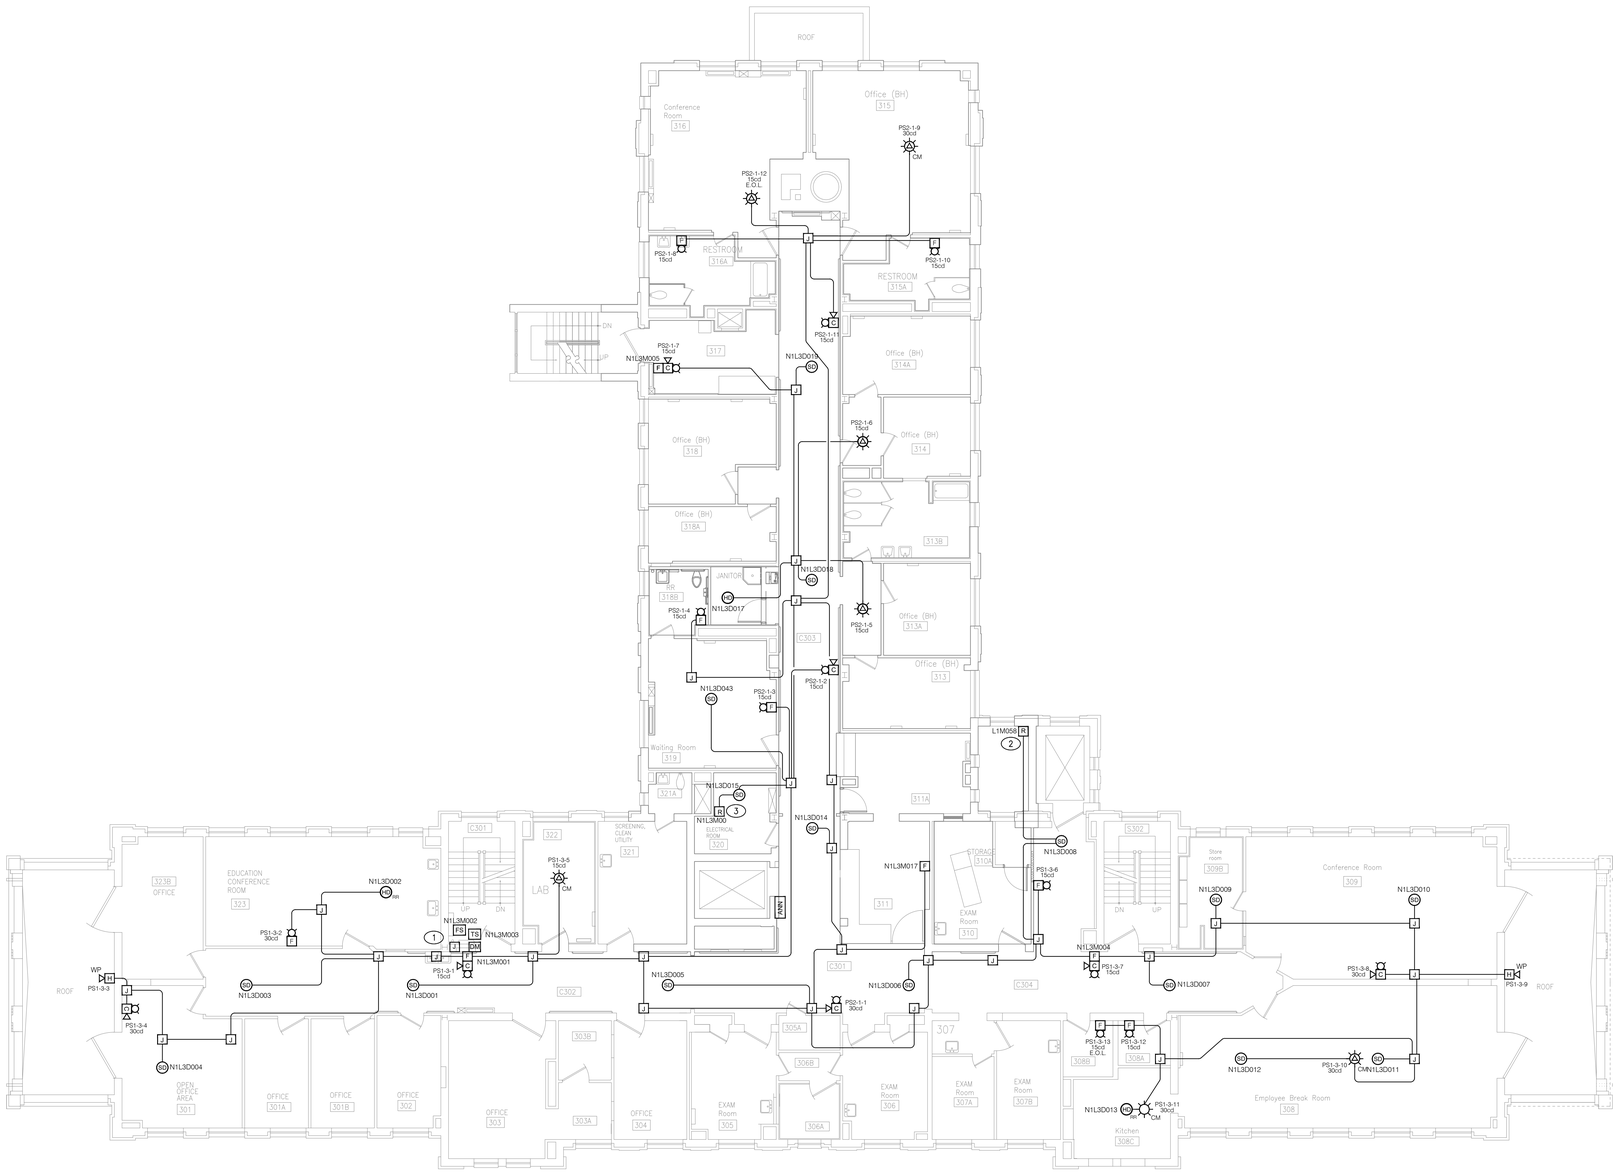

NORTH

THIRD FLOOR - FIRE ALARM PLAN

3/32" = 1'-0"

0 4' 8' 16'

GENERAL NOTES

1. 7 ROOFTOP UNITS RELAY IN MECHANICAL CHASE FOR DAMPER CONTROL.
2. ALL RACEWAY TO BE 3/4" EMT OR 3/8" BX CABLE.
3. RELOCATE ANY EXISTING SMOKE DETECTORS THAT ARE 3' OR LESS FROM ANY SUPPLY REGISTER.
4. ALL SMOKE DETECTORS SHALL HAVE 30' SPACING AND BE LOCATED WITH IN 5' OF A DOOR HOLDER
5. HALLWAY STROBES SHALL BE NO MORE THAN 50' APART.
6. RE-USE ANY EXISTING FIRE ALARM CABLE PROVIDED ITS COMPATIBLE WITH MANUFACTURER.

KEYED NOTES

1. MAIN VERTICAL CONDUIT RISER GOING UP. SLC, NAC AND 24VDC CABLE FOR DOOR HOLDERS VIA THIS RACEWAY BACK TO MAIN FACP.
2. RELAY FOR 120VAC FIRE SMOKE DAMPER ON EACH OF THE FOUR LEVELS.
3. RELAY FOR DOOR ACCESS CONTROL.

DEVICE LEGEND

X	ISOLATION MODULE
F	FIRE ALARM PULL STATION MOUNTED 42"-54" AFF.
R	FIRE ALARM CONTROL RELAY
M	FIRE ALARM MONITOR MODULE RELAY
DM	FIRE ALARM DUEL MONITOR MODULE RELAY
FS	FIRE ALARM FLOW SWITCH
TS	FIRE ALARM VALVE TAMPER SWITCH
DH	DOOR HOLDER
SD	FIRE ALARM SMOKE DETECTOR
HD RR	FIRE ALARM HEAT DETECTOR RATE OF RISE
HD	FIRE ALARM HEAT DETECTOR FIXED
DD	DUCT DETECTOR
H	FIRE ALARM WALL MOUNT STROBE ONLY MOUNTED 80" TO BOTTOM OF DEVICE.
CH	FIRE ALARM WALL MOUNT CHIME/STROBE MOUNTED 80" TO BOTTOM OF DEVICE.
	FIRE ALARM CEILING MOUNT STROBE ONLY
	FIRE ALARM CEILING MOUNT CHIME/STROBE
WP H	FIRE ALARM WEATHERPROOF HORN/STROBE MOUNTED 80" TO BOTTOM OF DEVICE.
FACP	FIRE ALARM CONTROL PANEL
FAPS	EQ CABINET TO HOUSE (4) NEW ACPS-610 POWER SUPPLIES. TO SUPPORT EXISTING DOOR HOLDERS CKTs AND ALL NAC CKT's THROUGHOUT THE HOSPITAL.
NANN	FIRE ALARM NCA-2 NETWORK ANNUNCIATOR
ANN	FIRE ALARM ANNUNCIATOR LCD-160
PRN	PRN-6 80 COLUMN DOT MATRIX PRINTER

SUMMIT
FIRE & SECURITY
7131 WASHINGTON ST. N.E.
ALBUQUERQUE, NM 87109
(505) 884-1217

INDIAN HEALTH SERVICES
ALBUQUERQUE
INDIAN HOSPITAL
(ALBQ. SERVICE UNIT)
801 VASSAR DR. NE
ALBUQUERQUE NM, 87106

6	05/13/21	3RD FLOOR JAN AS-BUILT
5	03/08/21	1ST & 3RD FLOOR AS-BUILTS
4	01/18/17	AS-BUILTS
3	11/30/16	RELOCATE PRINTER TO MAINT.
		BLDG. DEMO PULL STATION IN
		3RD FL LOBBY 311/ AS-BUILT
2	08/17/15	AS-BUILT
1	03/02/15	ISSUE FOR CONSTRUCTION
0	10/31/14	PRELIMINARY BID
	DATE:	DESCRIPTION:

CHECKED BY:	B.B.
DRAWN BY:	V.F.
FILE NAME:	IHS ALBO HOSP 3RD FL FA-4
SCALE:	1/8" = 1'-0"

SHEET TITLE:

3RD FLOOR

FIRE ALARM PLAN

FA-4

PAGE: 4 OF 7

W:\MSO\IHS\Abq Sites\Albq Hosp\Albq Hosp Fire Alarm As-Built\DWGS\IHS Albq Hosp 3rd FA-4.dwg

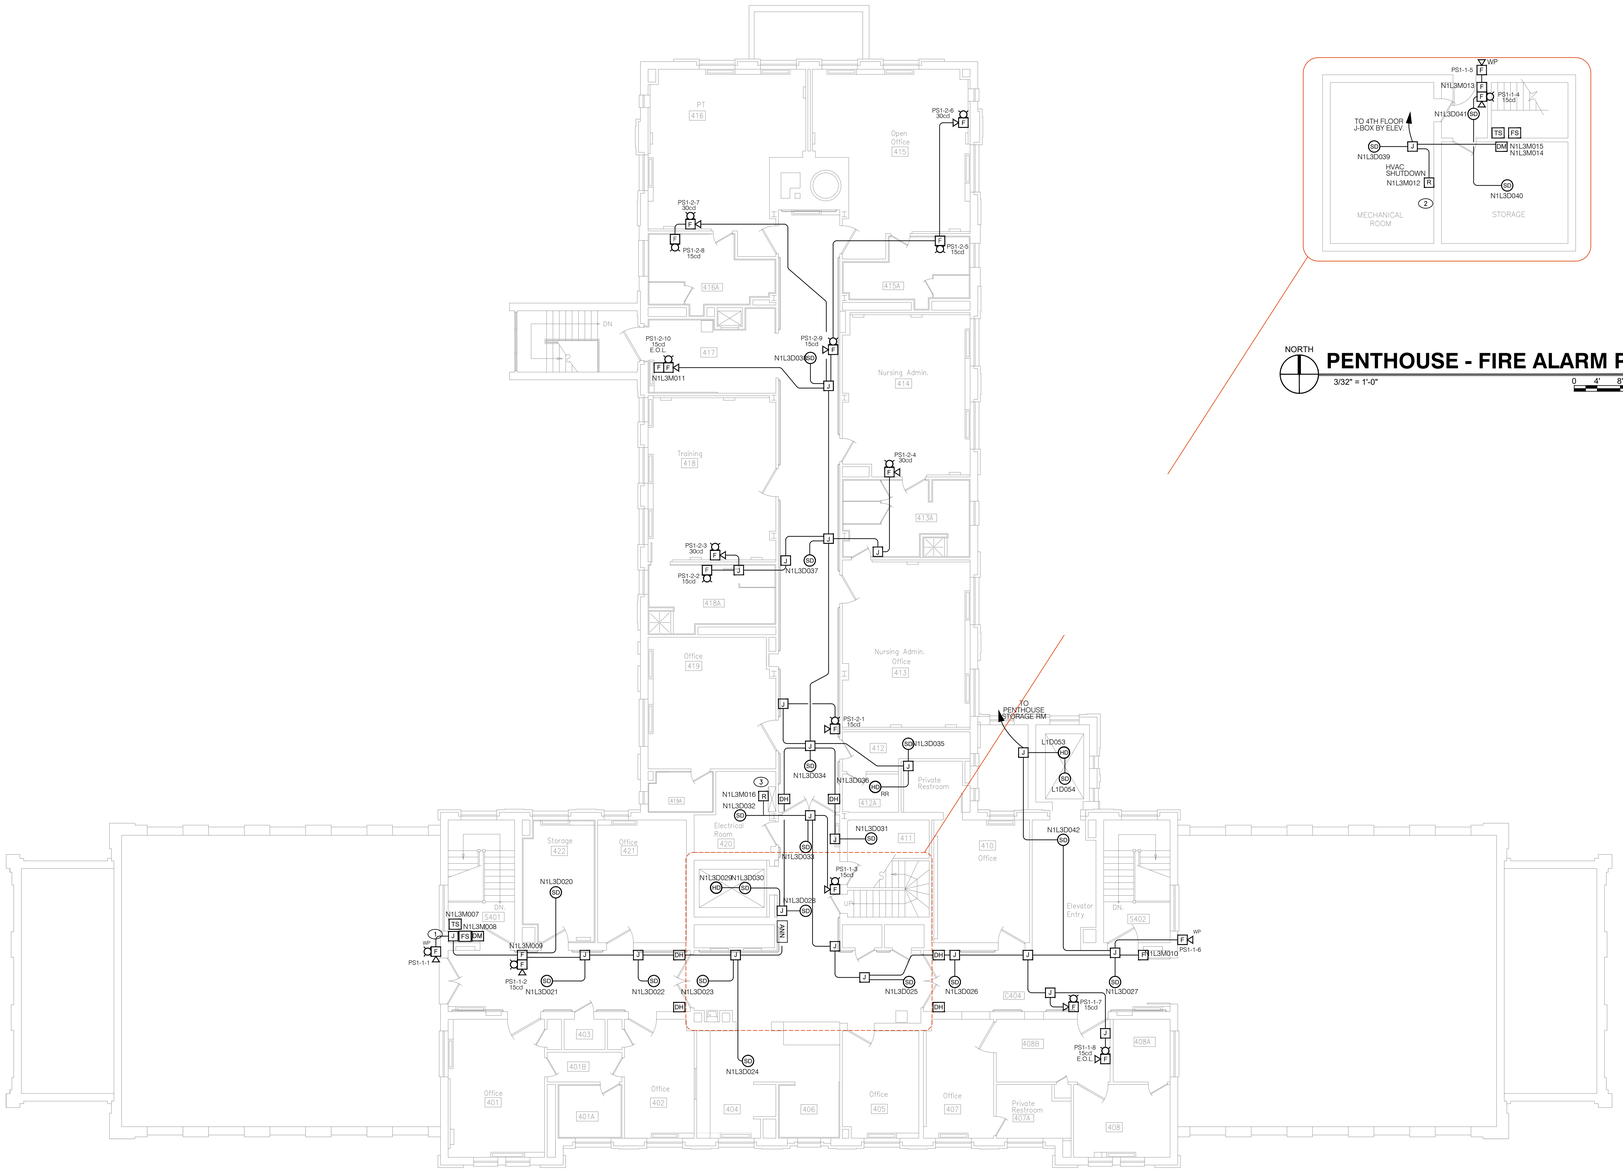

NORTH

PENTHOUSE - FIRE ALARM PLAN

3/32" = 1'-0"

0 4' 8' 16'

NORTH

FOURTH FLOOR - FIRE ALARM PLAN

3/32" = 1'-0"

0 4' 8' 16'

GENERAL NOTES

1. 7 ROOFTOP UNITS RELAY IN MECHANICAL CHASE FOR DAMPER CONTROL.
2. ALL RACEWAY TO BE 3/4" EMT OR 3/8" BX CABLE.
3. RELOCATE ANY EXISTING SMOKE DETECTORS THAT ARE 3' OR LESS FROM ANY SUPPLY REGISTER.
4. ALL SMOKE DETECTORS SHALL HAVE 30' SPACING AND BE LOCATED WITH IN 5' OF A DOOR HOLDER.
5. HALLWAY STROBES SHALL BE NO MORE THAN 50' APART.
6. RE-USE ANY EXISTING FIRE ALARM CABLE PROVIDED ITS COMPATIBLE WITH MANUFACTURER.

KEYED NOTES

1. VERTICAL RISER FROM 3RD FLR. ROUTE (2) #14AWG/2 CONDUCTOR CABLES FOR A TOTAL OF (2) NAC CKTs FOR ACPS#3. AND 24VDC POWER FOR DOOR HOLDERS.
2. RELAY FOR HVAC SHUTDOWN.
3. RELAY FOR ACCESS CONTROL SYSTEM.

DEVICE LEGEND

X	ISOLATION MODULE
F	FIRE ALARM PULL STATION MOUNTED 42"-54" AFF.
R	FIRE ALARM CONTROL RELAY
M	FIRE ALARM MONITOR MODULE RELAY
DM	FIRE ALARM DUEL MONITOR MODULE RELAY
FS	FIRE ALARM FLOW SWITCH
TS	FIRE ALARM VALVE TAMPER SWITCH
DH	DOOR HOLDER
SD	FIRE ALARM SMOKE DETECTOR
HD RR	FIRE ALARM HEAT DETECTOR RATE OF RISE
HD	FIRE ALARM HEAT DETECTOR FIXED
DD	DUCT DETECTOR
	FIRE ALARM WALL MOUNT STROBE ONLY MOUNTED 80" TO BOTTOM OF DEVICE.
	FIRE ALARM WALL MOUNT CHIME/STROBE MOUNTED 80" TO BOTTOM OF DEVICE.
	FIRE ALARM CEILING MOUNT STROBE ONLY
	FIRE ALARM CEILING MOUNT CHIME/STROBE
WP	FIRE ALARM WEATHERPROOF HORN/STROBE MOUNTED 80" TO BOTTOM OF DEVICE.
FACP	FIRE ALARM CONTROL PANEL
FAPS	EQ CABINET TO HOUSE (4) NEW ACPS-610 POWER SUPPLIES. TO SUPPORT EXISTING DOOR HOLDERS CKTs AND ALL NAC CKT's THROUGHOUT THE HOSPITAL.
NANN	FIRE ALARM NCA-2 NETWORK ANNUNCIATOR
ANN	FIRE ALARM ANNUNCIATOR LCD-160
PRN	PRN-6 80 COLUMN DOT MATRIX PRINTER

SUMMIT
FIRE & SECURITY
7131 WASHINGTON ST. N.E.
ALBUQUERQUE, NM 87109
(505) 884-1217

INDIAN HEALTH SERVICES
ALBUQUERQUE
INDIAN HOSPITAL
(ALBQ. SERVICE UNIT)
801 VASSAR DR. NE
ALBUQUERQUE NM, 87106

6	05/13/21	3RD FLOOR JAN AS-BUILT
5	03/08/21	1ST & 3RD FLOOR AS-BUILTS
4	01/18/17	AS-BUILTS
3	11/30/16	RELOCATE PRINTER TO MAINT.
		BLDG. DEMO PULL STATION IN
		3RD FL LOBBY 311/ AS-BUILT
2	08/17/15	AS-BUILT
1	03/02/15	ISSUE FOR CONSTRUCTION
0	10/31/14	PRELIMINARY BID
	DATE:	DESCRIPTION:

CHECKED BY:	B.B.
DRAWN BY:	V.F.
FILE NAME:	IHS ALBQ HOSP 4TH FL FA-5
SCALE:	1/8" = 1'-0"

SHEET TITLE:

4TH FLOOR

FIRE ALARM PLAN

FA-5

PAGE: 5 OF 7

W:\MISC\IHS\Albq Sites\Albq Hosp\Albq Hosp Fire Alarm As-Built\DWGS\IHS Albq Hosp 4th FA-5.dwg

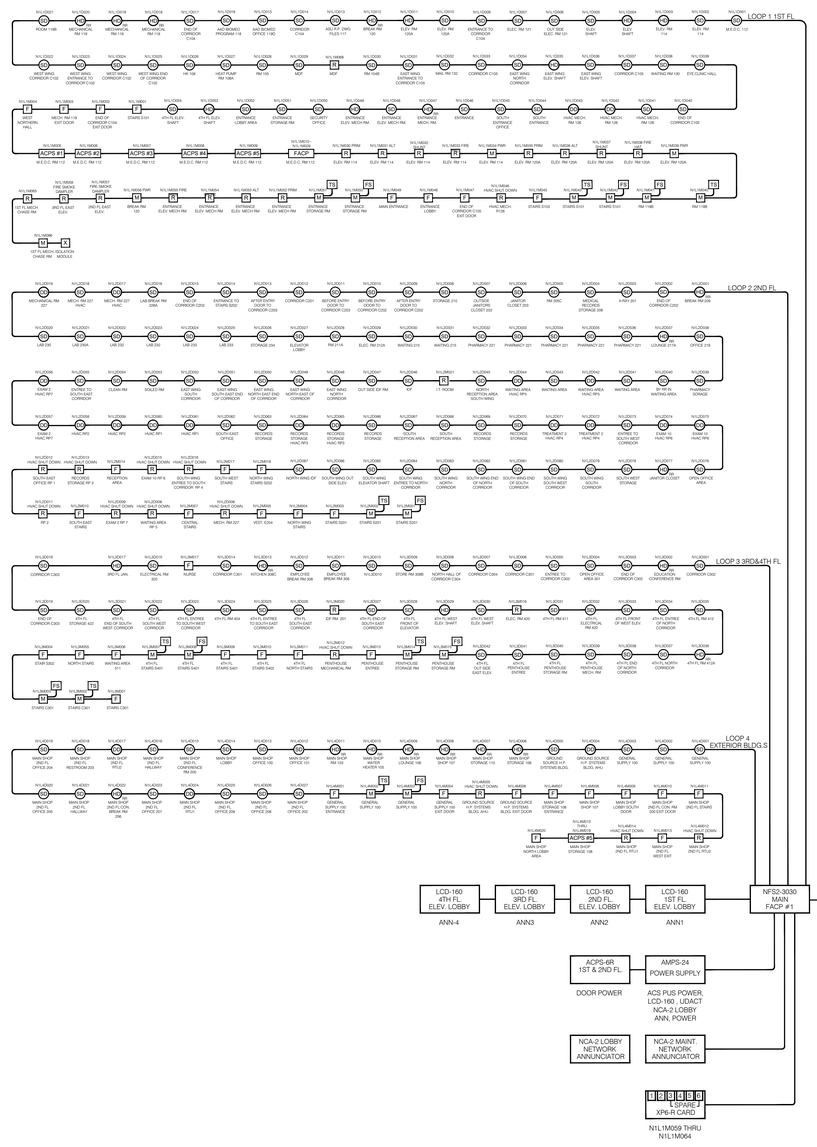

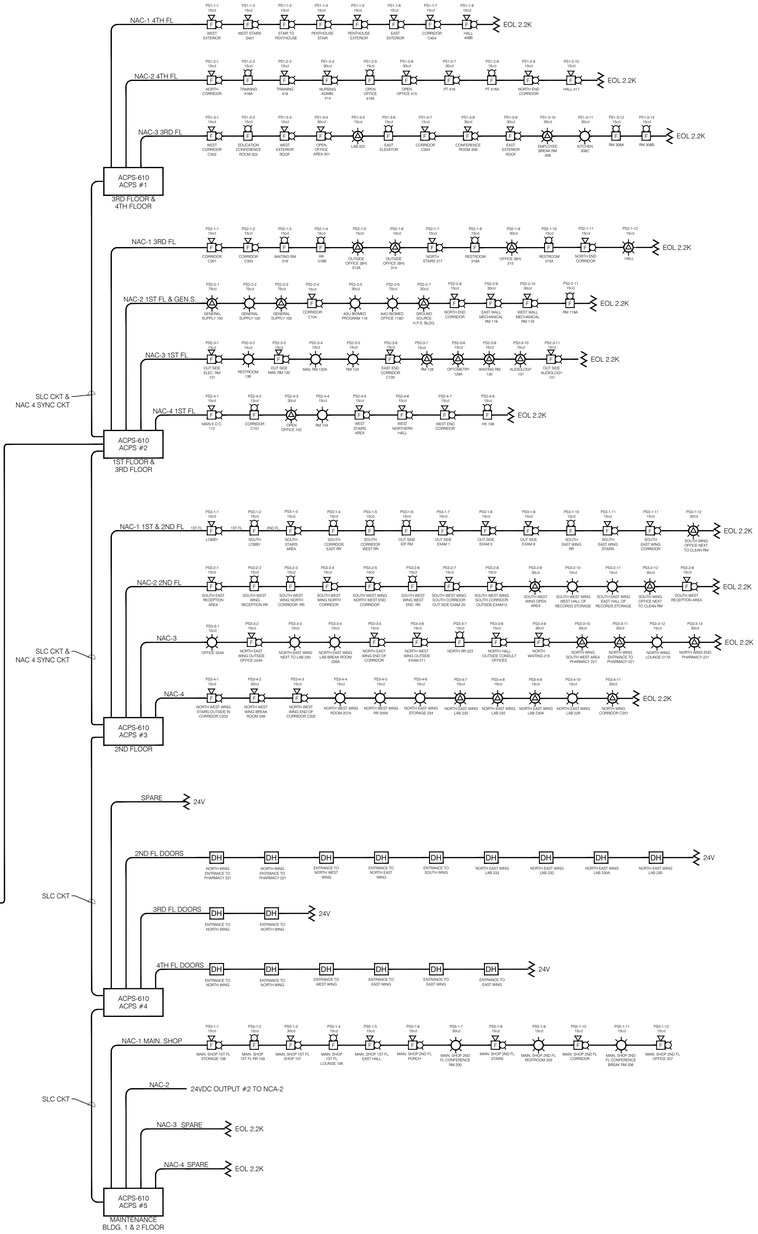

HEALTH CARE CENTER - GENERIC RISER DIAGRAM

SUMMIT FIRE & SECURITY
7131 WASHINGTON ST. N.E.
ALBUQUERQUE, NM 87109
(505) 884-1217

INDIAN HEALTH SERVICES
ALBUQUERQUE
INDIAN HOSPITAL
(ALBQ. SERVICE UNIT)
801 VASSAR DR. NE
ALBUQUERQUE NM, 87106

6	05/13/21	3RD FLOOR JAN AS-BUILT
5	03/08/21	1ST & 3RD FLOOR AS-BUILTS
4	01/18/17	AS-BUILTS
3	11/30/16	RELOCATE PRINTER TO MAINT.
		BLDG. DEMO PULL STATION IN
		3RD FL LOBBY 311/ AS-BUILT
2	08/17/15	AS-BUILT
1	03/02/15	ISSUE FOR CONSTRUCTION
0	10/31/14	PRELIMINARY BID
	DATE:	DESCRIPTION:

CHECKED BY:	B.B.
DRAWN BY:	V.F.
FILE NAME:	IHS ALBQ HOSP RISER FA-6
SCALE:	1/8" = 1'-0"

SHEET TITLE:

HEALTH CENTER RISER DIAGRAM

FA-6

PAGE: 6 OF 7

W:\MSC\IHS\Albq Sites\Albq Hosp\Albq Hosp Fire Alarm As-Built\DWGS\IHS Albq Hosp RISER FA-6.dwg

System Power Requirements

NOTIFIER by Honeywell

Notifier NFS2-3030 Fire Alarm Control Panel

Protected Premises: INDIAN HELTH SERVICES ALBUQUERQUE Date: 8/17/2015
Address: 801 VASSAR DR. N.E.
City: ALBUQUERQUE State: NEW MEXICO Zip: 87106

Prepared By: SOUND & SIGNAL SYSTEMS Phone: 505-884-1217
Address: 7131 WASHINGTON ST. N.E. Email:
City: ALBUQUERQUE State: NEW MEXICO Zip: 87109

Clear Project Information

AC Branch Current Requirements 5.00 AMPS @ 120 VAC Check
Current required by source to power the fire alarm system.

Primary Standby Load 1.60 Amps Check
Current load on the primary power supply during **non-alarm** conditions.

Primary Alarm Load 1.74 Amps Check
Current load on the primary power supply during **alarm** conditions.

Secondary Load Requirements 46.31 Amp Hours Check
Total Secondary Load from the calculation table below.

Current Draw		Time (hours)	Total (AH)
Secondary Standby Load 1.602 A	x	Required Standby Time 24 hours	38.45
Secondary Alarm Load 1.737 A	x	Required Alarm Time 0.084 hours	0.15
		Total Secondary Load	38.59
		Derating factor	x 1.2
		Secondary Load Requirements	**46.31** AH

(◉ USA ○ Canada)

Battery Selection 55 Amp Hours Check
Select batteries from the list below.
55 AH BAT-12550 Battery (12 volt)
(◉ Two ○ Four (two 12VDC sets in parallel))

Battery Distribution Chart
Shows amp-hour distribution of your selections.

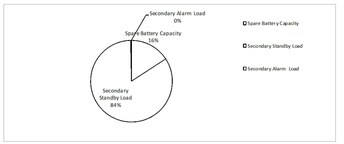

Comments
1. Battery size exceeds FACP capacity. BB-55 or other external battery box
2. Selected battery size meets secondary load requirements.
3. The selected batteries (55AH) are within the charger range of this power supply (12-60AH).

Spare Battery Capacity	8.69	Battery Selection (AH) - Secondary Load Requirements (AH)
Secondary Standby Load	46.14	Secondary Standby Load (AH) * Derating Factor
Secondary Alarm Load	0.18	Secondary Alarm Load (AH) * Derating Factor

Device Current Draw

NOTIFIER by Honeywell

NFS2-3030 Fire Alarm Control Panel

Quantity x [device current draw] = total current draw per device (in amps)

Part Number	Qty	Primary Non-Alarm	Primary Alarm	Secondary Non-Alarm
CPU2-3030	1	x [0.12000] = 0.12000	x [0.12000] = 0.12000	x [0.12000] = 0.12000
NCA2 - Backlight On	1	x [0.40000] = 0.40000	x [0.40000] = 0.40000	x [0.40000] = 0.40000
NCA2 - Backlight Off	1	x [0.20000] = 0.20000	x [0.20000] = 0.20000	x [0.20000] = 0.20000
LCM-320	2	x [0.13000] = 0.26000	x [0.13000] = 0.26000	x [0.13000] = 0.26000
LEM-320	2	x [0.10000] = 0.20000	x [0.10000] = 0.20000	x [0.10000] = 0.20000
LCD-160	4	x [0.30000] = 1.20000	x [0.32500] = 1.30000	x [0.30000] = 1.20000
UDACT-2 Communicator	1	x [0.05200] = 0.05200	x [0.08700] = 0.08700	x [0.05200] = 0.05200
SLC Loop Device Activation Current	4	x [0.00000] = 0.00000	x [0.20000] = 0.80000	x [0.00000] = 0.00000
Total (Amperes):		**2.4320 A**	**2.5670 A**	**2.4320 A**

Part Number	Qty	Secondary Alarm
Total Primary Alarm Load - C2	1	x [2.56700] = 2.56700
Total (Amperes):		**2.5670 A**

FACP

System Power Requirements

NOTIFIER by Honeywell

Notifier ACPS-610 Power Supply #1

Protected Premises: Indian Health Services Albuquerque Date: 3/8/2021
Address: 801 Vassar Drive N.E.
City: Albuquerque State: New Mexico Zip: 87106

Prepared By: Summit Fire & Security Phone: 505-884-1217
Address: 7131 Washington Street N.E. Email:
City: Albuquerque State: New Mexico Zip: 87109

Clear Project Information

AC Branch Current Requirements 5.00 AMPS @ 120 VAC Check
Current required by source to power the fire alarm system.

Primary Standby Load 0.13 Amps Check
Current load on the primary power supply during **non-alarm** conditions.

Primary Alarm Load 2.48 Amps Check
Current load on the primary power supply during **alarm** conditions.

Secondary Load Requirements 4.00 Amp Hours Check
Total Secondary Load from the calculation table below.

Current Draw		Time (hours)	Total (AH)
Secondary Standby Load 0.130 A	x	Required Standby Time 24 hours	3.12
Secondary Alarm Load 2.477 A	x	Required Alarm Time (hours) 0.084 hours	0.21
		Total Secondary Load	3.33
		Derating factor	x 1.2
		Secondary Load Requirements	**4.00** AH

(◉ USA ○ Canada)

Battery Selection 12 Amp Hours Check
Select batteries from the list below.
12 AH BAT-12120 Battery (12 volt)
(◉ Two ○ Four (two 12VDC sets in parallel))

Battery Distribution Chart
Shows amp-hour distribution of your

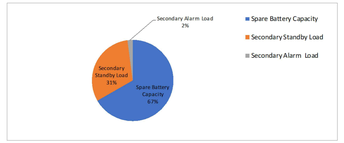

Comments
1. Batteries will fit in the FACP cabinet.
2. Selected battery size meets secondary load requirements.
3. The selected batteries (12AH) are within the charger range of this power supply (12-200AH).

Spare Battery Capacity	8.00	Battery Selection (AH) - Secondary Load Requirements (AH)
Secondary Standby Load	3.74	Secondary Standby Load (AH) * Derating Factor
Secondary Alarm Load	0.25	Secondary Alarm Load (AH) * Derating Factor

Device Current Draw

NOTIFIER by Honeywell

ACPS-610 Charger/Power Supply

Quantity x [device current draw] = total current draw per device (in amps)

Part Number	Qty	Primary Non-Alarm	Primary Alarm	Secondary Non-Alarm
ACPS-610 Charger	1	x [0.13000] = 0.13000	x [0.13000] = 0.13000	x [0.13000] = 0.13000
SR15	6	x [0.00000] = 0.00000	x [0.06600] = 0.39600	x [0.00000] = 0.00000
SR30	1	x [0.00000] = 0.00000	x [0.09400] = 0.09400	x [0.00000] = 0.00000
CHSR 15	10	x [0.00000] = 0.00000	x [0.07000] = 0.70000	x [0.00000] = 0.00000
CHSR 30	6	x [0.00000] = 0.00000	x [0.09900] = 0.59400	x [0.00000] = 0.00000
SCR30	1	x [0.00000] = 0.00000	x [0.09400] = 0.09400	x [0.00000] = 0.00000
CHSCRL15	1	x [0.00000] = 0.00000	x [0.05200] = 0.05200	x [0.00000] = 0.00000
CHSCRL30	1	x [0.00000] = 0.00000	x [0.07200] = 0.07200	x [0.00000] = 0.00000
HR	5	x [0.00000] = 0.00000	x [0.06900] = 0.34500	x [0.00000] = 0.00000
Total (Amperes):		**0.1300 A**	**2.4770 A**	**0.1300 A**

Part Number	Qty	Secondary Alarm
Total Alarm Load ACPS-610	1	x [2.47700] = 2.47700
Total (Amperes):		**2.4770 A**

ACPS #1

System Power Requirements

NOTIFIER by Honeywell

Notifier ACPS-610 Power Supply #2

Protected Premises: Indian Health Services Albuquerque Date: 3/8/2021
Address: 801 Vassar Drive N.E.
City: Albuquerque State: New Mexico Zip: 87106

Prepared By: Summit Fire & Security Phone: 505-884-1217
Address: 7131 Washington Street N.E. Email:
City: Albuquerque State: New Mexico Zip: 87109

Clear Project Information

AC Branch Current Requirements 5.00 AMPS @ 120 VAC Check
Current required by source to power the fire alarm system.

Primary Standby Load 0.13 Amps Check
Current load on the primary power supply during **non-alarm** conditions.

Primary Alarm Load 3.32 Amps Check
Current load on the primary power supply during **alarm** conditions.

Secondary Load Requirements 4.08 Amp Hours Check
Total Secondary Load from the calculation table below.

Current Draw		Time (hours)	Total (AH)
Secondary Standby Load 0.130 A	x	Required Standby Time 24 hours	3.12
Secondary Alarm Load 3.316 A	x	Required Alarm Time (hours) 0.084 hours	0.28
		Total Secondary Load	3.40
		Derating factor	x 1.2
		Secondary Load Requirements	**4.08** AH

(◉ USA ○ Canada)

Battery Selection 12 Amp Hours Check
Select batteries from the list below.
12 AH BAT-12120 Battery (12 volt)
(◉ Two ○ Four (two 12VDC sets in parallel))

Battery Distribution Chart
Shows amp-hour distribution of your

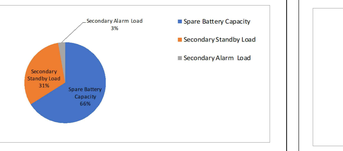

Comments
1. Batteries will fit in the FACP cabinet.
2. Selected battery size meets secondary load requirements.
3. The selected batteries (12AH) are within the charger range of this power supply (12-200AH).

Spare Battery Capacity	7.92	Battery Selection (AH) - Secondary Load Requirements (AH)
Secondary Standby Load	3.74	Secondary Standby Load (AH) * Derating Factor
Secondary Alarm Load	0.39	Secondary Alarm Load (AH) * Derating Factor

Device Current Draw

NOTIFIER by Honeywell

ACPS-610 Charger/Power Supply

Quantity x [device current draw] = total current draw per device (in amps)

Part Number	Qty	Primary Non-Alarm	Primary Alarm	Secondary Non-Alarm
ACPS-610 Charger	1	x [0.13000] = 0.13000	x [0.13000] = 0.13000	x [0.13000] = 0.13000
SR 15	7	x [0.00000] = 0.00000	x [0.06600] = 0.46200	x [0.00000] = 0.00000
CHSR 15	12	x [0.00000] = 0.00000	x [0.07000] = 0.84000	x [0.00000] = 0.00000
CHSR 30	4	x [0.00000] = 0.00000	x [0.09900] = 0.39600	x [0.00000] = 0.00000
SCR 15	4	x [0.00000] = 0.00000	x [0.06600] = 0.26400	x [0.00000] = 0.00000
SCR30	1	x [0.00000] = 0.00000	x [0.09400] = 0.09400	x [0.00000] = 0.00000
SCR 75	2	x [0.00000] = 0.00000	x [0.15800] = 0.31600	x [0.00000] = 0.00000
CHSCRL15	7	x [0.00000] = 0.00000	x [0.05200] = 0.36400	x [0.00000] = 0.00000
CHSCRL30	3	x [0.00000] = 0.00000	x [0.07200] = 0.21600	x [0.00000] = 0.00000
CHSCRL75	2	x [0.00000] = 0.00000	x [0.11700] = 0.23400	x [0.00000] = 0.00000
Total (Amperes):		**0.1300 A**	**3.1160 A**	**0.1300 A**

Part Number	Qty	Secondary Alarm
Total Alarm Load ACPS-610	1	x [3.31600] = 3.31600
Total (Amperes):		**3.3160 A**

ACPS #2

System Power Requirements

NOTIFIER by Honeywell

Notifier ACPS-610 Power Supply #3

Protected Premises: Indian Health Services Albuquerque Date: 3/8/2021
Address: 801 Vassar Drive N.E.
City: Albuquerque State: New Mexico Zip: 87106

Prepared By: Summit Fire & Security Phone: 505-884-1217
Address: 7131 Washington Street N.E. Email:
City: Albuquerque State: New Mexico Zip: 87109

Clear Project Information

AC Branch Current Requirements 5.00 AMPS @ 120 VAC Check
Current required by source to power the fire alarm system.

Primary Standby Load 0.13 Amps Check
Current load on the primary power supply during **non-alarm** conditions.

Primary Alarm Load 3.55 Amps Check
Current load on the primary power supply during **alarm** conditions.

Secondary Load Requirements 4.11 Amp Hours Check
Total Secondary Load from the calculation table below.

Current Draw		Time (hours)	Total (AH)
Secondary Standby Load 0.130 A	x	Required Standby Time 24 hours	3.12
Secondary Alarm Load 3.552 A	x	Required Alarm Time (hours) 0.084 hours	0.30
		Total Secondary Load	3.42
		Derating factor	x 1.2
		Secondary Load Requirements	**4.11** AH

(◉ USA ○ Canada)

Battery Selection 12 Amp Hours Check
Select batteries from the list below.
12 AH BAT-12120 Battery (12 volt)
(◉ Two ○ Four (two 12VDC sets in parallel))

Battery Distribution Chart
Shows amp-hour distribution of your

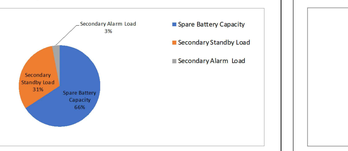

Comments
1. Batteries will fit in the FACP cabinet.
2. Selected battery size meets secondary load requirements.
3. The selected batteries (12AH) are within the charger range of this power supply (12-200AH).

Spare Battery Capacity	7.89	Battery Selection (AH) - Secondary Load Requirements (AH)
Secondary Standby Load	3.74	Secondary Standby Load (AH) * Derating Factor
Secondary Alarm Load	0.36	Secondary Alarm Load (AH) * Derating Factor

Device Current Draw

NOTIFIER by Honeywell

ACPS-610 Charger/Power Supply

Quantity x [device current draw] = total current draw per device (in amps)

Part Number	Qty	Primary Non-Alarm	Primary Alarm	Secondary Non-Alarm
ACPS-610 Charger	1	x [0.13000] = 0.13000	x [0.13000] = 0.13000	x [0.13000] = 0.13000
SR 15	9	x [0.00000] = 0.00000	x [0.06600] = 0.59400	x [0.00000] = 0.00000
CHSR 15	19	x [0.00000] = 0.00000	x [0.07000] = 1.33000	x [0.00000] = 0.00000
CHSR 30	2	x [0.00000] = 0.00000	x [0.09900] = 0.19800	x [0.00000] = 0.00000
SCR 15	10	x [0.00000] = 0.00000	x [0.06600] = 0.66000	x [0.00000] = 0.00000
CHSCRL15	4	x [0.00000] = 0.00000	x [0.05200] = 0.20800	x [0.00000] = 0.00000
CHSCRL30	6	x [0.00000] = 0.00000	x [0.07200] = 0.43200	x [0.00000] = 0.00000
Total (Amperes):		**0.1300 A**	**3.5520 A**	**0.1300 A**

Part Number	Qty	Secondary Alarm
Total Alarm Load ACPS-610	1	x [3.55200] = 3.55200
Total (Amperes):		**3.5520 A**

ACPS #3

System Power Requirements

NOTIFIER by Honeywell

Notifier ACPS-610 Power Supply

Protected Premises: INDIAN HEALTH SERVICES ALBUQUERQUE Date: 7/22/2015
Address: 801 VASSAR DR. N.E.
City: ALBUQUERQUE State: NEW MEXICO Zip: 87106

Prepared By: SOUND & SIGNAL SYSTEMS Phone: 505-884-1217
Address: 7131 WASHINGTON ST. N.E. Email:
City: ALBUQUERQUE State: NEW MEXICO Zip: 87109

Clear Project Information

AC Branch Current Requirements 5.00 AMPS @ 120 VAC Check
Current required by source to power the fire alarm system.

Primary Standby Load 0.45 Amps Check
Current load on the primary power supply during **non-alarm** conditions.

Primary Alarm Load 0.13 Amps Check
Current load on the primary power supply during **alarm** conditions.

Secondary Load Requirements 12.98 Amp Hours Check
Total Secondary Load from the calculation table below.

Current Draw		Time (hours)	Total (AH)
Secondary Standby Load 0.450 A	x	Required Standby Time 24 hours	10.80
Secondary Alarm Load 0.130 A	x	Required Alarm Time (hours) 0.084 hours	0.01
		Total Secondary Load	10.81
		Derating factor	x 1.2
		Secondary Load Requirements	**12.98** AH

(◉ USA ○ Canada)

Battery Selection 18 Amp Hours Check
Select batteries from the list below.
18 AH BAT-12180 Battery (12 volt)
(◉ Two ○ Four (two 12VDC sets in parallel))

Battery Distribution Chart
Shows amp-hour distribution of your

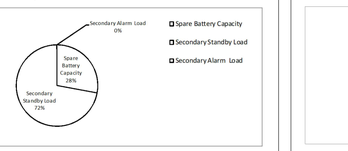

Comments
1. Battery size exceeds FACP capacity. BB-26 or other external battery
2. Selected battery size meets secondary load requirements.
3. The selected batteries (18AH) are within the charger range of this power supply (12-200AH).

Spare Battery Capacity	5.02	Battery Selection (AH) - Secondary Load Requirements (AH)
Secondary Standby Load	12.96	Secondary Standby Load (AH) * Derating Factor
Secondary Alarm Load	0.01	Secondary Alarm Load (AH) * Derating Factor

Device Current Draw

NOTIFIER by Honeywell

ACPS-610 Charger/Power Supply

Quantity x [device current draw] = total current draw per device (in amps)

Part Number	Qty	Primary Non-Alarm	Primary Alarm	Secondary Non-Alarm
ACPS-610 Charger	1	x [0.13000] = 0.13000	x [0.13000] = 0.13000	x [0.13000] = 0.13000
996 24V MAG. D-DOR HOLDER	16	x [0.02000] = 0.32000	x [0.00000] = 0.00000	x [0.02000] = 0.32000
Total (Amperes):		**0.4500 A**	**0.1300 A**	**0.4500 A**

Part Number	Qty	Secondary Alarm
Total Alarm Load ACPS-610	1	x [0.13000] = 0.13000
Total (Amperes):		**0.1300 A**

ACPS #4

System Power Requirements

NOTIFIER by Honeywell

Notifier ACPS-610 Power Supply #5

Protected Premises: Indian Health Services Albuquerque Date: 3/8/2021
Address: 801 Vassar Drive N.E.
City: Albuquerque State: New Mexico Zip: 87106

Prepared By: Summit Fire & Security Phone: 505-884-1217
Address: 7131 Washington Street N.E. Email:
City: Albuquerque State: New Mexico Zip: 87109

Clear Project Information

AC Branch Current Requirements 5.00 AMPS @ 120 VAC Check
Current required by source to power the fire alarm system.

Primary Standby Load 0.13 Amps Check
Current load on the primary power supply during **non-alarm** conditions.

Primary Alarm Load 1.01 Amps Check
Current load on the primary power supply during **alarm** conditions.

Secondary Load Requirements 3.85 Amp Hours Check
Total Secondary Load from the calculation table below.

Current Draw		Time (hours)	Total (AH)
Secondary Standby Load 0.130 A	x	Required Standby Time 24 hours	3.12
Secondary Alarm Load 1.006 A	x	Required Alarm Time (hours) 0.084 hours	0.08
		Total Secondary Load	3.20
		Derating factor	x 1.2
		Secondary Load Requirements	**3.85** AH

(◉ USA ○ Canada)

Battery Selection 12 Amp Hours Check
Select batteries from the list below.
12 AH BAT-12120 Battery (12 volt)
(◉ Two ○ Four (two 12VDC sets in parallel))

Battery Distribution Chart
Shows amp-hour distribution of your

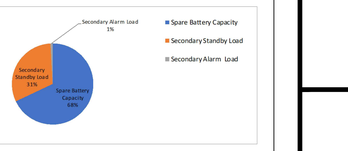

Comments
1. Batteries will fit in the FACP cabinet.
2. Selected battery size meets secondary load requirements.
3. The selected batteries (12AH) are within the charger range of this power supply (12-200AH).

Spare Battery Capacity	8.15	Battery Selection (AH) - Secondary Load Requirements (AH)
Secondary Standby Load	3.74	Secondary Standby Load (AH) * Derating Factor
Secondary Alarm Load	0.10	Secondary Alarm Load (AH) * Derating Factor

Device Current Draw

NOTIFIER by Honeywell

ACPS-610 Charger/Power Supply

Quantity x [device current draw] = total current draw per device (in amps)

Part Number	Qty	Primary Non-Alarm	Primary Alarm	Secondary Non-Alarm
ACPS-610 Charger	1	x [0.13000] = 0.13000	x [0.13000] = 0.13000	x [0.13000] = 0.13000
SR15	2	x [0.00000] = 0.00000	x [0.06600] = 0.13200	x [0.00000] = 0.00000
CHSR 15	5	x [0.00000] = 0.00000	x [0.07000] = 0.35000	x [0.00000] = 0.00000
CHSR 30	1	x [0.00000] = 0.00000	x [0.09900] = 0.09900	x [0.00000] = 0.00000
SCR 15	2	x [0.00000] = 0.00000	x [0.06600] = 0.13200	x [0.00000] = 0.00000
SCR30	1	x [0.00000] = 0.00000	x [0.09400] = 0.09400	x [0.00000] = 0.00000
HR	1	x [0.00000] = 0.00000	x [0.06900] = 0.06900	x [0.00000] = 0.00000
Total (Amperes):		**0.1300 A**	**1.0060 A**	**0.1300 A**

Part Number	Qty	Secondary Alarm
Total Alarm Load ACPS-610	1	x [1.00600] = 1.00600
Total (Amperes):		**1.0060 A**

ACPS #5

SUMMIT FIRE & SECURITY
7131 WASHINGTON ST. N.E.
ALBUQUERQUE, NM 87109
(505) 884-1217

INDIAN HEALTH SERVICES ALBUQUERQUE INDIAN HOSPITAL (ALBQ. SERVICE UNIT)
801 VASSAR DR. NE
ALBUQUERQUE NM, 87106

6	05/13/21	3RD FLOOR JAN AS-BUILT
5	03/08/21	1ST & 3RD FLOOR AS-BUILTS
4	01/18/17	AS-BUILTS
3	11/30/16	RELOCATE PRINTER TO MAINT.
		BLDG. DEMO PULL STATION IN
		3RD FL LOBBY 311/ AS-BUILT
2	08/17/15	AS-BUILT
1	03/02/15	ISSUE FOR CONSTRUCTION
0	10/31/14	PRELIMINARY BID
	DATE:	DESCRIPTION:

CHECKED BY:	B.B.
DRAWN BY:	V.F.
FILE NAME:	IHS ALBQ HOSP RISER FA-6
SCALE:	1/8" = 1'-0"

SHEET TITLE:

FIRE ALARM BATTERY CALCULATIONS

FA-7

PAGE: 7 OF 7

W:\MSO\IHS\Albq Sites\Albq Hosp\Albq Hosp Fire Alarm As-Built\DWG\IHS Albq Hosp CALCS FA-7.dwg