

WINDOW SCHEDULE

LOCATION	FRAME TYPE	FRAME MATERIAL	WINDOW SIZE (NOTE: ALL DIMENSIONS ARE TO OUT OF WINDOW FRAME.)	GLASS TYPES	DETAILS HEAD	DETAILS JAMB	DETAILS SILL	BLINDS	NOTES
A		HM	6'-0" X 4'-0"	I	21/A9.3	30+20//A9.3	27/A9.3	●	
B		HM	3'-0" X 4'-0"	I	21/A9.3	20/A9.3	27/A9.3	●	
C		HM	8'-0" X 4'-6"	I	22/A9.3	19/A9.4	28/A9.3	●	2/4
D		HM	3'-0" X 5'-0"	I	21/A9.3	20/A9.3	26/A9.3	●	
E		HM	3'-0" X 3'-0"	I	21/A9.3	20/A9.3	26/A9.3	●	
F		HM	2'-0" X 2'-0"	I	21/A9.3	20/A9.3	26/A9.3		
G		HM	2'-6" X 2'-6"	III	5/A9.3	5/A9.3	5/A9.3		
H		HM	3'-0" X 3'-8"	III	5/A9.3	5/A9.3	5/A9.3		
J		HM	4'-0" X 3'-8"	III	5/A9.3	5/A9.3	5/A9.3	●	3
K		HM	12|1'-8" X 1'-8"	II	21/A9.3	20/A9.3	26/A9.3	●	
L		AL	4'-0" X 3'-6"	III	3/A9.5	3/A9.5	4/A9.5		
M		AL	3'-0" X 3'-6"	III	3/A9.5	3/A9.5	4/A9.5		
N		HM	1'-0" X 1'-0"	III	5/A9.3	5/A9.3	5/A9.3		
L1			7'-0" X 2'-0"		11/A9.3	11/A9.3	17/A9.3		

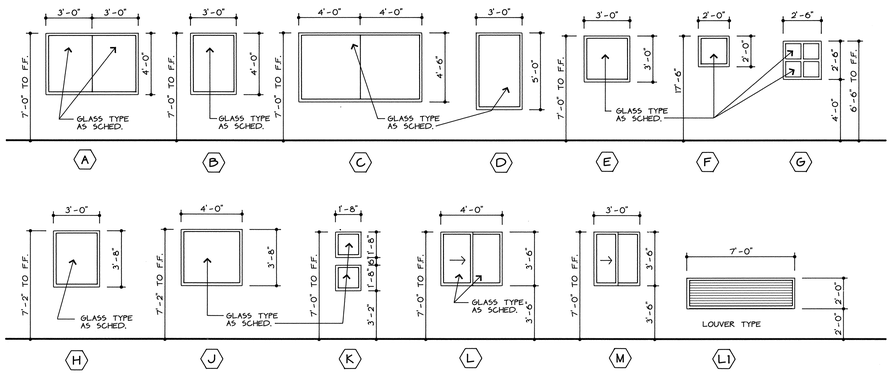


WINDOW TYPES


SCALE: 1/4"=1'-0"

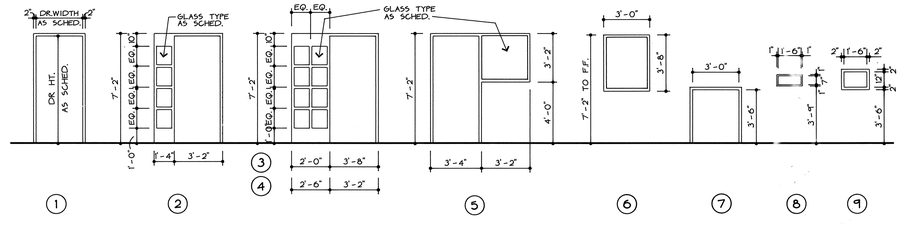

DOOR FRAME TYPES

SCALE: 1/4"=1'-0"

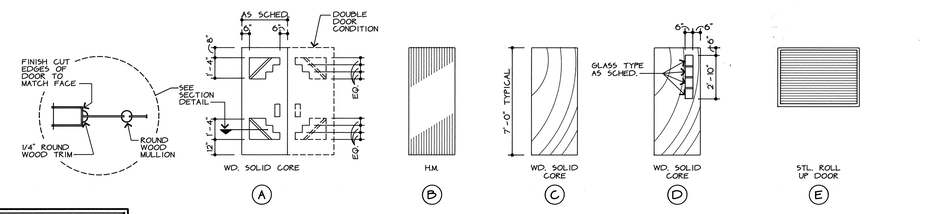

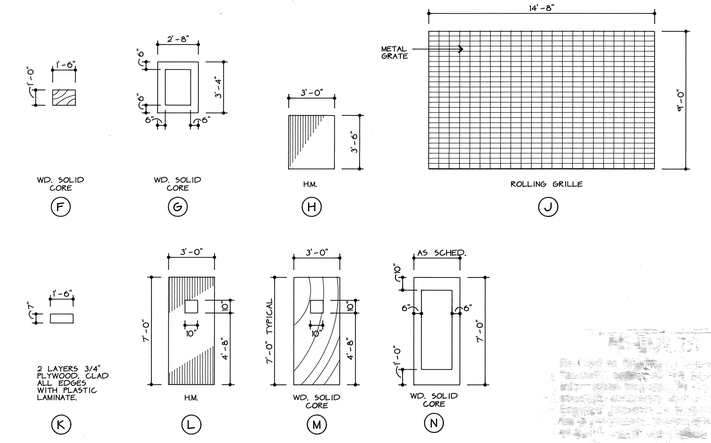

DOOR TYPES

SCALE: 1/4"=1'-0"

DOOR AND WINDOW NOTES

1. INSULATED DOOR
2. SEE DETAIL 24/A9.3 FOR END CONDITIONS.
3. NO BLINDS IN ROOM 902.
4. PROVIDE MEDIUM BRONZE ANODIZED SPACER IN INSULATED GLAZING.
5. EMERGENCY FRAME (NO RABBET) AND HARDWARE.

GENERAL NOTES

A. SEE SPECIFICATION FOR HARDWARE INFORMATION SECTION 08710 "FINISH HARDWARE"

B. ALL DOORS, DOOR AND WINDOW FRAMES TO BE PAINTED.


C. SEE DETAIL 11/A9.5 FOR FRAMING/SUPPORT REQUIREMENTS AT WALL MOUNTED DOOR STOP LOCATIONS.

GLASS TYPES

I - INSULATED TINTED LOW-E GLASS
II - INSULATED TINTED LOW-E SAFTY GLASS
III - 1/4" SAFETY GLASS

LEGEND

HM - HOLLOW METAL
WD - WOOD
STL - STEEL
MG - METAL GRATE
PL - PLASTIC LAMINATE CLAD 5/8" PLYWOOD

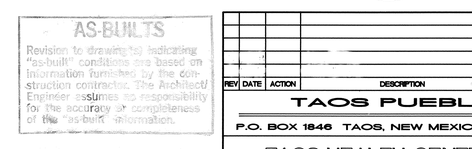

AS-BUILTS
Revision to drawing(s) indicating "as-built" conditions are based on information furnished by the construction contractor. The Architect/Engineer assumes no responsibility for the accuracy or completeness of the as-built information.

DOOR SCHEDULE

OPENING NO.	FRAME TYPE	FRAME MATERIAL	GLASS WINDOW	GLASS SIDELIGHT	GLASS TRANSOM	DOOR SIZE (NOTE: ALL DOORS ARE 1-3/4" THICK UNLESS NOTED OTHERWISE)	DOOR TYPE	DOOR MATERIALS	DOOR GLASS	FIRE RATING LABEL	FIRE RATING TIME	DETAILS HEAD	DETAILS JAMB	DETAILS SILL	HARDWARE SET	HAND	REMARKS	NOTES
100	1	HM				3'-0" X 7'-0" PR.,	A	WD	III			1/A9.3	7/A9.3	4/A9.3	1	RHR		
100A	1	HM				3'-0" X 7'-0" PR.	N	WD	III			3/A9.3	4/A9.3	4/A9.45IM	2	-		
100B	1	HM				2'-6" X 7'-0"	C	WD				3/A9.3	3/A9.3	4/A9.45IM	8	LHR		
102	1	HM				2'-10" X 7'-0" PR.	D	WD	III	C	20 MIN.	3/A9.3	10/A9.3	-	3			
103	3	HM	II			3'-6" X 7'-0"	A	WD	III			1/A9.3	2+7/A9.3	4+14/A9.3	4	RHR		
103A	3	HM	II			3'-6" X 7'-0"	N	WD	III			3/A9.3	3+2/A9.3	4+14/A9.3 5IM	5			
105	1	HM				2'-10" X 7'-0" PR.	D	WD	III	C	20 MIN.	3/A9.3	10/A9.3	-	3			
106	1	HM				3'-0" X 7'-0" PR.,	L	HM	III			1/A9.3	7/A9.3	13/A9.3	6	RHR		1
106A	1	HM				2'-10" X 7'-0" PR.	M	WD	III			3/A9.3	10/A9.3	-	7			
107	1	HM				2'-10" X 7'-0" PR.	D	WD	III	C	20 MIN.	3/A9.3	10/A9.3	-	3			
109	4	HM	II			3'-0"X 7'-0"	A	WD	III			1/A9.3	2+7/A9.3	4+14/A9.3	4			
109A	4	HM	II			3'-0" X 7'-0"	N	WD	III			3/A9.3	3+2/A9.3	4+14/A9.3 5IM	5	RHR		
113	1	HM				3'-0" X 7'-0"	C	WD				3/A9.3	3/A9.3	-	8	LH		
114	1	HM				3'-0" X 7'-0"	C	WD				3/A9.3	3/A9.3	-	9			
115	1	HM				3'-0" X 7'-0"	C	WD				3/A9.3	3/A9.3	-	9			
200	1	HM				3'-0" X 7'-0"	D	WD	III			3/A9.3	3/A9.3	-	10	LH		
200A						14'-8" X 90° OPNG. (VFY.)	J	MG				15/A9.3	16/A9.3					
201	1	HM				3'-0" X 7'-0"	C	WD				3/A9.3	3/A9.3	-	10	LH		
201A	1	HM				3'-0" X 7'-0"	C	WD				3/A9.3	3/A9.3	-	10	RHR		
300	1	HM				3'-0" X 7'-0"	C	WD				3/A9.3	3/A9.3	-	12			
302	1	HM				3'-0" X 7'-0"	C	WD				3/A9.3	3/A9.3	-	12			
303	1	HM	327A			3'-0" X 7'-0"	C	WD				3/A9.3	3/A9.3	-	12			
304	1	HM				3'-0" X 7'-0"	C	WD				3/A9.3	3/A9.3	-	12			
305	1	HM				3'-0" X 7'-0"	C	WD				3/A9.3	3/A9.3	-	12			
306	1	HM				3'-6" X 7'-0"	C	WD				3/A9.3	3/A9.3	-	12			
307	1	HM				3'-0" X 7'-0"	C	WD				3/A9.3	3/A9.3	-	12			
308	1	HM				3'-0" X 7'-0"	C	WD				3/A9.3	3/A9.3	-	13			
309	1	HM				3'-6" X 7'-0"	C	WD				3/A9.3	3/A9.3	-	12			
310	1	HM				3'-0" X 7'-0"	C	WD				3/A9.3	3/A9.3	-	8	RH		
311	1	HM				3'-0" X 7'-0"	C	WD				3/A9.3	3/A9.3	-	10	LH		
312	1	HM				3'-0" X 7'-0"	C	WD				3/A9.3	3/A9.3	-	12			
313	1	HM				3'-0" X 7'-0"	C	WD				3/A9.3	3/A9.3	-	12			
314	1	HM				3'-0" X 7'-0"	C	WD				3/A9.3	3/A9.3	-	10	RH		
315	1	HM				3'-0" X 7'-0"	D	WD	III			3/A9.3	3/A9.3	-	11	RH		
316	1	HM				3'-0" X 7'-0"	D	WD	III			3/A9.3	3/A9.3	-	11	RHR		
317	1	HM				3'-0" X 7'-0"	C	WD				3/A9.3	3/A9.3	-	12			
319	1	HM				3'-6" X 7'-0"	D	WD	III			3/A9.3	3/A9.3	-	11	RHR		
321	1	HM				3'-6" X 7'-0"	D	WD	III			3/A9.3	3/A9.3	-	11	LHR		
322	1	HM				3'-0" X 7'-0"	C	WD				3/A9.3	3/A9.3	-	12			
323	1	HM				3'-0" X 7'-0"	C	WD				3/A9.3	3/A9.3	-	12			
324	1	HM				3'-0" X 7'-0"	C	WD				3/A9.3	3/A9.3	-	12			
325	1	HM				3'-0" X 7'-0"	C	WD				-	25/A9.4	-	14			
327	1	HM				3'-0" X 7'-0"	C	WD				3/A9.3	3/A9.3	-	12			
327A	9	HM				1'-6" X 1'-0"	F	WD				3/A9.3	3/A9.3	3/A9.3	12			
328	1	HM				3'-0" X 7'-0"	C	WD				3/A9.3	3/A9.3	-	12			
329	1	HM				3'-0" X 7'-0"	C	WD				3/A9.3	3/A9.3	-	15	LH		
330	1	HM				3'-0" X 7'-0"	C	WD				3/A9.3	3/A9.3	-	12			
331	1	HM				3'-0" X 7'-0"	C	WD				3/A9.3	3/A9.3	-	12			
400	1	HM				3'-0" X 7'-0"	C	WD				-	25/A9.4	-	14			25/A9.4
401	1	HM				3'-0" X 7'-0"	D	WD	III			3/A9.3	3/A9.3	-	10	LH		
403	1	HM				3'-0" X 7'-0"	D	WD	III	C	20 MIN.	3/A9.3	3/A9.3	-	11	LH		
500	DOOR NUMBERS FOR FUTURE EXPANSION																	
600	1	HM				3'-0" X 7'-0"	C	WD				3/A9.3	3/A9.3	-	9			
601	1	HM				3'-0" X 7'-0"	C	WD				3/A9.3	3/A9.3	-	9			
602	1	HM				3'-0" X 7'-0"	C	WD				3/A9.3	3/A9.3	-	12			
603	1	HM				3'-0" X 7'-0"	D	WD	III			3/A9.3	3/A9.3	-	16			

DOOR SCHEDULE

OPENING NO.	FRAME TYPE	FRAME MATERIAL	GLASS WINDOW	GLASS SIDELIGHT	GLASS TRANSOM	DOOR SIZE (NOTE: ALL DOORS ARE 1-3/4" THICK UNLESS NOTED OTHERWISE)	DOOR TYPE	DOOR MATERIALS	DOOR GLASS	FIRE RATING LABEL	FIRE RATING TIME	DETAILS HEAD	DETAILS JAMB	DETAILS SILL	HARDWARE SET	HAND	REMARKS	NOTES
700	1	HM				3'-0" X 7'-10" PR.	B	HM				1/A9.3	7/A9.3	13/A9.3	17	LHR		1
700A	7	HM				3'-0" X 3'-6"	H	HM		B	3/4 HR.	12/A9.3	12/A9.3	18/A9.3	18	LHR		
700B	7	HM				3'-0" X 3'-6"	H	HM		B	3/4 HR.	12/A9.3	12/A9.3	18/A9.3	18	LHR		
700C	1	HM				3'-0" X 7'-0"	G	WD		B	3/4 HR.	3/A9.3	3/A9.3	-	15	LH		
701	1	HM				3'-0" X 7'-0"	B	HM				3/A9.3	3/A9.3	-	8	RH		
702	1	HM				3'-0" X 7'-0"	B	HM				3/A9.3	3/A9.3	-	8	LH		
800	1	HM				3'-0" X 7'-10" PR.	B	HM				1/A9.3	7/A9.3	13/A9.3	17	LHR		1
800A	5	HM		III		3'-0" X 7'-0"	L	HM	III	B	3/4 HR.	3/A9.3	2+3/A9.3	-	15	RH		
801	1	HM				3'-0" X 7'-0"	B	HM				1/A9.3	7/A9.3	13/A9.3	20	LHR		1
802	1	HM				3'-0" X 7'-10" PR.	B	HM				1/A9.3	7/A9.3	13/A9.3	17	LHR		1
803	5	HM		III		3'-0" X 7'-0"	C	WD				3/A9.3	2+3/A9.3	-	10	LH		
803A	5	HM		III		3'-0" X 7'-0"	C	WD				3/A9.3	3/A9.3	-	10	LH		
804	5	HM		III		3'-0" X 7'-0"	C	WD				3/A9.3	3/A9.3	-	12			
900	1	HM				3'-0" X 7'-0"	C	WD				3/A9.3	3/A9.3	-	10	LH		
901	1	HM				3'-6" X 7'-0"	M	WD	III			3/A9.3	3/A9.3	-	10	RH		
901A						4'-0" X 3'-6" OPNG	E	STL				19/A9.3	25/A9.3	4/A9.5	-			
902	1	HM				3'-0" X 7'-0"	C	WD				3/A9.3	3/A9.3	-	12			
1000	1	HM				3'-0" X 7'-0"	D	WD	III			3/A9.3	3/A9.3	-	10	LH		
1002	1	HM				3'-0" X 7'-0"	C	WD				3/A9.3	3/A9.3	-	8	RH		
1003	1	HM				3'-0" X 7'-0"	C	WD				3/A9.3	3/A9.3	-	8	RH		
1100	1	HM				3'-0" X 7'-0"	C	WD				3/A9.3	3/A9.3	-	10	RH		
1100A	1	HM				3'-0" X 7'-0"	C	WD				3/A9.3	3/A9.3	-	12			
1101	1	HM				3'-0" X 7'-0"	D	WD	III	C	20 MIN.	3/A9.3	3/A9.3	-	11	LH		
1101A	8	HM				1'-6" X 0'-7" X 1 1/2"	K	PL				23/A9.3	23/A9.3	23/A9.3	19			
1101B	6	HM				2'-8" X 3'-4" X 1 1/2"	G	WD	III			3/A9.3	3/A9.3	3/A9.3 5IM	12	RH		
1102	1	HM				3'-0" X 7'-0"	C	WD				3/A9.3	3/A9.3	-	10	RH		
1102A	1	HM				3'-0" X 7'-0"	C	WD				3/A9.3	3/A9.3	-	15	RHR		
1200	2	HM		III		3'-0" X 7'-0"	C	WD		C	20 MIN.	3/A9.3	3+2/A9.3	9/A9.4	11	RH		
1201	1	HM				3'-0" X 7'-0"	C	WD		C	20 MIN.	3/A9.03	3/A9.3	-	8	RH		
1202	1	HM				3'-0" X 7'-0"	C	WD				3/A9.3	3/A9.3	-	12			
1203	1	HM				3'-0" X 7'-0"	C	WD				3/A9.3	3/A9.3	-	12			
1204	1	HM				3'-0" X 7'-0"	C	WD				3/A9.3	3/A9.3	-	12			
1205	1	HM				3'-0" X 7'-0"	D	WD	III			3/A9.3	3/A9.3	-	10	RH		
1206	1	HM				3'-0" X 7'-0"	D	WD	III			3/A9.3	3/A9.3	-	11	LHR		
1206A	1	HM				3'-0" X 7'-0"	D	WD	III			3/A9.3	3/A9.3	-	12			
1207	1	HM				3'-0" X 7'-0"	C	WD				3/A9.3	3/A9.3	-	12			
1208	1	HM				3'-0" X 7'-0"	C	WD				3/A9.3	3/A9.3	-	12			
1209	1	HM				3'-0" X 7'-0"	C	WD				3/A9.3	3/A9.3	-	12			
1210	1	HM				3'-0" X 7'-0"	C	WD				3/A9.3	3/A9.3	-	12			
1211	1	HM				3'-0" X 7'-0"	C	WD				3/A9.3	3/A9.3	-	12			
1212	1	HM				3'-0" X 7'-0"	C	WD				3/A9.3	3/A9.3	-	8			
1300	1	HM				3'-0" X 7'-0"	C	WD				3/A9.3	3/A9.3	-	12			
1301	2	HM		III		3'-0" X 7'-0"	C	WD				3/A9.3	3+2/A9.3	9/A9.4	10	RH		
1302	1	HM				3'-0" X 7'-0"	C	WD				3/A9.3	3/A9.3	-	12			
1303	1	HM				3'-0" X 7'-0"	C	WD				3/A9.3	3/A9.3	-	12			
1304	1	HM				3'-0" X 7'-0"	C	WD				3/A9.3	3/A9.3	-	12			
1305	1	HM				3'-0" X 7'-0"	C	WD				3/A9.3	3/A9.3	-	12			
1400	1	HM				3'-0" X 7'-0"	C	WD				3/A9.3	3/A9.3	-	10	LH		
1402	1	HM				3'-0" X 7'-0"	C	WD				3/A9.3	3/A9.3	-	10	RHR		
1407	1	HM				3'-0" X 7'-0"	C	WD				3/A9.3	3/A9.3	-	12			
1409	1	HM				3'-0" X 7'-0"	D	WD	III			3/A9.3	3/A9.3	-	12			
1410	1	HM				3'-0" X 7'-0"	D	WD	III			3/A9.3	3/A9.3	-	12			

LOUIS L. WELLER, ARCHITECTS, PC
401-D ALVARADO DR. SE
ALBUQUERQUE, NEW MEXICO 87108 PHONE (505) 255-8270

REV	DATE	ACTION	DESCRIPTION	BY	APVD

TAOS PUEBLO
P.O. BOX 1846 TAOS, NEW MEXICO 87571

TAOS HEALTH CENTER
Taos, New Mexico

DEPARTMENT OF HEALTH & HUMAN SERVICES USA

DOOR and WINDOW SCHEDULE

PROJECT NUMBER | Scale AS SHOWN | Date 5/8/92 | Dwn. BRR,RT | Chkd. TJB | Apvd.

A9.2
SH. 33 OF 72

DOR.DGN 05/07/92-MB