KEYED NOTES

① EXTEND CONDUIT AND CABLE TO TELEVISION TERMINAL CABINET LOCATED IN ROOM 701.

② CABLE TROUGH SYSTEM INSTALLED IN CRAWL SPACE SHALL BE 12" WIDE x 6" DEEP, EQUAL TO T.J. COPE #1244 SERIES.

③ MAIN FIRE ALARM PANEL. REFER TO RISER DIAGRAM ON SHEET E-9.

④ NOT USED

⑤ SOUND SYSTEM TERMINAL CABINET FOR TERMINATION OF SOUND SYSTEM/PAGING. PROVIDE AMPLIFIER ALONG WITH TELEPHONE INTERFACE EQUIPMENT.

⑥ FURNISH AND INSTALL RACEWAY FROM CABLE TROUGH SYSTEM TO COMPUTER CABINET. RACEWAY SHALL BE EQUIPPED WITH REMOVABLE COVER AND KNOCKOUTS.

⑦ WEATHERPROOF SPEAKERS SHALL BE MOUNTED UP 9'--0" AFF.

HARVEY A. PEEL
NEW MEXICO
8851
91040
REGISTERED PROFESSIONAL ENGINEER
4/9/92

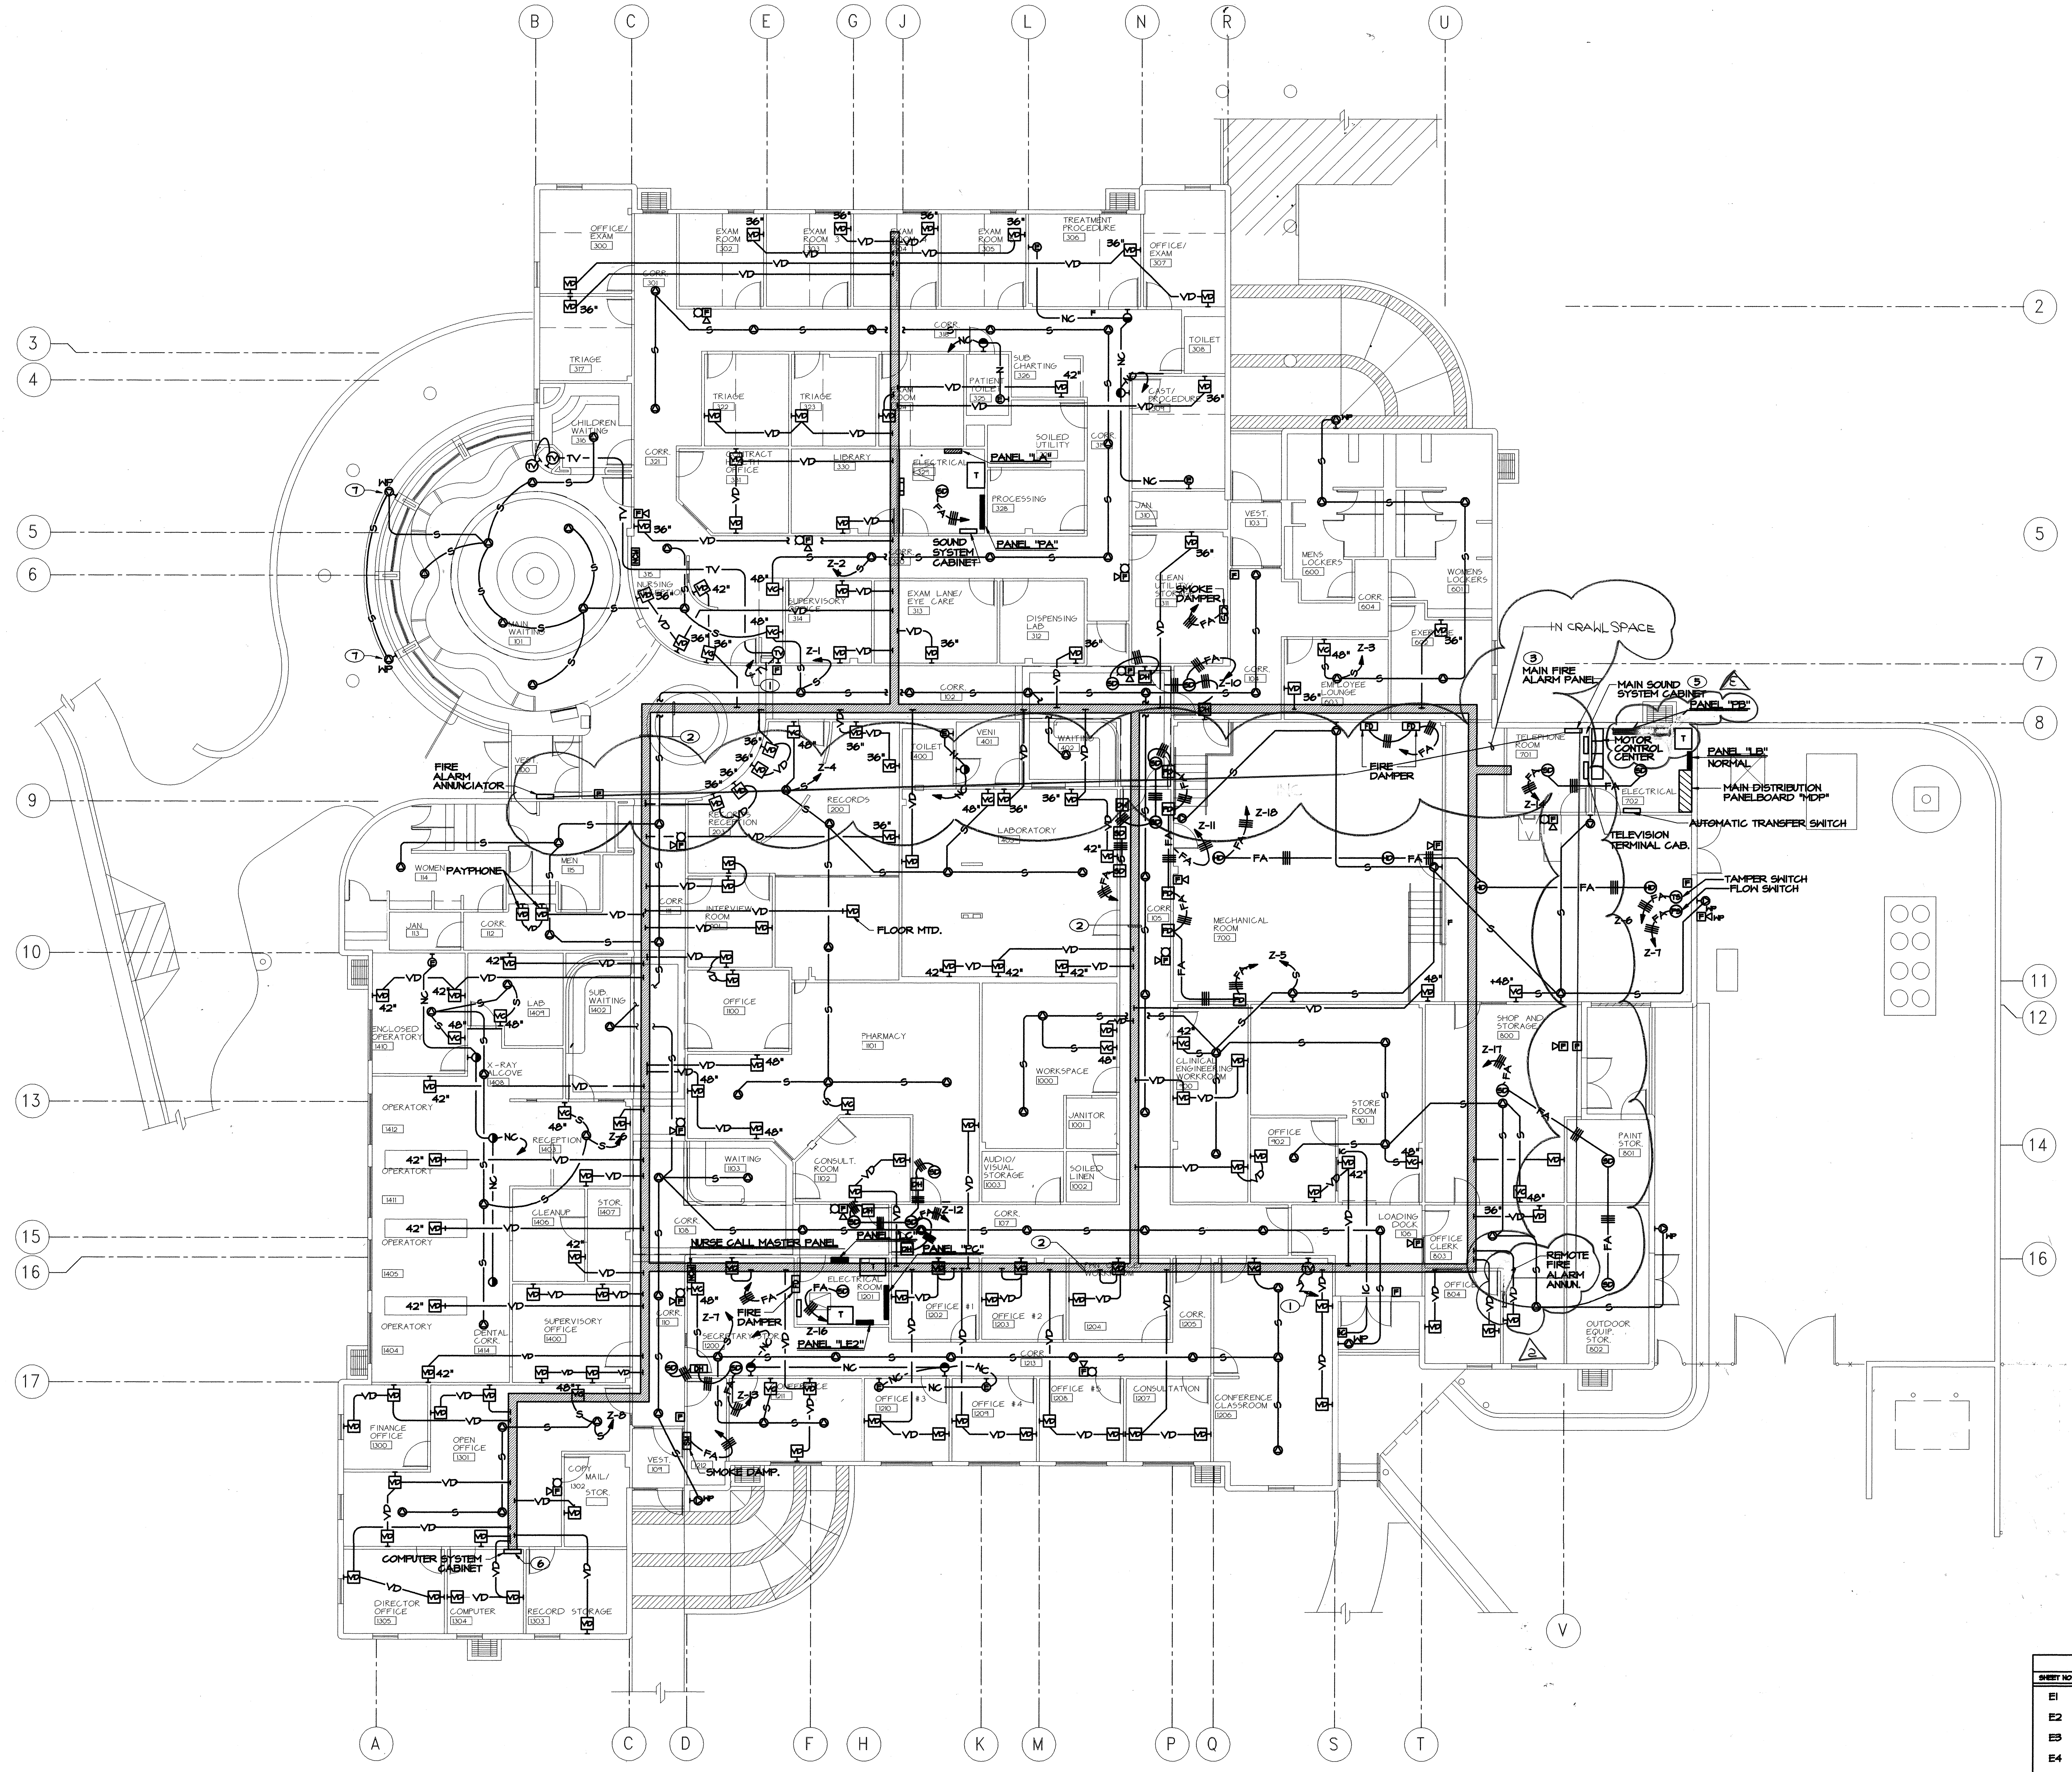
B
C
E
G
J
L
N
R
U
2
3
4
5
6
7
8
9
10
11
12
13
14
15
16
17
A
D
F
H
K
M
P
Q
S
T
V
IN CRAWL SPACE
MAIN FIRE ALARM PANEL
MAIN SOUND SYSTEM CABINET
MOTOR CONTROL CENTER
PANEL "PB"
PANEL "LB" NORMAL
MAIN DISTRIBUTION PANELBOARD "MDP"
AUTOMATIC TRANSFER SWITCH
TELEVISION TERMINAL CAB.
TAMPER SWITCH FLOW SWITCH
TELEPHONE ROOM 701
ELECTRICAL 702
PANEL "LA"
PANEL "PA"
SOUND SYSTEM CABINET
SMOKE DAMPER
FIRE DAMPER
FIRE ALARM ANNUNCIATOR
PAYPHONE
FLOOR MTD.
NURSE CALL MASTER PANEL
PANEL "LC"
PANEL "PC"
PANEL "LE2"
SMOKE DAMP.
COMPUTER SYSTEM CABINET
REMOTE FIRE ALARM ANNUN.
MAIN WAITING 101
CHILDREN WAITING
TRIAGE 317
PHARMACY 1101
MECHANICAL ROOM 700
LABORATORY
RECORDS
SHOP AND STORAGE 800
PAINT STOR. 801
OUTDOOR EQUIP. STOR. 802
LOADING DOCK
CONFERENCE CLASSROOM
DIRECTOR OFFICE 1305
COMPUTER 1304
RECORD STORAGE 1303

SPECIAL SYSTEMS PLAN

Scale: 1/8" = 1'-0"

AS-BUILTS
Revision to drawing(s) indicating "as-built" conditions are based on information furnished by the construction contractor. The Architect/Engineer assumes no responsibility for the accuracy or completeness of the "as-built" information.

REV	DATE	ACTION	DESCRIPTION	BY	APVD
3			RF158		
2	2-2-94		RFI 80		
1	1-26-94		REVISIONS	KH	

INDEX OF DRAWINGS

SHEET NO.	DESCRIPTION
E1	ELECTRICAL UTILITIES PLAN
E2	LIGHTING PLAN
E3	POWER PLAN
E4	SPECIAL SYSTEMS PLAN
E5	ELECTRICAL PLAN - CRAWL SPACE
E6	LIGHTNING PROTECTION PLAN
E7	ELECTRICAL SCHEDULES AND LEGEND
E8	NORMAL AND EMERGENCY PANEL SCHEDULES
E9	DIAGRAMS
E10	MISCELLANEOUS DETAILS

TAOS PUEBLO
P.O. BOX 1846 TAOS, NEW MEXICO 87571

TAOS HEALTH CENTER
Taos, New Mexico

DEPARTMENT OF HEALTH & HUMAN SERVICES · USA

SPECIAL SYSTEMS PLAN

PROJECT NUMBER	Scale 1/8"=1'	E4
	Date 5/8/92	
Drwn. TDS · Chkd. TDS	Apvd.	SH. 67 OF 73

LOUIS L WELLER, ARCHITECTS, PC
401-D ALVARADO DR. SE
ALBUQUERQUE, NEW MEXICO 87108
PHONE (505)-255-8270

File: \91\040\04039l.dwg, Scale: 0.125=12, Version: R11 C2
Last edited by: FC on 05/06/92-18:12 at Station: 14