BRIDGING DOCUMENTS

VA | U.S. Department of Veterans Affairs

Project Name: PARKING GARAGE STRUCTURAL EVALUATIONS
Project Address: RENO VAMC, 975 KIRMAN AVENUE, NV 89502

DRAWING SHEET INDEX

G-001	COVER PAGE
S-001	STRUCTURAL NOTES AND ABBREVIATIONS
S-100	GROUND LEVEL DAMAGE PLAN
S-100.1	2ND LEVEL DAMAGE PLAN
S-101	REPAIR DETAILS (1)
S-102	REPAIR DETAILS (2)



CONSULTANTS	ARCHITECT/ENGINEER OF RECORD	STAMP
	ALARES ARCHITECTS & ENGINEERS 248 Copeland Street Quincy, MA 02169 P: 617-481-6390 F: 617-687-5990	

Office of Construction and Facilities Management
VA U.S. Department of Veterans Affairs

Drawing Title: STRUCTURAL NOTES	Phase: BRIDGING DOCUMENTS NOT FOR CONSTRUCTION	Project Title: PARKING GARAGE REPAIR	Project Number:
Approved:		Location: Reno VAMC, 975 Kirman Ave, Reno, NV 89502	Building Number: BUILDING 13
			Drawing Scale: N/A
		Issue Date: 06.26.2026 / Checked: QS / Drawn: HA	Drawing Number: G-001

VA FORM 08 - 6231

STRUCTURAL NOTES

GENERAL NOTES

1. GENERAL NOTES ON THIS DRAWING REFER ONLY TO STRUCTURAL WORK WITH SCOPE OF WORK LIMITED TO GARAGE REPAIR.
2. THE STRUCTURAL NOTES ARE INTENDED TO COMPLEMENT THE PROJECT SPECIFICATIONS WHICH ARE PART OF THE CONTRACT DOCUMENTS. SPECIFIC NOTES AND DETAILS ON THE DRAWINGS SHALL GOVERN OVER STRUCTURAL NOTES AND TYPICAL DETAILS.
3. WORK SHALL CONFORM TO APPLICABLE BUILDING CODES, ORDINANCES, AND REGULATIONS. THE CONTRACTOR IS SOLELY RESPONSIBLE FOR MEANS, METHODS, TECHNIQUES AND PROCEDURES EMPLOYED IN THE PERFORMANCE OF WORK.
4. THE CONTRACTOR SHALL SUBMIT A WRITTEN REQUEST TO THE STRUCTURAL ENGINEER OF RECORDS BEFORE PROCEEDING WITH ANY CHANGES, SUBSTITUTIONS OR MODIFICATIONS. ANY WORK EXECUTED BY THE CONTRACTOR WITHOUT RECEIVING WRITTEN APPROVAL FROM THE STRUCTURAL ENGINEER OF RECORD WILL BE AT CONTRACTOR'S OWN RISK.
5. THE CONTRACT DOCUMENTS REPRESENT THE COMPLETED STRUCTURE. THE CONTRACTOR IS RESPONSIBLE FOR PROVIDING ADEQUATE TEMPORARY SHORING AND BRACING FOR STRUCTURAL ELEMENTS UNTIL THE ENTIRE STRUCTURAL SYSTEM IS COMPLETE.
6. THE CONTRACTOR SHALL VERIFY CONDITIONS AND DIMENSIONS AT THE SITE. IF ACTUAL CONDITIONS DIFFER FROM THOSE SHOWN ON CONTRACT DOCUMENTS, CONTRACTOR SHALL NOTIFY THE ENGINEER OF RECORD PRIOR TO FABRICATION OR CONSTRUCTION OF ANY AFFECTED ELEMENTS.
7. THE CONTRACTOR SHALL COORDINATE AND VERIFY OPENINGS, DEPRESSIONS, DIMENSIONS, ELEVATIONS, EQUIPMENT SIZES AND LOCATIONS, INCLUDING SUPPORTS, AND DETAILS AS DETERMINED BY OTHER TRADES/DISCIPLINES INCLUDING, BUT NOT LIMITED TO ARCHITECTURAL, MECHANICAL, AND ELECTRICAL BEFORE FABRICATING AND ERECTING STRUCTURAL ELEMENTS. SIZES, LOCATIONS AND ANY ELEMENT THAT DIFFERS FROM WHAT IS SHOWN ON THE DRAWINGS SHALL BE REPORTED TO THE STRUCTURAL ENGINEER OF RECORD.
8. DISCREPANCIES, CONFLICTS BETWEEN THE VARIOUS ELEMENTS OF THE CONTRACT DOCUMENTS SHALL BE BROUGHT TO THE ATTENTION OF THE STRUCTURAL ENGINEER OF RECORD BEFORE PROCEEDING WITH THE WORK INVOLVED. IN CASE OF CONFLICT, FOLLOW THE MOST STRINGENT REQUIREMENT AT NO ADDITIONAL COST TO THE OWNER.
9. DRAWINGS AND DETAILS HAVE BEEN PREPARED WITH THE INTENT TO VISUALLY REPRESENT INFORMATION PROVIDED IN SCALE FORM.
10. CONTRACTORS AND SUPPLIERS SHOULD NOT SCALE PLANS OR DETAILS FOR DIMENSIONAL INFORMATION.
11. LOCATIONS OF UTILITIES SHOWN ARE APPROXIMATE. THE CONTRACTOR IS RESPONSIBLE TO VERIFY LOCATION OF NEW AND EXISTING UTILITIES PRIOR TO BEGINNING DEMOLITION WORKS.
12. SITE VISITS OR OBSERVATIONS BY THE STRUCTURAL ENGINEER OF RECORD OR THEIR REPRESENTATIVE SHALL NEITHER CONSTITUTE SUPERVISION NOR APPROVAL OF WORK.
13. STRUCTURAL STEEL DIMENSIONS ARE TO CENTER LINE OF BEAMS AND TO THE BACK OF CHANNELS AND ANGLES, U.N.O.

EXISTING CONDITIONS

1. THE EXISTING CONDITIONS ARE REPRESENTED BASED ON ORIGINAL DRAWINGS MADE AVAILABLE BY THE VETERANS AFFAIRS (PLEASE REFER TO ORIGINAL DRAWINGS FOR MORE INFORMATION).
2. VERIFY DIMENSIONS, ELEVATIONS, AND DETAILS OF EXISTING STRUCTURES AND CONCRETE MASONRY UNIT (CMU) WALLS WHERE THEY AFFECT THIS CONSTRUCTION.
3. NOTIFY THE STRUCTURAL ENGINEER OF RECORD IF THERE ARE ANY DEVIATIONS FROM THE CONTRACT DOCUMENTS.
4. OBTAIN PRIOR APPROVAL FROM STRUCTURAL ENGINEER OF RECORD BEFORE CUTTING OPENINGS OR RECESSES OR MAKING OTHER MODIFICATIONS TO EXISTING STRUCTURE NOT SHOWN ON DRAWINGS.

ALTERNATIVE DESIGN

1. CONTRACTORS ALTERNATIVES SHALL BE SUBMITTED TO THE OWNER IDENTIFYING COST AND/OR SCHEDULE IMPACT PRIOR TO ENGINEERING REVIEW. ALTERNATE STRUCTURAL SYSTEMS SHALL INCLUDE CALCULATIONS AND DRAWINGS CERTIFIED BY A PROFESSIONAL STRUCTURAL ENGINEER PRIOR TO STRUCTURAL REVIEW. THE CALCULATIONS MUST SHOW THE EQUIVALENCY OF THE ALTERNATE. ACCEPTANCE OF THE ALTERNATE BY THE STRUCTURAL ENGINEER OF RECORD MUST BE IN WRITING.

MODIFICATIONS, SUBSTITUTIONS OR CHANGES

1. MODIFICATIONS, SUBSTITUTIONS OR CHANGES TO THE ORIGINAL CONTRACT DOCUMENTS MUST BE SUBMITTED TO THE STRUCTURAL ENGINEER OF RECORD PRIOR TO COMMENCING WORK.
2. WRITTEN AUTHORIZATION BY THE STRUCTURAL ENGINEER OF RECORD IS REQUIRED FOR FIELD MODIFICATIONS TO THE STRUCTURAL SYSTEM, INCLUDING BUT NOT LIMITED TO: CONNECTIONS, CUTTING OR DRILLING THROUGH ANY STRUCTURAL ELEMENT, CUTTING OR RELOCATING OF CONCRETE REINFORCEMENT, EMBEDDED PLATES AND BOLTS.

BASIS OF DESIGN

1. GOVERNING CODES: IBC 2024, ASCE 7-22, ACI 318-19
2. STRUCTURAL DESIGN CRITERIA
   - 2.1. DESIGN LOADS FOR GARAGE
     - 2.1.1. LIVE LOADS: 40 PSF
     - 2.1.2. MINIMUM CONCENTRATED LOAD: 3000 LB
   - 2.2. HANDRAIL SYSTEM
     - 2.2.1. MINIMUM CONCENTRATED LOAD AT ANY POINT: 200 LB
     - 2.2.2. MINIMUM DISTRIBUTED LOAD AT ANY DIRECTION: 50 LB/FT

CONCRETE

CONCRETE FOR WEATHER EXPOSED STRUCTURE:

1. ALL CONCRETE CONSTRUCTION SHALL CONFORM ACI 301 "SPECIFICATION FOR STRUCTURAL CONCRETE", ACI 305.1, ACI 306.1 UNLESS OTHERWISE NOTED.
2. ALL DETAILING, FABRICATION AND PLACING OF REINFORCING REBARS, UNLESS OTHERWISE NOTED, SHALL CONFORM TO ACI 318 "BUILDING CODE REQUIREMENTS FOR STRUCTURAL CONCRETE", ACI 117 AND THE ACI DETAILING MANUAL.
3. CONCRETE MUST REACH 4500 PSI AS 28-DAY COMPRESSIVE STRENGTH.
   MINIMUM CEMENTITIOUS CONTENT: 675 LB/CU.YD.
   MAX WATER-CEMENT RATIO (W/CM): 0.40
   NOMINAL MAX AGGREGATE SIZE: 3/4"
   AIR CONTENT (% BY VOLUME): 6%
   SPECIFIED SLUMP RANGE: 1" - 4"
   AIR ENTRAINING ADDITIVE: TO BE USED AS REQUIRED
   - A. ALL CEMENT SHALL BE TYPE I OR TYPE II PORTLAND CEMENT PER ASTM C150. TYPES IA AND IP ARE NOT ACCEPTABLE. USE ONE BRAND OF CEMENT THROUGHOUT PROJECT.
   - B. ALL CONCRETE USED FOR CAST-IN-PLACE CONCRETE STRUCTURAL ELEMENTS SHALL CONTAIN THE SPECIFIED WATER REDUCING OR WATER REDUCING/RETARDING ADMIXTURE. ALL CONCRETE SLABS, PLACED AT AIR TEMPERATURE BELOW 50°F SHALL CONTAIN THE SPECIFIED NON-CORROSIVE, NON-CHLORIDE ACCELERATOR. ALL CONCRETE PLACED AT AIR TEMPERATURE ABOVE 80°F SHALL CONTAIN SPECIFIED WATER-REDUCING/RETARDER ADMIXTURE. ALL CONCRETE REQUIRED TO BE AIR-ENTRAINED SHALL CONTAIN AN APPROVED AIR-ENTRAINING ADMIXTURE. ALL PUMPED CONCRETE SHALL CONTAIN THE SPECIFIED HIGH-RANGE WATER-REDUCING ADMIXTURE.
   - C. AGGREGATES SHALL COMPLY TO ASTM C33 AND NOT BE ALKALI-SILICA REACTIVE IN ACCORDING TO ASTM C1778. MAXIMUM TOTAL SULFUR LESS THAN 1%. WATER ABSORPTION LESS THAN 1%.
   - D. CALCIUM CHLORIDE SHALL NOT BE PERMITTED, NOT SHALL ANY ADMIXTURE CONTAINING CALCIUM CHLORIDE BE PERMITTED.

REINFORCEMENT:

1. REINFORCING BARS SHALL CONFORM TO ASTM A615, GRADE 60. NO TACK WELDING OF REINFORCING IN THE FIELD WILL BE PERMITTED.
2. DEFORMED BAR ANCHORS (DBA) SHALL CONFORM TO ASTM A1064, 70 KSI YIELD STRENGTH.
3. REINFORCEMENT SHALL BE CONTINUOUS THROUGH ALL CONSTRUCTION JOINJS UNLESS OTHERWISE NOTED ON DRAWINGS.
4. ALL HOOKS SHOWN ON THE DRAWINGS SHALL BE STANDARD HOOKS UNLESS OTHERWISE NOTED.
5. WHERE CONTINUOUS BARS ARE CALLED FOR, THEY SHALL RUN CONTINUOUSLY AROUND CORNERS AND BE LAPPED AT NECESSARY SPLICES, OR HOOKED AT DISCONTINUOUS ENDS. LAP LENGTHS SHALL BE AS GIVEN IN THE SPLICE AND DEVELOPMENT TABLE.
6. IN REINFORCED CONCRETE WALLS AND FOOTINGS PROVIDE CORNER DOWELS OF SAME SIZE AND SPACING AS HORIZONTAL REINFORCING. DOWELS SHALL HAVE A CLASS "B" LAP WITH HORIZONTAL REINFORCING IN EACH DIRECTION.
7. MINIMUM LAP SPLICE IS 18" FOR #4 REBARS.
8. UNLESS NOTED OTHERWISE, CONCRETE REINFORCING SHALL BE PLACED WITH PROPER COVER TO PROVIDE PROTECTION IN ACCORDANCE WITH ACI 318 AND WITHIN DEVIATION TOLERANCES LISTED IN ACI 117.
   - 8.1. GRADE BEAMS, FOOTINGS AND STRUCTURAL ELEMENTS AGAINST AND PERMANENTLY EXPOSED TO EARTH: 3"
   - 8.2. SLAB: 1-1/2"

EXISTING CONDITIONS AND SELECTED STRUCTURAL DEMOLITION

1. THE EXISTING CONDITIONS ARE REPRESENTED BASED ON ORIGINAL STRUCTURAL DOCUMENTS DATED MAY 15TH 1945.
2. VERIFY DIMENSIONS, ELEVATIONS, AND DETAILS OF EXISTING STRUCTURES WHERE THEY AFFECT THIS CONSTRUCTION.
3. NOTIFY THE STRUCTURAL ENGINEER OF RECORD IF THERE ARE ANY DEVIATIONS FROM THE CONTRACT DOCUMENTS.
4. OBTAIN PRIOR APPROVAL FROM THE STRUCTURAL ENGINEER OF RECORD BEFORE CUTTING OPENINGS OR RECESSES OR MAKING OTHER MODIFICATIONS TO EXISTING STRUCTURE NOT SHOWN ON STRUCTURAL DRAWINGS.
5. THE CONTRACTOR SHALL VISIT THE JOB SITE TO VERIFY EXISTING CONDITIONS, NOTING ANY DISCREPANCIES TO THE OWNER BEFORE DISTURBING EXISTING INSTALLATION. BEGINNING DEMOLITION WORK CONSTITUTES ACCEPTANCE OF EXISTING CONDITIONS.

SHOP DRAWINGS AND SUBMITTAL

1. SUBMITTALS AND SHOP DRAWINGS WILL BE REVIEWED BY THE STRUCTURAL ENGINEER OF RECORD FOR GENERAL CONFORMANCE ONLY. THIS REVIEW SHALL NOT RELIEVE THE CONTRACTOR OF THEIR RESPONSIBILITY FOR CORRECT DIMENSIONS AND QUANTITIES, DESIGN AND FABRICATION, AND PROPER FUNCTIONING OF MATERIALS AND EQUIPMENT, NOR IN ANY WAY ALTER THE REQUIREMENTS OF THE CONTRACT DOCUMENTS.
2. SHOP DRAWINGS OR RELATED SUBMITTALS SHALL NOT COMPRISE A VARIATION UNLESS PREVIOUSLY NOTED AND ACKNOWLEDGED BY THE ENGINEER OF RECORD.
3. IT IS THE CONTRACTOR'S RESPONSIBILITY TO REVIEW AND STAMP SHOP DRAWINGS PRIOR TO SUBMITTAL.
4. FABRICATION PRIOR TO THE STRUCTURAL ENGINEER OF RECORD APPROVAL IS AT THE OWNER'S AND FABRICATOR'S OWN RISK.
5. ENGINEERING DESIGN PROVIDED BY OTHERS AND SUBMITTED FOR REVIEW SHALL BEAR THE CERTIFICATION STAMP AND SIGNATURE OF A QUALIFIED AND LICENSED PROFESSIONAL ENGINEER.
6. SUBMIT FINAL SHOP DRAWINGS INCORPORATING REVIEW COMMENTS / CHANGES TO THE STRUCTURAL ENGINEER OF RECORD FOR RECORD FOR RECORD ONLY.
7. CONTRACTOR SHALL MAINTAIN TWO SETS OF RECORD DRAWINGS WHICH SHOW AS-BUILT DETAILS OF ALL ASPECTS OF THE STRUCTURE, FOR REVIEW DURING CONSTRUCTION AND FOR SUBMISSION AT THE END OF THE PROJECT.
8. THE CONTRACTOR SHALL PREPARE AND IMPLEMENT A TRAFFIC CONTROL PLAN THAT MAINTAINS SAFE VEHICULAR AND PEDESTRIAN ACCESS DURING CONSTRUCTION. THE PLAN SHALL INCLUDE PHASED WORK SEQUENCING, TEMPORARY LANE OR PARKING CLOSURES, BARRICADES, SIGNAGE, AND DETOURS AS REQUIRED TO MINIMIZE DISRUPTION TO FACILITY OPERATIONS AND EMERGENCY ACCESS.
9. REQUIRED SUBMITTALS.

HAND RAIL

1. HANDRAIL DESIGN SHALL FOLLOW IBC 2018 CHAPTER 1014.
2. IT IS THE CONTRACTOR'S RESPONSIBILITY TO REVIEW AND STAMP THE SHOP DRAWINGS BEFORE SUBMITTAL.
3. SUBMIT FINAL SHOP DRAWINGS INCORPORATING REVIEW COMMENTS/CHANGES TO THE STRUCTURAL ENGINEER OF RECORD FOR RECORD FOR RECORD ONLY.

STRUCTURAL ABBREVIATIONS

ARCH - ARCHITECT / ARCHITECTURAL	MAX - MAXIMUM
BLDG - BUILDING	MECH - MECHANICAL
B.OT. - BOTTOM	MIN - MINIMUM
CL - CENTERLINE	N.S. - NEAR SIDE
CONC - CONCRETE	O.C. - ON CENTER
CONN - CONNECTION	OPG - OPENING
CONT - CONTINUOUS / CONTINUOUSLY	PL - PENETRATION PLATE
DET - DETAIL	STG/STD - STEEL / STANDARD
DIA - DIAMETER	T.O.B - TOP OF BEAM ELEVATION
DWG - DRAWING	T.O.C - TOP OF CONCRETE
EX - EXISTING	TYP - TYPICAL
EQ - EQUAL	TRANSV - TRANSVERSE
FAB - FABRIC	TRIANG - TRIANGULAR
FS - FAR SIDE	U.N.O. - UNLESS NOTED OTHERWISE
FTG - FOOTING	V.I.F - VERIFY IN FIELD
GALV - GALVANIZED	W/ - WITH
LG - LONG	W/O - WITHOUT
	W - WIDE FLANGE

CONSULTANTS

ARCHITECT/ENGINEER OF RECORD

ALARES ARCHITECTS & ENGINEERS (SDVOSB)

248 Copeland Street
Quincy, MA 02169
P: 617-481-6390
F: 617-687-5990


STAMP

Office of Construction and Facilities Management

VA U.S. Department of Veterans Affairs

Drawing Title	STRUCTURAL NOTES AND ABBREVIATIONS
Phase	BRIDGING DOCUMENTS NOT FOR CONSTRUCTION
Approved:	
Project Title	PARKING GARAGE REPAIR
Location	Reno VAMC 975 Kirman Ave Reno, NV 89502
Issue Date	06.26.2026
Checked	QS
Drawn	HA
Project Number	
Building Number	BUILDING 13
Drawing Scale	N/A
Drawing Number	S-001

VA FORM 08 - 6231

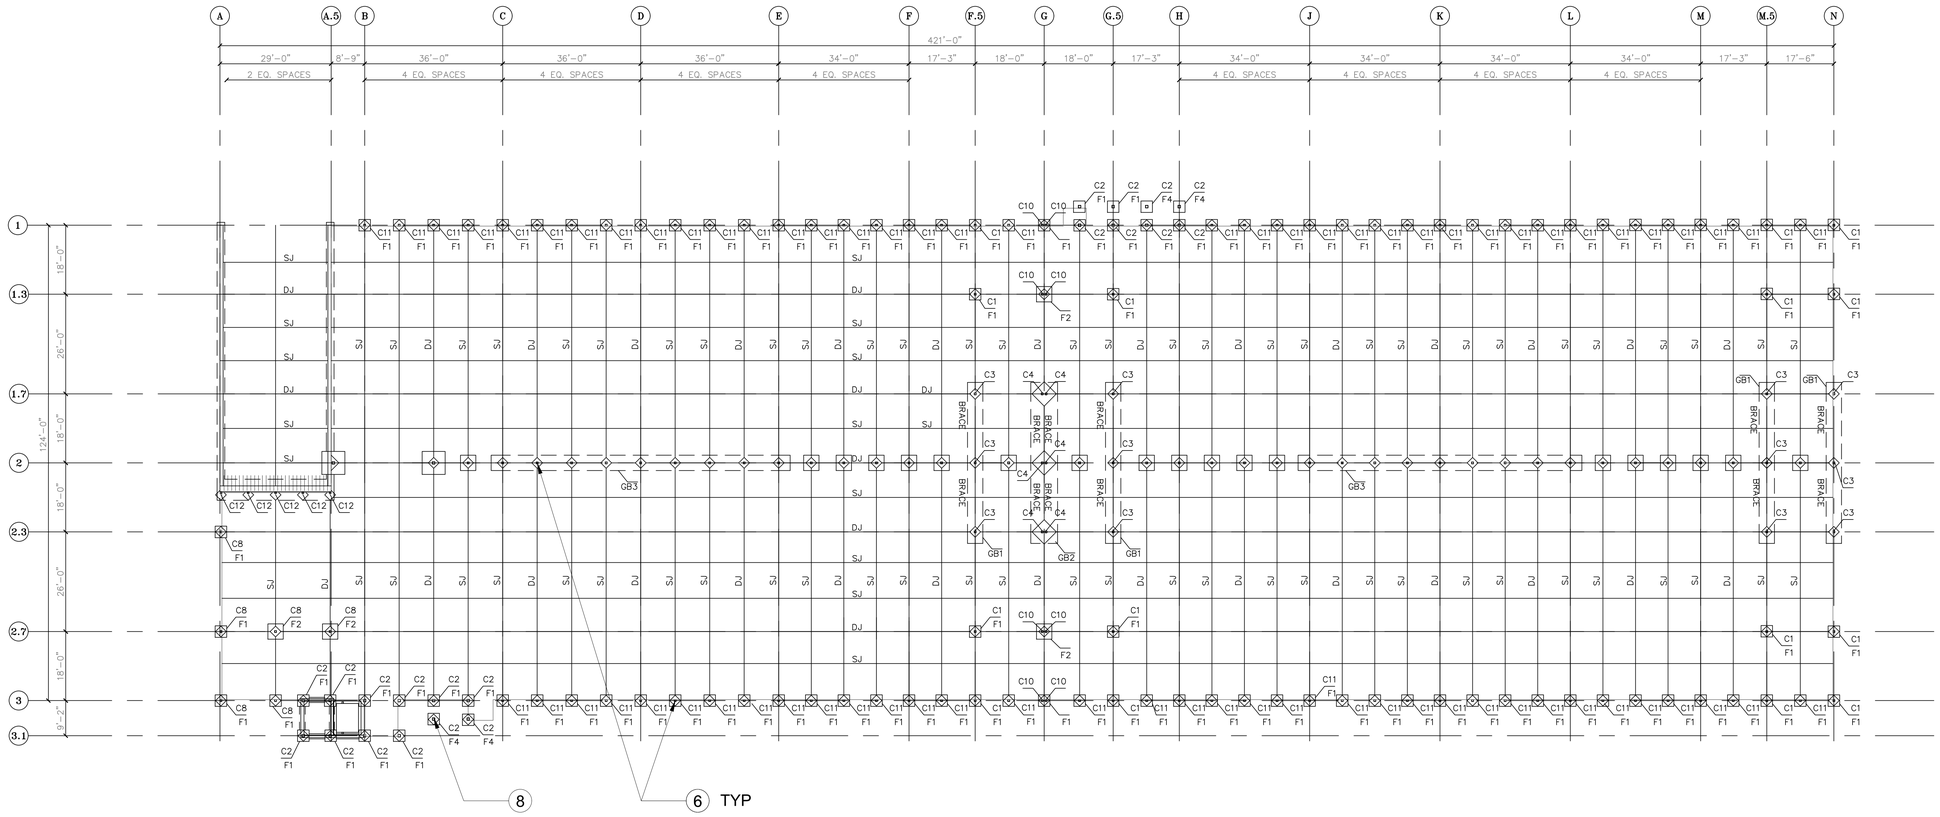

KEYNOTES: (NOT ALL KEYNOTES USED ON THIS SHEET)

1. DECK EDGE GAUGE METAL CLOSURE TYPICAL AROUND PERIMTER OF SLAB. CUT AND REMOVE WHERE SEVERE DETERIORARION OCCURS.
2. CONCRETE SPAULLING AND CORRODED REBAR AT SLAB EDGE. WIRE BRUSH AND PATCH.
3. METAL DECK UNDERSIDE OF SLAB CORROSION. CUT OUT DECKING WHERE DEBRIS MAY FALL.
4. PERIMETER COLUMN COOROSION AT EDGE OF SLAB AT LEVEL 2. WIRE BRUSH AND COAT.
5. CORROSION AT BASE OF COLUMN AT UPPER DECK. WIRE BRUSH AND COAT.
6. CORROSION AT BASE OF COLUMN AT LOWER DECK. WIRE BRUSH AND COAT.
7. TRAFFIC COATING FAILURE AND CONCRETE SPAULLING AT UPPER DECK. REPAIR WITH MORTAR AND PATCH TRAFFIC COATING.
8. STAIR PAN CORROSION. REPLACE OR REPAIR STEEL PAN.

CONSULTANTS

ARCHITECT/ENGINEER OF RECORD

ALARES ARCHITECTS & ENGINEERS
SDVOSB
248 Copeland Street
Quincy, MA 02169
P: 617-481-6390
F: 617-687-5990

STAMP

Office of Construction and Facilities Management

VA | U.S. Department of Veterans Affairs

Drawing Title: GROUND LEVEL DAMAGE PLAN

Approved:

Phase: BRIDGING DOCUMENTS NOT FOR CONSTRUCTION

Project Title: PARKING GARAGE REPAIR

Location: Reno VAMC, 975 Kirman Ave, Reno, NV 89502

Issue Date: 06.26.2026

Checked: QS

Drawn: HA


Project Number:

Building Number: BUILDING 13

Drawing Scale: 1/16" = 1'

Drawing Number: S-100

VA FORM 08 - 6231

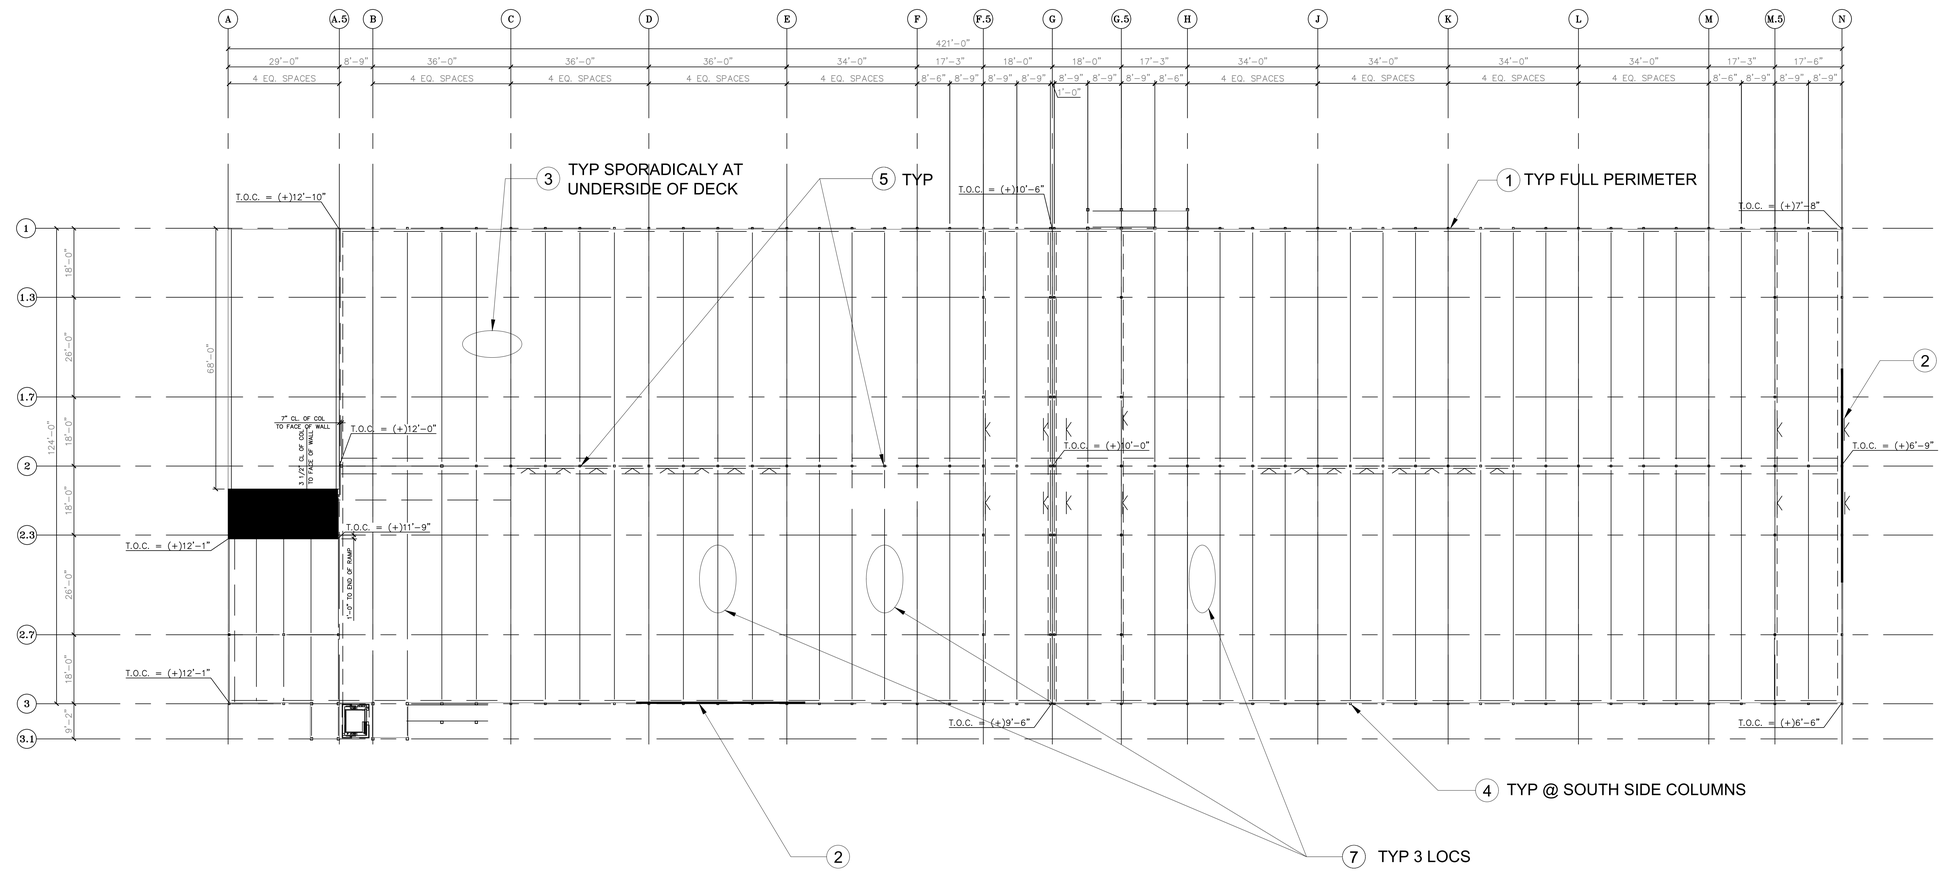

KEYNOTES: (NOT ALL KEYNOTES USED ON THIS SHEET)

1. DECK EDGE GAUGE METAL CLOSURE TYPICAL AROUND PERIMTER OF SLAB. CUT AND REMOVE WHERE SEVERE DETERIORARION OCCURS.
2. CONCRETE SPAULLING AND CORRODED REBAR AT SLAB EDGE. WIRE BRUSH AND PATCH.
3. METAL DECK UNDERSIDE OF SLAB CORROSION. CUT OUT DECKING WHERE DEBRIS MAY FALL.
4. PERIMETER COLUMN COOROSION AT EDGE OF SLAB AT LEVEL 2. WIRE BRUSH AND COAT.
5. CORROSION AT BASE OF COLUMN AT UPPER DECK. WIRE BRUSH AND COAT.
6. CORROSION AT BASE OF COLUMN AT LOWER DECK. WIRE BRUSH AND COAT.
7. TRAFFIC COATING FAILURE AND CONCRETE SPAULLING AT UPPER DECK. REPAIR WITH MORTAR AND PATCH TRAFFIC COATING.
8. STAIR PAN CORROSION. REPLACE OR REPAIR STEEL PAN.

CONSULTANTS	ARCHITECT/ENGINEER OF RECORD	STAMP					
	ALARES ARCHITECTS & ENGINEERS 248 Copeland Street Quincy, MA 02169 P: 617-481-6390 F: 617-687-5990		Office of Construction and Facilities Management VA U.S. Department of Veterans Affairs	Drawing Title: 2ND LEVEL DAMAGE PLAN Approved:	Phase: BRIDGING DOCUMENTS NOT FOR CONSTRUCTION	Project Title: PARKING GARAGE REPAIR Location: Reno VAMC, 975 Kirman Ave, Reno, NV 89502 Issue Date: 06.26.2026 / Checked: QS / Drawn: HA	Project Number Building Number: BUILDING 13 Drawing Scale: 1/16" = 1' Drawing Number: S-100.1


VA FORM 08 - 6231



DECK EDGE CORROSION

IMPORTANT NOTE:
1. ALWAYS REFER TO MANUFACTURER INSTRUCTIONS BEFORE PERFORMING ANY WORK.

PROCEDURE NOTE:
1. CUT AND REMOVE DAMAGED SECTIONS OF THE DECK EDGE.
2. CHIP OUT ALL LOOSE AND DETERIORATED CONCRETE AND CONCRETE COVER DOWN TO SOUND CONCRETE. REMOVE ANY EXISTING CONCRETE PATCH. DEMOLITION SHALL BE PERFORMED BY HAND SCRAPERS AND HYDRO-DEMOLITION FOR A THICKNESS NOT LESS THAN 1/4 INCH.
3. SANDBLAST REPAIRED SURFACES TO ACHIEVE A ROUGHENED SURFACE PROFILE WITH UNEVENNESS LESS THAN 1/16 INCH.
4. APPLY A PROTECTIVE COATING, SUCH AS SIKAGARD 550W/670W OR APPROVED EQUAL FOR ADDITIONAL PROTECTION OF STRUCTURES EXPOSED TO CHLORIDE-LADEN WATER SPLASHES.
5. APPLY A SPRAY-APPLIED CORROSION INHIBITOR, SUCH AS SIKA FERROGARD 903 OR APPROVED EQUAL, TO AREAS OUTSIDE THE REPAIR ZONE TO REDUCE CORROSION EFFECTS FROM CARBONATION AND SALT EXPOSURE.
6. FASTEN THE LOOSE END OF THE DECK EDGES.

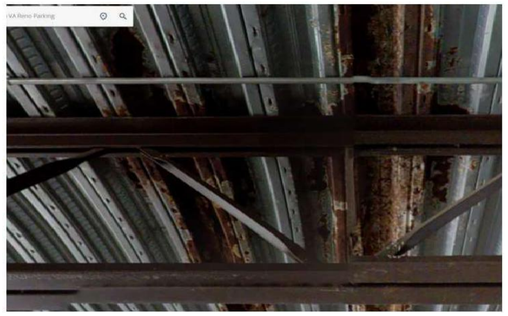

METAL DECK AT UNDERSIDE

IMPORTANT NOTE:
1. ALWAYS REFER TO MANUFACTURER INSTRUCTIONS BEFORE PERFORMING ANY WORK.

PROCEDURE NOTE:
1. CUT OUT AND REMOVE SEVERELY CORRODED PORTION OF THE DECK.
2. FASTEN THE LOOSE END OF THE DECK EDGES TO THE CONCRETE SLAB
3. IF SPALLING OF THE CONCRETE IS OCCURING, OR STEEL REINFORCEMENT IS EXPOSED, NOTIFY THE ENGINEER OF RECORD IN WRITING FOR FURTHER INVESTIGATION.
4. CHIP OUT ALL LOOSE AND DETERIORATED CONCRETE AND CONCRETE COVER DOWN TO SOUND CONCRETE. REMOVE ANY EXISTING CONCRETE PATCH. DEMOLITION SHALL BE PERFORMED BY HAND SCRAPERS AND HYDRO-DEMOLITION FOR A THICKNESS NOT LESS THAN 1/4 INCH.
5. APPLY A SPRAY-APPLIED CORROSION INHIBITOR, SUCH AS SIKA FERROGARD 903 OR APPROVED EQUAL, TO AREAS OF THE REPAIR ZONE TO REDUCE CORROSION EFFECTS FROM CARBONATION AND SALT EXPOSURE.



EXPOSED REBAR AND SPALLING ATSLAB EDGE

IMPORTANT NOTE:
1. ALWAYS REFER TO MANUFACTURER INSTRUCTIONS BEFORE PERFORMING ANY WORK.

PROCEDURE NOTE:
1. CUT AND REMOVE DAMAGED SECTIONS OF THE DECK EDGE.
2. CHIP OUT ALL LOOSE AND DETERIORATED CONCRETE AND CONCRETE COVER DOWN TO SOUND CONCRETE. REMOVE ANY EXISTING CONCRETE PATCH. DEMOLITION SHALL BE PERFORMED BY HAND SCRAPERS AND HYDRO-DEMOLITION FOR A THICKNESS NOT LESS THAN 1/4 INCH.
3. REMOVE DETERIORATED CONCRETE SURROUNDING REINFORCING BARS AND TIES AS REQUIRED FOR AT LEAST 3/8 INCH CLEARANCE ALL AROUND (OR A DISTANCE EQUAL TO THE REBAR DIAMETER IF LARGER THAN 3/8 INCH) TO ENSURE ACCESSIBILITY FOR CLEANING AND REPAIR.
4. CLEAN REINFORCING BARS AND TIES USING WIRE BRUSHES AND/OR WATER SANDBLASTING FOR LARGER REPAIR AREAS.
5. REMOVE DEBRIS AND CLEAN THE WORK AREA WITH COMPRESSED AIR.
6. INSPECT EXISTING REINFORCING BARS. NOTIFY THE ENGINEER OF RECORD IF REINFORCING STEEL SECTION LOSS EXCEEDS 20 PERCENT OF THE ORIGINAL BAR DIAMETER OR IF BAR CONTINUITY IS COMPROMISED.
7. APPLY TWO COATS OF CORROSION PROTECTION COATING TO CLEANED REINFORCING STEEL IN ACCORDANCE WITH THE MANUFACTURER'S REQUIREMENTS. USE SIKA ARMATEC 110 EPOCEM OR APPROVED EQUAL.
8. SATURATE THE REPAIR AREA WITH WATER AND REMOVE STANDING WATER WITH DAMP RAGS PRIOR TO MORTAR PLACEMENT.
9. APPLY A THIXOTROPIC, SHRINKAGE-COMPENSATED REPAIR MORTAR SUCH AS SIKATOP 123 PLUS OR APPROVED EQUAL.
10. PROVIDE A MINIMUM OF 24 HOURS OF WET CURING.
11. SANDBLAST REPAIRED SURFACES TO ACHIEVE A ROUGHENED SURFACE PROFILE WITH UNEVENNESS LESS THAN 1/16 INCH.
12. APPLY A PROTECTIVE COATING, SUCH AS SIKAGARD 550W/670W OR APPROVED EQUAL FOR ADDITIONAL PROTECTION OF STRUCTURES EXPOSED TO CHLORIDE-LADEN WATER SPLASHES.
13. APPLY A SPRAY-APPLIED CORROSION INHIBITOR, SUCH AS SIKA FERROGARD 903 OR APPROVED EQUAL, TO AREAS OUTSIDE THE REPAIR ZONE TO REDUCE CORROSION EFFECTS FROM CARBONATION AND SALT EXPOSURE.
14. FASTEN THE LOOSE END OF THE DECK EDGES.



TUBE COLUMNS AT THE PERIMETER OF THE ELEV. SLAB

IMPORTANT NOTE:
1. ALWAYS REFER TO MANUFACTURER INSTRUCTIONS BEFORE PERFORMING ANY WORK.

PROCEDURE NOTE:
1. WIRE BRUSH OR GROUND TO REMOVE RUST TO GET CLEAN STEEL.
2. APPLY ZINC-RICH PRIMER, OR TWO-PART EPOXY COATING.
3. FINISH WITH ACRYLIC PAINT.

CONSULTANTS

ARCHITECT/ENGINEER OF RECORD

ALARES ARCHITECTS & ENGINEERS
248 Copeland Street
Quincy, MA 02169
P: 617-481-6390
F: 617-687-5990

STAMP

Office of Construction and Facilities Management

VA U.S. Department of Veterans Affairs

Drawing Title: REPAIR DETAILS (1)

Phase: BRIDGING DOCUMENTS NOT FOR CONSTRUCTION

Approved:

Project Title: PARKING GARAGE REPAIR

Location: Reno VAMC, 975 Kirman Ave, Reno, NV 89502

Project Number:

Building Number: BUILDING 13

Drawing Scale: N/A

Drawing Number: S-101

Issue Date: 06.26.2026 | Checked: QS | Drawn: HA

VA FORM 08 - 6231



TYPICAL COLUMN AT UPPER DECK

IMPORTANT NOTE:
1. ALWAYS REFER TO MANUFACTURER INSTRUCTIONS BEFORE PERFORMING ANY WORK.

PROCEDURE NOTE:
1. WIRE BRUSH OR GROUND TO REMOVE RUST TO GET CLEAN STEEL.
2. APPLY ZINC-RICH PRIMER, OR TWO-PART EPOXY COATING.
3. FINISH WITH ACRYLIC PAINT TO THE LOWER 12" OF ALL COLUMNS FOR SNOW PROTECTION.



TYPICAL COLUMN AT LOWER DECK

IMPORTANT NOTE:
1. ALWAYS REFER TO MANUFACTURER INSTRUCTIONS BEFORE PERFORMING ANY WORK.

PROCEDURE NOTE:
1. WIRE BRUSH OR GROUND TO REMOVE RUST TO GET CLEAN STEEL.
2. APPLY ZINC-RICH PRIMER, OR TWO-PART EPOXY COATING.
3. FINISH WITH ACRYLIC PAINT TO THE LOWER 12" OF ALL COLUMNS FOR SNOW PROTECTION.



UPPER DECK CONCRETE AND COATING

IMPORTANT NOTE:
1. ALWAYS REFER TO MANUFACTURER INSTRUCTIONS BEFORE PERFORMING ANY WORK.

PROCEDURE NOTE:
1. CHIP OUT ALL LOOSE AND DETERIORATED CONCRETE AND CONCRETE COVER DOWN TO SOUND CONCRETE. REMOVE ANY EXISTING CONCRETE PATCH. DEMOLITION SHALL BE PERFORMED BY HAND SCRAPERS AND HYDRO-DEMOLITION FOR A THICKNESS NOT LESS THAN 1/4 INCH.
2. SATURATE THE REPAIR AREA WITH WATER AND REMOVE STANDING WATER WITH DAMP RAGS PRIOR TO MORTAR PLACEMENT.
3. APPLY A THIXOTROPIC, SHRINKAGE-COMPENSATED REPAIR MORTAR SUCH AS SIKATOP 123 PLUS OR APPROVED EQUAL.
4. PROVIDE A MINIMUM OF 24 HOURS OF WET CURING.
5. SANDBLAST REPAIRED SURFACES TO ACHIEVE A ROUGHENED SURFACE PROFILE WITH UNEVENNESS LESS THAN 1/16 INCH.
6. APPLY A PROTECTIVE COATING, SUCH AS SIKAGARD 550W/670W OR APPROVED EQUAL FOR ADDITIONAL PROTECTION OF STRUCTURES EXPOSED TO CHLORIDE-LADEN WATER SPLASHES.
7. APPLY A SPRAY-APPLIED CORROSION INHIBITOR, SUCH AS SIKA FERROGARD 903 OR APPROVED EQUAL, TO AREAS OUTSIDE THE REPAIR ZONE TO REDUCE CORROSION EFFECTS FROM CARBONATION AND SALT EXPOSURE.



SOUTH STAIRS

IMPORTANT NOTE:
1. ~~REPLACE THE EXISTING SOUTH STAIRS WITH A NEW PREFAB STAIRS OR PER OWNER'S DIRECTION.~~

1. Repair stair deterioration wherever applicable.

CONSULTANTS

ARCHITECT/ENGINEER OF RECORD

ALARES ARCHITECTS & ENGINEERS
SDVOSB
248 Copeland Street
Quincy, MA 02169
P: 617-481-6390
F: 617-687-5990

STAMP

Office of Construction and Facilities Management

VA U.S. Department of Veterans Affairs

Drawing Title: REPAIR DETAILS (2)

Phase: BRIDGING DOCUMENTS NOT FOR CONSTRUCTION

Approved:

Project Title: PARKING GARAGE REPAIR

Location: Reno VAMC, 975 Kirman Ave, Reno, NV 89502

Issue Date: 06.26.2026

Checked: QS

Drawn: HA

Project Number:

Building Number: BUILDING 13

Drawing Scale: N/A

Drawing Number: S-102

VA FORM 08 - 6231

FLOOR JOIST AND JOIST GIRDER NOTES

NOTES:
1. DESIGN CAMBER FOR 100% FOR DEAD LOAD MAX. ALLOWABLE LIVE LOAD DEFLECTION = L/360 TYP. CLAR
2. N/A
3. ALL JOISTS SHALL HAVE 7 1/2" BRG. DEPTHS.
4. JOISTS SHALL BE DESIGNED FOR THE APPROPRIATE LOAD COMBINATIONS IN ACCORDANCE WITH ASCE 7-02 SECTION 2.3.2 OR 2.4.1.
5. LIVE LOAD FOR JOISTS IS 40 PSF + 20 PSF SNOW LOAD, NON REDUCIBLE.
6. NOT USED.
7. JOIST DEPTHS SHOWN ON DRAWINGS ARE MAXIMUMS. JOIST MANUFACTURER MAY SUPPLY SHALLOWER MEMBERS OF THE SAME CONFIGURATIONS AT HIS OPTION.
8. SUPERIMPOSED DEAD LOAD DOES NOT INCLUDE WEIGHT OF JOISTS. IF JOIST WEIGHTS EXCEED THE WEIGHTS 7 PSF, JOIST MANUF. SHALL INFORM ENGINEER OF RECORD.
9. WHERE DETAILS CALL FOR JOIST MFR. TO DESIGN CONNECTIONS, CONNECTIONS SHALL BE ADEQUATE TO TRANSFER DEAD LOADS, SNOW LOADS, WIND LOADS, AND EARTHQUAKE LOADS SHOWN ON DRAWINGS.


SUSPENDED DECK FRAMING PLAN GENERAL NOTES

1. NOT USED.
2. SUSPENDED SLAB IS TO FOLLOW GRADE OF SLAB ON GRADE BELOW. TOP OF CONCRETE (T.O.C.) ON METAL DECK SHALL BE 11'-8" ABOVE SLAB ON GRADE, TYP. U.N.O. CAN BE GREATER. SEE CIVIL FOR GRADING PLAN.
3. FOR SUSPENDED RAMP, T.O.C. ON MTL DECK CAN BE LESS THAN 11'-8" FROM T.O. SLAB ON GRADE. MAINTAIN A CLR HEIGHT OF 8'-2" FROM T.O. SLAB TO BOTTOM OF STEEL. FOR SUSPENDED SLAB, SEE CIVIL FOR T.O.C. ELEVATIONS.
4. SEE 1/S6.1 FOR METAL DECK ATTACHMENT REQUIREMENTS.
5. DO – IS USED FOR JOIST SIZE U.N.O.
6. NOT USED.
7. FOR ADD'L REBAR SPECIFIED, STAGER REBAR SPLICES.
8. ALL WF's SHALL BE COMPOSITE W/ 3/4" DIA. x 5" STUDS. PROVIDE NUMBER OF STUDS AS INDICATED WITH 9X0 AFTER THE WF DESIGNATION. IF REQUIRED NUMBER OF STUDS IS NOT INDICATED, STUDS SHALL BE PLACED AT 12" o.c. MAX, U.N.O. SEE 3 AND 4/S6.1. CLAR

SUSPENDED DECK LOADING NOTES

1. LOAD LIMIT FOR ANY VEHICLE ON SUSPENDED DECK: 10000 LB GVW.
2. MAXIMUM SNOW STORAGE LOAD = 40 PSF AT ANY LOCATION.
3. NO FORKLIFTS ON DECK.
4. RUBBER BLADE SNOWPLOW ONLY.
5. PNUEMATIC-TIRED VEHICLES ONLY. MAXIMUM TIRE PRESSURE 120 PSI.
6. ALLOWABLE VEHICLES ARE PASSENGER VEHICLES AND PICKUP TRUCKS UP TO A 1 TON RATING.
7. NO RV's.

T.O.C. ELEVATIONS ARE IN RESPECT TO DATUM ELEVATION. SEE S2.1 FOR DATUM ELEVATION.

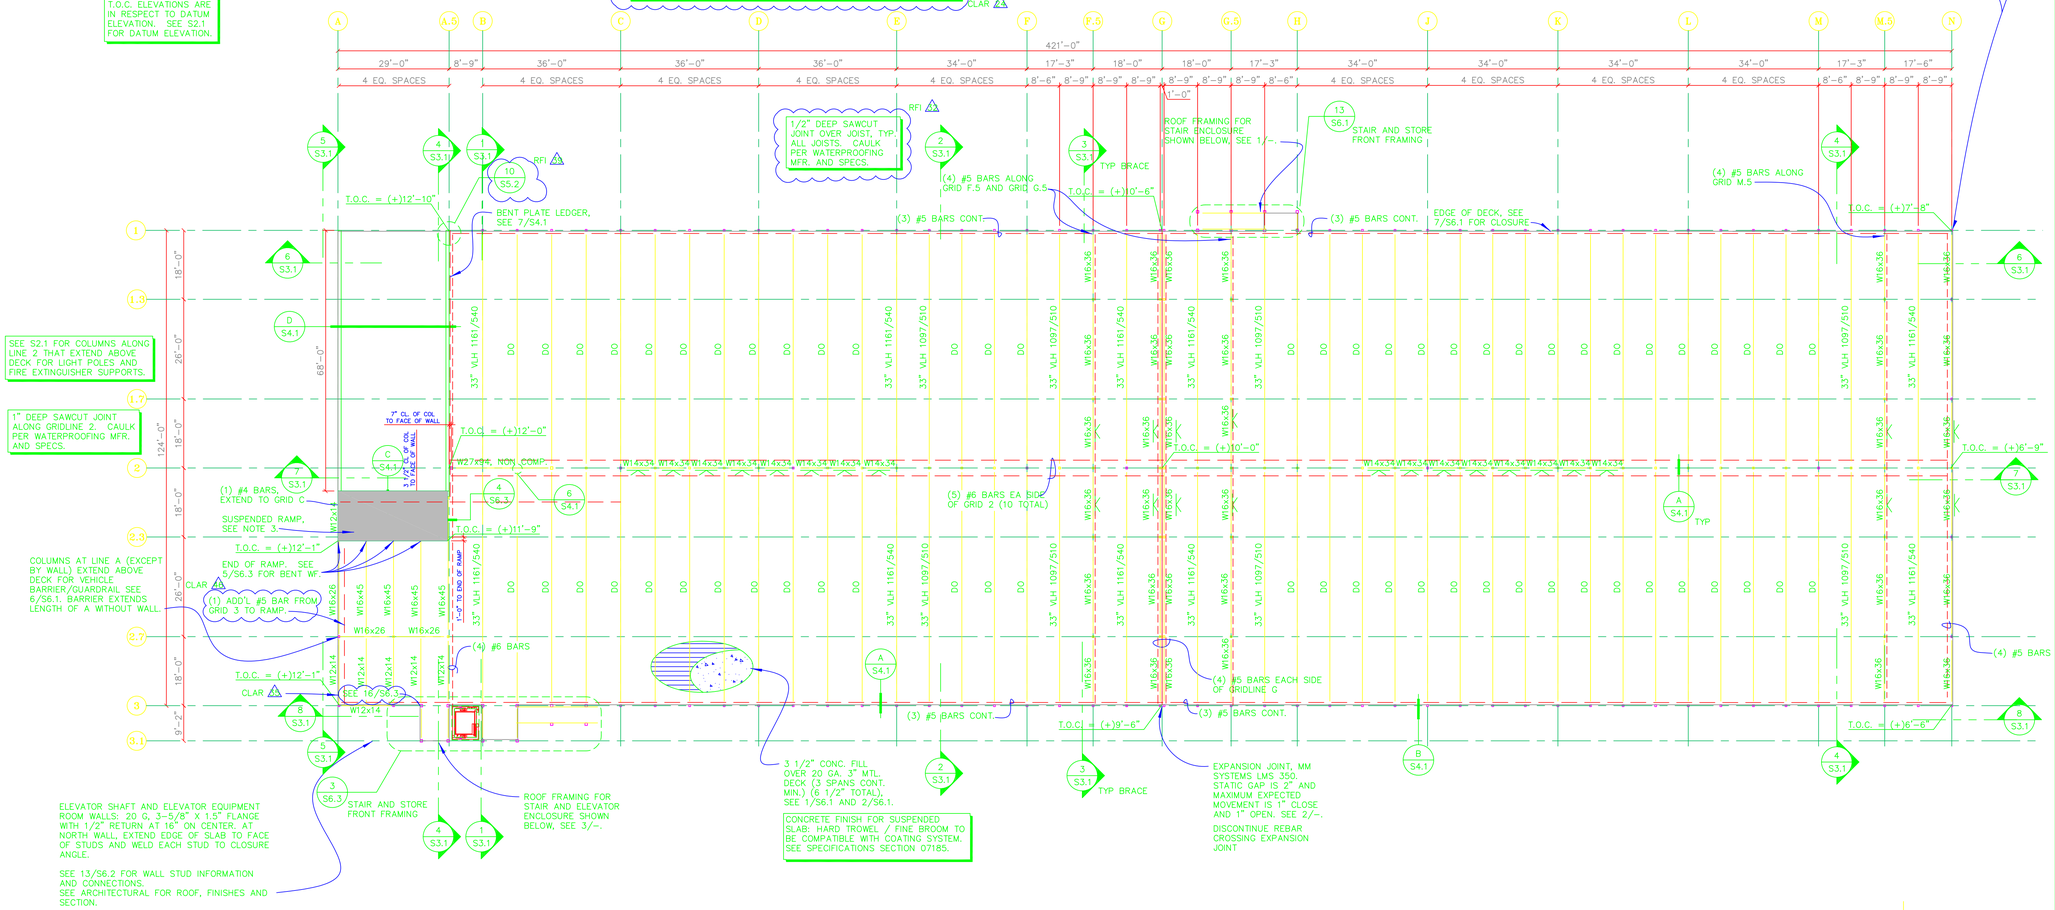



FLOOR ONE FRAMING PLAN

SCALE: 1/16" = 1'-0"

KEYNOTES


KEYPLAN

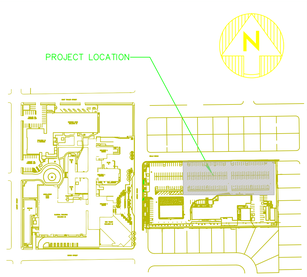

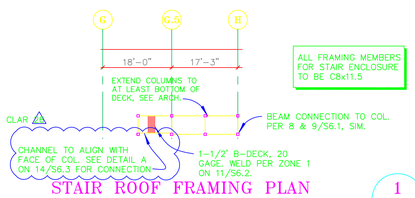


STAIR ROOF FRAMING PLAN 1

SCALE: 1/16" = 1'-0"

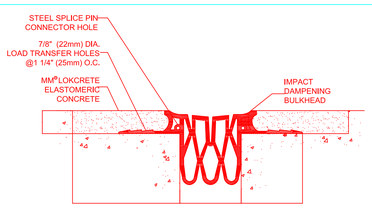

EXPANSION JOINT 2

NOT TO SCALE

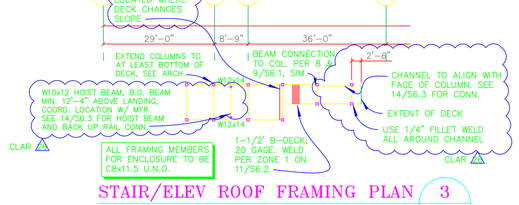

STAIR/ELEV ROOF FRAMING PLAN 3

SCALE: 1/16" = 1'-0"

NORTH

CONTRACT DOCUMENTS ARE THE COPYRIGHT OF BLAKELY JOHNSON & GHUSN, INC. AND MAY NOT BE USED ON ANY OTHER PROJECT WITHOUT THE WRITTEN AUTHORIZATION OF BLAKELY JOHNSON & GHUSN, INC. © 2005

Revisions	Date

J:\Cdr\2004\20040260\Drawings\presentation\SULLIVAN.jpg

SULLIVAN CONSULTING GROUP
409 CAMINO DEL RIO SOUTH, SUITE 204
SAN DIEGO, CALIFORNIA 92108

Blakely Johnson & Ghusn, Inc.
Architecture & Engineering
6995 Sierra Center Pkwy, Ste 200
Reno, NV 89511 (775) 827-1010
fax: (775) 827-1663 www.bjginc.com

ISSUED FOR AS-BUILT

Approved For: Construction ☐ Submittal ☐

Name	Initials	Date
Director		
Assoc. Dir.		
Ch. of Staff		
Ch. of Eng.		
QC Chk	M.D.B.	2/11/05

Drawing Title: FLOOR ONE FRAMING PLAN

Approved: Area Project Manager

Project Title: VA PARKING GARAGE

Building Number: BUILDING 13 | Checked: G.E.G. | Drawn:

Location: DEPT. OF VETERANS AFFAIRS MEDICAL CENTER 1000 LOCUST ST., RENO, NEVADA

Date: 9/08/2006

Project No.: 654-308

DRAWING NO.: 13-S2.2

Dwg. of

Office of Facilities

Department of Veterans Affairs

one-eighth inch = one foot 1/16"=1'-0" | one-quarter inch = one foot | three-eighths inch = one foot | one-half inch = one foot | one inch = one inch | one and one-half inches = one foot

20040260_S22.DWG VA PARKING GARAGE 20040260